

State of Wisconsin
DEPARTMENT OF NATURAL RESOURCES
101 S. Webster Street
Box 7921
Madison WI 53707-7921

Scott Walker, Governor
Daniel L. Meyer, Secretary
Telephone 608-266-2621
Toll Free 1-888-936-7463
TTY Access via relay - 711



October 2, 2017

Mr. Bruce F. and Mrs. Janet E. Davis
Rt. 2, Box 324
Turtle Lake, WI 54889

SUBJECT: Affidavit of Correction for Soil Deed Notice of Contamination
Davis Auto Body, 200 USH 8 & 63, Turtle Lake
DNR BRRTS # 03-03-000273 PECFA # 54889-9999-12

Dear Mr. and Mrs. Davis,

The purpose of this letter is to provide an "Affidavit of Correction" for the previously recorded Soil Deed Notice of Contamination for your property. Please review and sign (keep a copy for yourself) and return it to my attention. The Department of Natural Resources will pay the \$30 recording fee to record it with the Barron County Register of Deeds - upon receipt of the signed "Affidavit of Correction." Please provide this information within sixty (60) days.

Thank you for your efforts to protect Wisconsin's environment. If you have any questions, please contact me in writing at the letterhead address or via e-mail at Ralph.Smith@wisconsin.gov or by telephone at (608) 261-6543.

Sincerely,

A handwritten signature in blue ink that reads 'Ralph N. Smith'.

Ralph N. Smith
Hydrogeologist
Remediation and Redevelopment Program

Encl. Affidavit of Correction and Vertical Cross-Section Map - Figure 3

Cc: Case File

AFFIDAVIT OF CORRECTION

In Re: Part of the Southeast Quarter of the Southwest Quarter of Section 30, Township 34 North, Range 14 West (in the Village of Turtle Lake) described as: Beginning at a point 396 feet North and 183 feet West of quarter post of Section 30 and 31; thence North 656 feet to place of beginning; thence North 97 feet; thence Northeasterly 179.9 feet; thence South 200 feet; thence West 150 feet to the place of beginning.

STATE OF WISCONSIN)
) ss
COUNTY OF BARRON

Bruce F. Davis and Janet E. Davis, being first duly sworn, on oath depose and say:

Name and Return Address

Bruce F. and Janet E. Davis
Rt. 2, Box 324
Turtle Lake, WI 54889

- 1. That he and she are the owners of the above-described property.
- 2. That approval has been given by the successor agency, the Wisconsin Department of Natural Resources, for the closure of an environmental contamination case involving the above-described property on the condition that a notification of the existence of residual petroleum contamination on the property is recorded at the Office of the Register of Deeds in the county where the above-described property is located. 186-8023-39-000 Parcel Identification Number (PIN)
- 3. That this corrected affidavit is being recorded to correct and replace the previous deed (Volume 1048, Page 456, Document # 675593) recorded on 05-27-2003 with the Barron County Register of Deeds for the purpose of notifying prospective purchasers and other interested parties that soil contaminated with petroleum from a underground storage tank leak remains on this property in the following location:


On the North side of the former tank cavity at 7 to 9 feet below ground surface (see attachment). If this contaminated soil is excavated in the future, the soil must be sampled and analyzed, and may be considered solid or hazardous waste, and will need to be disposed in accordance with applicable statutes and rules.

Bruce F. Davis Janet E. Davis

Subscribed and sworn to before me
this ____ day of _____, 20__.

Notary Public, State of _____
My commission _____

This document was drafted by the Wisconsin Department of Natural Resources.

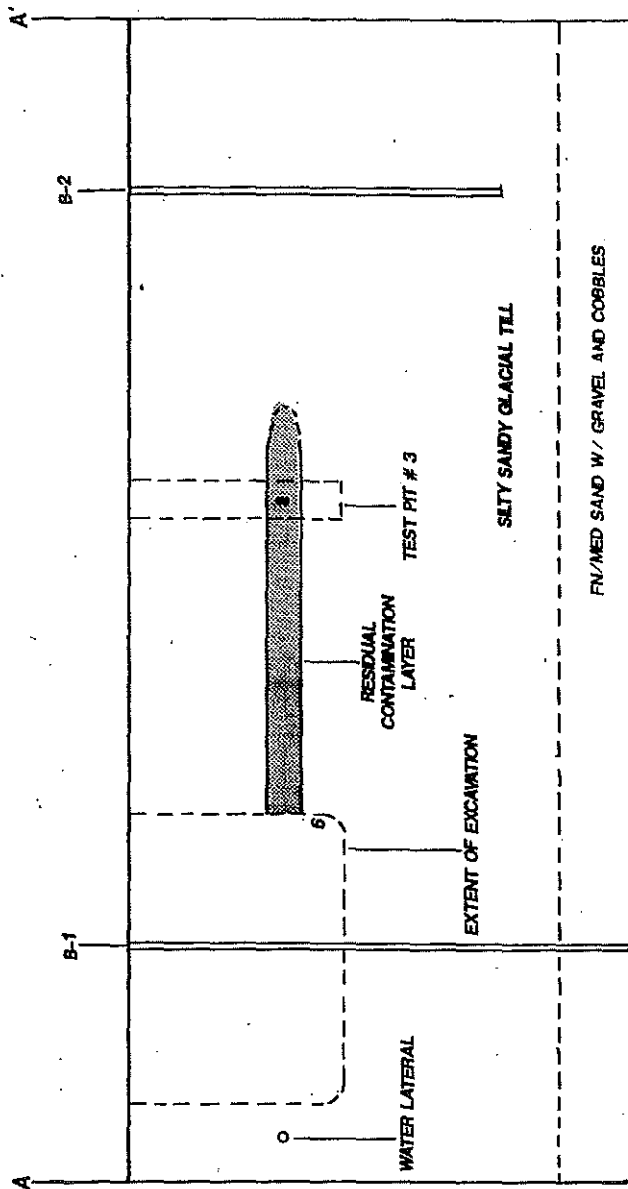


 = RESIDUAL CONTAMINATION LAYER

1" = 10'

VERTICAL CROSS SECTION MAP

FIGURE 3