

## **Supplemental Site Investigation Report**

Appleton Wire  
Former Albany International  
Chrome Plant  
908 North Lawe Street  
Appleton, Wisconsin  
WDNR ERP# 02-45-000015

Prepared for the  
WISCONSIN DEPARTMENT OF NATURAL RESOURCES

June 25, 2016

Ms. Jennifer Borski, Hydrogeologist  
Remediation and Redevelopment (RR) Program  
Wisconsin Department of Natural Resources  
625 E County Road Y, Suite 700  
Oshkosh WI 54901

Subject: Supplemental Site Investigation Report  
Appleton Wire Former Albany International Chrome Plant  
908 North Lawe Street  
Appleton, Wisconsin  
WDNR ERP# 02-45-000015

Dear Ms. Borski:

On behalf of Albany International, Badger Laboratories and Engineering, Inc. (BL&E) provides a report of Supplemental Site Investigation activities conducted at the above referenced site on May 12 and 13, 2014.

## **1. Project Background**

The Appleton Wire-Former Albany International Chrome Plant has been the site of groundwater remediation since the mid-1980s.

The Appleton Wire-Former Albany International Chrome Plant, located at 908 North Lawe, Appleton, Wisconsin, was utilized as a chrome plating facility from 1963 to 1982. Woven wire fabric, used to distribute pulp onto paper machines, was chrome plated to enhance its durability. This chroming process was conducted in a building located at the rear of the present Luvata of Appleton LLC manufacturing facility. There is only limited information on exactly where and how this process actually took place. The chrome plant building and a parking lot north of the building were sold to Valley Cast in 1984. Valley Cast became a fully owned subsidiary of Outokumpu in 1985. The facility name was changed to in 2001.

In 2006, Outokumpu was sold and the facility currently operates under the name Luvata Appleton LLC. The address of the former Valley Cast portion of the site is 908 North Lawe Street. The loading dock area near the chrome plating area was referred to as 831 North Meade Street. An office building and parking lot south of the former chrome plant were sold to Appleton Papers (now Appvion) between 1985 and 1990. The address of the Appvion office building is 714 East Hancock Street.

Historically, reporting related to the release of Chromium on the site has been referenced under the Meade Street, Hancock Street and Lawe Street addresses. As of June, 2009, the physical address (for reporting purposes) of the former chrome plant site was changed to 908 North Lawe Street. Figure #1 shows the approximate property boundaries on a site map. An aerial photograph of the site delineating current property ownership is shown in Figure #6. The former chrome plating building now serves as a warehouse for material and equipment used to support the current Luvata operations. *Documents related to the ownership of the site, including historic plat maps, survey information and property deeds are provided in this report as attachments.*

*All Boring, Well Construction and Abandonment forms use a local grid origin located at the southeast corner of the warehouse. Each boring location is referenced to this origin location. The grid origin has the WTM coordinates of: X=648,084.9334 meters Y=423,031.1259 meters. Its Degree/Minute/Second Lat/Lon Coordinates are: 44°16'9.3"N /88°43'23" W*

In 1985, Valley Cast employees noted colored groundwater collecting in the basement of the building. Subsequent tests indicated concentrations of Chromium in the collected groundwater.

The small basement area is located at the southeast corner of the building. The remainder of the building is slab-on-grade construction with a 6" to 7" concrete floor.

STS Consultants, Inc. conducted an investigation of the former chrome plant site on January 19, 1987. The purpose of the investigation was to determine the horizontal and vertical extent of the chromium contamination and to evaluate the effectiveness of the facility's basement sump to collect contaminated groundwater from the north and south sides of the building.

The results of the investigation indicated that the Chromium contamination appeared limited to areas along the northeast and southeast ends of the building and to a depth of approximately 15-feet below grade. The existing basement sump was found to be adequate for collection of groundwater along the south end of the building. The consultant proposed installation of a collection system along the north side of the building to improve groundwater collection.

In 1988, a chemical precipitation process was installed to treat the groundwater collecting in the facility basement sump. The system was operated until 1998, when it was replaced by an ion exchange treatment system.

In 1992, a groundwater collection system was installed along the north side of the building. The system consists of approximately 110 feet of perforated piping, placed 14 feet below grade. The piping empties into a manhole, located at the northeast corner of the facility. Collected groundwater is pumped from the manhole to two storage tanks, located in the basement of the facility. Groundwater flowing to the basement sump is also pumped to the storage tanks.

A total of 16 groundwater monitoring wells exist on the former chrome plant property to monitor the subsurface chromium contamination. Additionally, the groundwater collection system (French Drain) and basement sump are monitored to track the effectiveness of the treatment system.

In 2003, eleven Geoprobe™ borings and temporary monitoring wells were installed in and around the two known source areas in an attempt to better define the vertical and horizontal extent of the Chromium contamination. Periodic sampling was conducted from the temporary monitoring wells until their abandonment in April, 2008. The locations of these devices are shown on Figures # 2,3, and 4

In 2009, Albany International met with WDNR to discuss the status of site impacts delineation and site remediation progress. Subsequent to that meeting, on June 30, 2009, groundwater monitoring wells MW-19 and MW-19A were constructed in the warehouse portion of the Luvata facility, some 80-feet west of the basement. MW-19 was constructed to a depth of 20 feet below the facility floor. MW-19A was constructed to a depth of approximately 40 feet below the facility floor. Device locations are shown on Figures #1-4.

After several rounds of sampling of MW-19 and MW-19A, it became apparent that Chromium contamination of the groundwater in these wells was significant and that Chromium contamination is present to the west of the former plating area and under the current Luvata Appleton warehouse building.

## **2. Supplemental Site Investigation Activities**

In 2014, BL&E met with Albany International to discuss potential enhancements to the groundwater collection and treatment system. Possible enhancements envisioned included the construction of a drainage trench network beneath the floor of the warehouse, and an additional sump to convey water to the treatment system. This meeting resulted in the decision to conduct an additional investigation of the soil conditions below the warehouse floor with a series of additional push probe soil samples. Two groundwater monitoring wells in the north 1/2 of the floor area, and two groundwater monitoring well to the west of the warehouse area in the Luvata manufacturing area were also planned.

As part of additional site investigation process, Albany International staff completed a comprehensive research effort to find and review any historic documentation of the building's construction. This research did not yield any documents showing the building's construction or details of its sewers, sumps, walls or foundations.

Between May 12, 2014, and May 14, 2014, nine Geoprobe™ borings were placed in the interior of the former chrome plant building and two Geoprobe™ borings were placed in the current Luvata Appleton production area to further delineate the extent of the subsurface Chromium contamination. As part of the investigation, Monitoring Well MW-20 and Piezometer MW-20A were installed in the former warehouse area. Monitoring well MW-21 and Piezometer MW-21A were installed in the Luvata production area. The Geoprobe™ and monitoring well locations are shown on Figure #1.

The May 2014, investigation indicated that significant subsurface Chromium contamination is present in the northeastern portion of the Luvata Appleton warehouse area. Several former employees were interviewed regarding these findings and it was discovered that there had been a second plating operation to the north of the main chrome plating line. Groundwater samples

collected from monitoring wells MW-20 and MW-20A, in the area of this second plating line, yield high levels of total Chromium. Groundwater sampling conducted in the Luvata production area at Monitoring wells MW-21 and MW-21A, recorded little to no total Chromium. With the data provided by the addition of the 4 monitoring wells in 2014, the extent of the Chromium contamination has been confirmed to lie under the warehouse building.

### **3. Investigation Actions**

The additional investigation consisted of the construction of numerous soil borings identified as GP-1 through GP-13, (some equipped with temporary groundwater monitoring wells) and two groups of two additional NR-141 compliant groundwater monitoring wells. One group (MW-20 and MW-20A) are in the warehouse building. The other group of two groundwater monitoring wells (MW-21 and MW-21A) were constructed in Luvata of Appleton LLC's manufacturing facility, which is located beyond the perimeter of the warehouse building walls. The locations of these devices are shown on Figure #1 of this report. The wells shown in the Luvata of Appleton LLC's manufacturing facility are located about 20-feet west of the warehouse building. The location of these wells in the manufacturing area was dictated and limited by Luvata's equipment and process space requirements, safety concerns while drilling, and restricted access to other areas based on material handling equipment movements and disruptions to the manufacturing process.

The new monitoring wells are similar to the existing MW-19 and MW-19A in that one of the wells in each group (MW-20 & MW-21) are shallow water table wells (approximately 20-feet deep), while the other to (designated MW-20A and MW-21A) are deeper piezometers (35-feet deep). The shallow wells were constructed with 10-foot long screens, and the two deep wells were constructed with 5-foot long screens

Soil borings #11 was installed on the west side of the basement's west wall, while soil boring #12 (shown on Figure #1) was installed on the east side of the basement's west wall. This was done to determine whether there are any significant differences in soil type (fill near the walls) or soil contamination outside of the basement area vs under it. A second boring beneath the level of the basement floor elevation, (shown as boring #13 on Figure #1) was constructed to compare soil conditions on the east side of the basement floor area with those found in borings #11 and #12

The remaining soil borings were arranged across the warehouse in an attempt to gather additional data about the potential variability of soil types, depths, and impacts from Hexavalent Chromium use in the building.

Following construction and development of the monitoring wells, the groundwater was sampled for total and Hexavalent Chromium.

#### **4. Soil Boring and Sampling**

##### **Soil Sampling**

A compact, tracked (Geoprobe™) rig was be used obtain 2-inch diameter soil samples to depths ranging from 10-feet to 20-feet below the level of the warehouse floor. This represents a depth of sampling of approximately 2-feet above to 8-feet below the level of the basement floor surface. Soil sampling was also conducted in advance of the drilling of the monitoring wells, to the total depth of the bottom of the well boreholes.

Samples were collected in clear plastic 60-inch long , 2-inch diameter plastic sample sleeves inside the sampling rods. The plastic sleeves were sliced open to examine and describe the sample retained in them. Samples were collected and placed in pre-weighed glass jars and transported on ice to the laboratory for analysis.

Table 1 in this report contains a summary of the lab results from these samples.

Figures #2, #3, and #4 provide information on the concentrations of Chrome found in the soil samples from the 0-5', 5-10' and 10-20' respectively. Figure #5 is a cross section of the building looking from South to North at the borings and wells to illustrate their relative depth in relation to the floor and the basement.

Complete laboratory analysis reports and their Chain-of Custody forms are also provide for all of the samples analyzed.

Soil samples were analyzed for Total Chromium analysis by Method SM3111B and Hexavalent Chromium analysis by Method SM3500Cr.

Soil Boring Logs (Form 4400-122) for the probes are provided in this report. When completed and no longer needed for additional sampling, the bore holes were abandoned and the concrete floor was repaired. Boring abandonment forms (Form 3300-005) documenting this activity are provided in this report.

Drill cuttings and sample cores from the push sampler are stored on site in closed- top drums awaiting disposal. Soil types are noted on Soil Boring Logs (Form 4400-122).

#### **5. Groundwater Sampling**

Following the completion of the soil sampling, monitoring well boreholes were re-drilled to the same depth as the soil boring for monitoring well construction. A 2-inch diameter, 10-foot long, PVC, well screen and an appropriate length of riser pipe was installed in the shallow wells. The 0.010" slot well screen was placed to intersect the apparent water table. The deeper wells were constructed with a 5-foot long screen extending up from approximately 5-feet above the bottom of the boring. The wells were terminated at floor level protected with a locking removable well plug beneath a

traffic rated, flush mount, access top. Details of well construction are reported on Monitoring Well Construction Forms (Form 4400-113A).

Following construction, the monitoring wells were left undisturbed for approximately 14 days following installation. They were developed using development/purging/sampling methods outlined in the WDNR "Groundwater Sampling Desk Reference" (Publ: DG-037-96). Pre and post development water levels were taken with a Solinst electronic water level meter. Well development activities are recorded on a Monitoring Well Development Form (Form 4400-113B). Well development and purge water was disposed of by running it through the onsite treatment system.

Temporary, 1-inch diameter, monitoring wells were installed in two of the soil borings (GP-7 and GP-13). The borings with the temporary wells were chosen based on soil conditions observed in the push samples. GP-7 was installed near the west wall of the warehouse and Boring GP-13 was installed in the basement.

Groundwater samples were collected and submitted for laboratory analysis for total and Hexavalent Chromium by Methods SM3111B and Method SM3500Cr, respectively. Samples will be tracked on WDNR compliant chain-of-custody forms.

## **6. Observations and Conclusions.**

The subsurface investigation below the floors of the Appleton Wire-Albany International Former Chrome Plant (now the warehouse of Luvata Appleton LLC) revealed the following. The 6" concrete floor is constructed on a thin layer of fill that varies in composition, thickness and locations.

The clay soil underlying the floor of the warehouse is remarkably uniform in all of the borings constructed beneath the warehouse floor with only minor variations in texture or color noted.

The soil encountered under the floor of the basement area (in GP-12, GP-13) and in the soil against the east side of the west wall of the basement (GP-11) all exhibited much more variability. Those borings encountered sand and gravel layers and wood. It was anticipated that the soil against the interior walls and the floor of the basement would reflect the construction of these elements of the building. Chrome concentrations in the soil are highest in the 0-5' depth range in this area. See Figure #2.

Chrome concentrations in soil from 5'-10' below the floor are highest in the area of MW-20 and MW-20A. See Figures #3 & #4. This is the area former employees recalled as being the part of the building where a chroming equipment was located. Chrome concentrations under the remainder of the warehouse floor are much lower, and all concentrations diminish with depth.

Groundwater concentrations of Chromium are highest at MW-20. They are approximately 280 times higher in MW-20 than in the deeper MW-20A, located next to

MW-20. (MW-20 Total Chromium at 388,000 ug/l vs. MW-21A Total Chromium at 1200 ug/l).

Both MW-21 and MW-21A yielded groundwater containing Chromium but at very low levels. Both of these wells produced samples with a Total Chromium concentration of 3 ug/l. This extremely low concentration is likely caused by background levels of Chromium in the soil. According to the WDNR RCL Spreadsheet, the background threshold value for Chromium in Wisconsin soil is 44 mg/kg.

Two Chromium isoconcentration maps showing the extent and severity of the groundwater contamination across the site are provided as Figures #7 and Figure #8. They reflect analytical data from all the wells sample on April 27, 2015, and April 14, 2016 respectively.

Sincerely,  
Badger Laboratories & Engineering, Inc.

A handwritten signature in blue ink that reads "David J. Casper". The signature is fluid and cursive, with the first name being the most prominent.

David J. Casper  
Project Manager


Cc: J.P. Hammerton, Albany International  
File



## HYDROGEOLOGIST CERTIFICATION

---

"I, Mark Love, hereby certify I am a Hydrogeologist as that term is defined in s NR 712.03 (1) Wisconsin Administrative Code; and that to the best of my knowledge, all of the information contained in this document is correct and the document was prepared in compliance with all applicable requirements of chs. NR 700 to 726, Wisconsin Administrative Code."

  
Mark Love, PSS

  
Date

Document Reference: Supplemental Site Investigation Report - June 25, 2016  
Albany International Former Chrome Site, Appleton, WI

## Figures

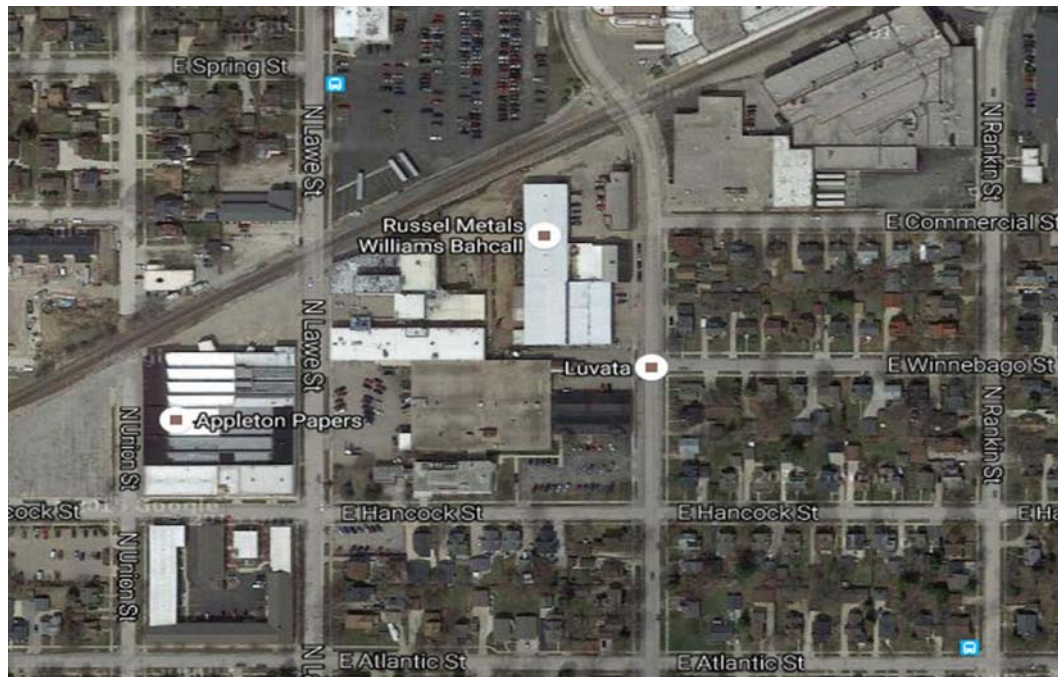
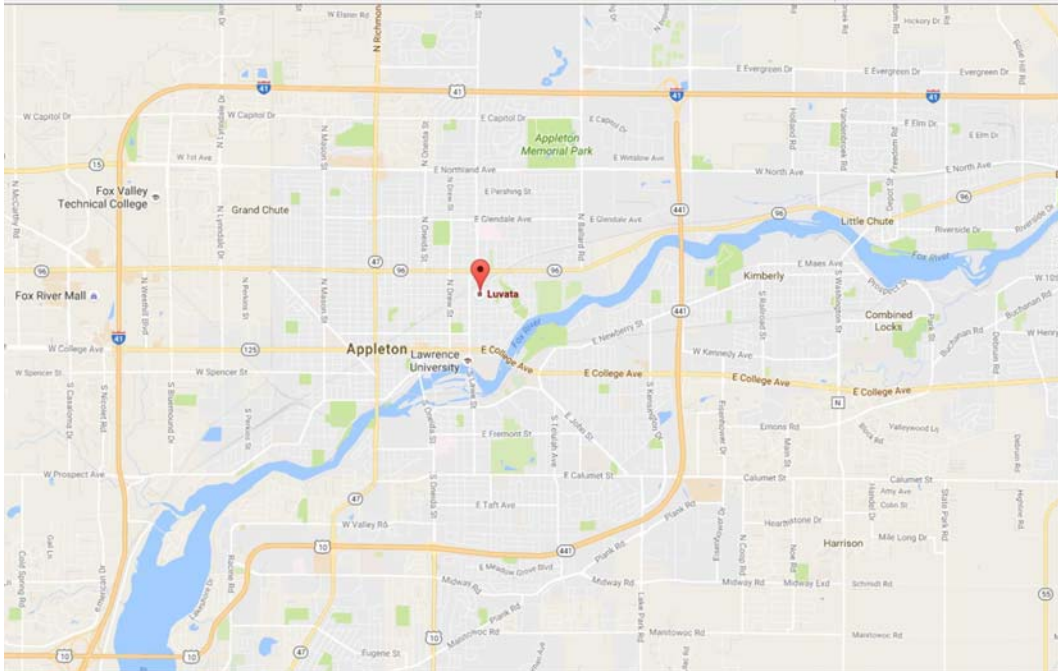


Figure A  
Project Site Location

I BACHALL STEEL & PIPE INC.  
31-0-11146-01  
Zoned M2

PROPERTY LINE (LUVATA APPLETON LLC)  
Parcel #31-1-1145-00  
Zoned M2

FORMER ALBANY  
INTERNATIONAL BUILDING  
(CURRENTLY OCCUPIED BY  
LUVATA-USA

PROPERTY LINE (APPLETON PAPERS INC.)  
Parcel #31-1-1139-00  
Zoned M2

APPLETON PAPERS INC.  
PARKING LOT

MW-18A MW-18 GRASS  
MW-1

HANCOCK STREET

SIDEWALK GRASS

(802)

WINNEBAGO STREET

\* AS OF 8/13/02 THE DESCRIPTION  
FOR MW-05 AND MW-05A WERE  
EXCHANGED

NORTH

LEGEND	
	MW-1 MONITORING WELL
	GMW11 TEMP GEOPROBE MON. WELL



Maria Wierichs  
Revoc Trust  
Parcel # 31-1-1119-00  
(820)

Guy Clark  
Parcel # 31-1-1118-00  
(814)

Gregory Weiss  
Parcel # 31-1-1102-01  
(806)

Nicholas Vandier  
Revoc Trust  
Parcel # 31-1-1102-00  
(802)

MW-10-R

BASEMENT  
GMW05

Basement Sump

GROUNDWATER  
TRANSFER PIPING

French Drain

LOADING DOCK

MW-21  
MW-21A

GP-1

GP-2

GP-3

GP-6

GP-7

GP-8

GP-9

GP-10

GP-11

GP-12

GP-13

MW-19

MW-19A

MW-20

MW-20A

MW-17

MW-17A

MW-2

MW-2A

MW-5\*

MW-5A

GMW01

GMW02

GMW03


GMW04

GMW06

GMW07

GMW10

GMW11

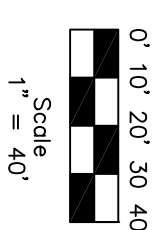

Appletton Wire Former Albany International Chrome Plant Property Limits and Ownership Information	DESIGNED BY DRAWN BY D.J.C. CHECKED BY K.D.C.	This drawing developed from base drawing provided by McMahon Associates Inc. by Badger Laboratories and Engineering Co. Inc.	Badger Laboratories & Engineering Co. Inc. 501 W. Bell St., Neenah WI 54956 TEL: (920) 729-1100 FAX: (920) 729-4945	<table border="1"> <thead> <tr> <th>NO.</th> <th>DATE</th> <th>REVISION</th> </tr> </thead> <tbody> <tr> <td></td> <td>8/20/09</td> <td>Overlay 2005 Aerial Photo</td> </tr> </tbody> </table>	NO.	DATE	REVISION		8/20/09	Overlay 2005 Aerial Photo
	NO.	DATE	REVISION							
	8/20/09	Overlay 2005 Aerial Photo								
SCALE NO SCALE DATE 4/27/09 PROJECT NO. Albany Int. CrO2	FIGURE NO. 1	FILE NO.								



SCALE	NO SCALE	DATE	5/20/14	PROJECT NO.	Albany Int. 002
FIGURE NO.	2				
DESIGNED BY	Appleton Wire				
DRAWN BY	Total Chrome 0-5' Contours May 2014				
CHECKED BY	Engineering Co. Inc.				
KDC	Badger Laboratories Inc. and Molchon Associates Inc. by This drawing developed from base drawing provided by Engineering Co. Inc.				
NO.	DATE	Badger Laboratories & Engineering Co. Inc.			
REVISION	8/20/08	501 W. Bell St., Neenah WI 54956 TEL: (920) 729-1100 FAX: (920) 729-4945			

**LEGEND**

	MW-1	MONITORING WELL
	GMW11	TEMP GEOPROBE MON. WELL

\* AS OF 8/13/02 THE DESCRIPTION FOR MW-05 AND MW-05A WERE EXCHANGED

NORTH

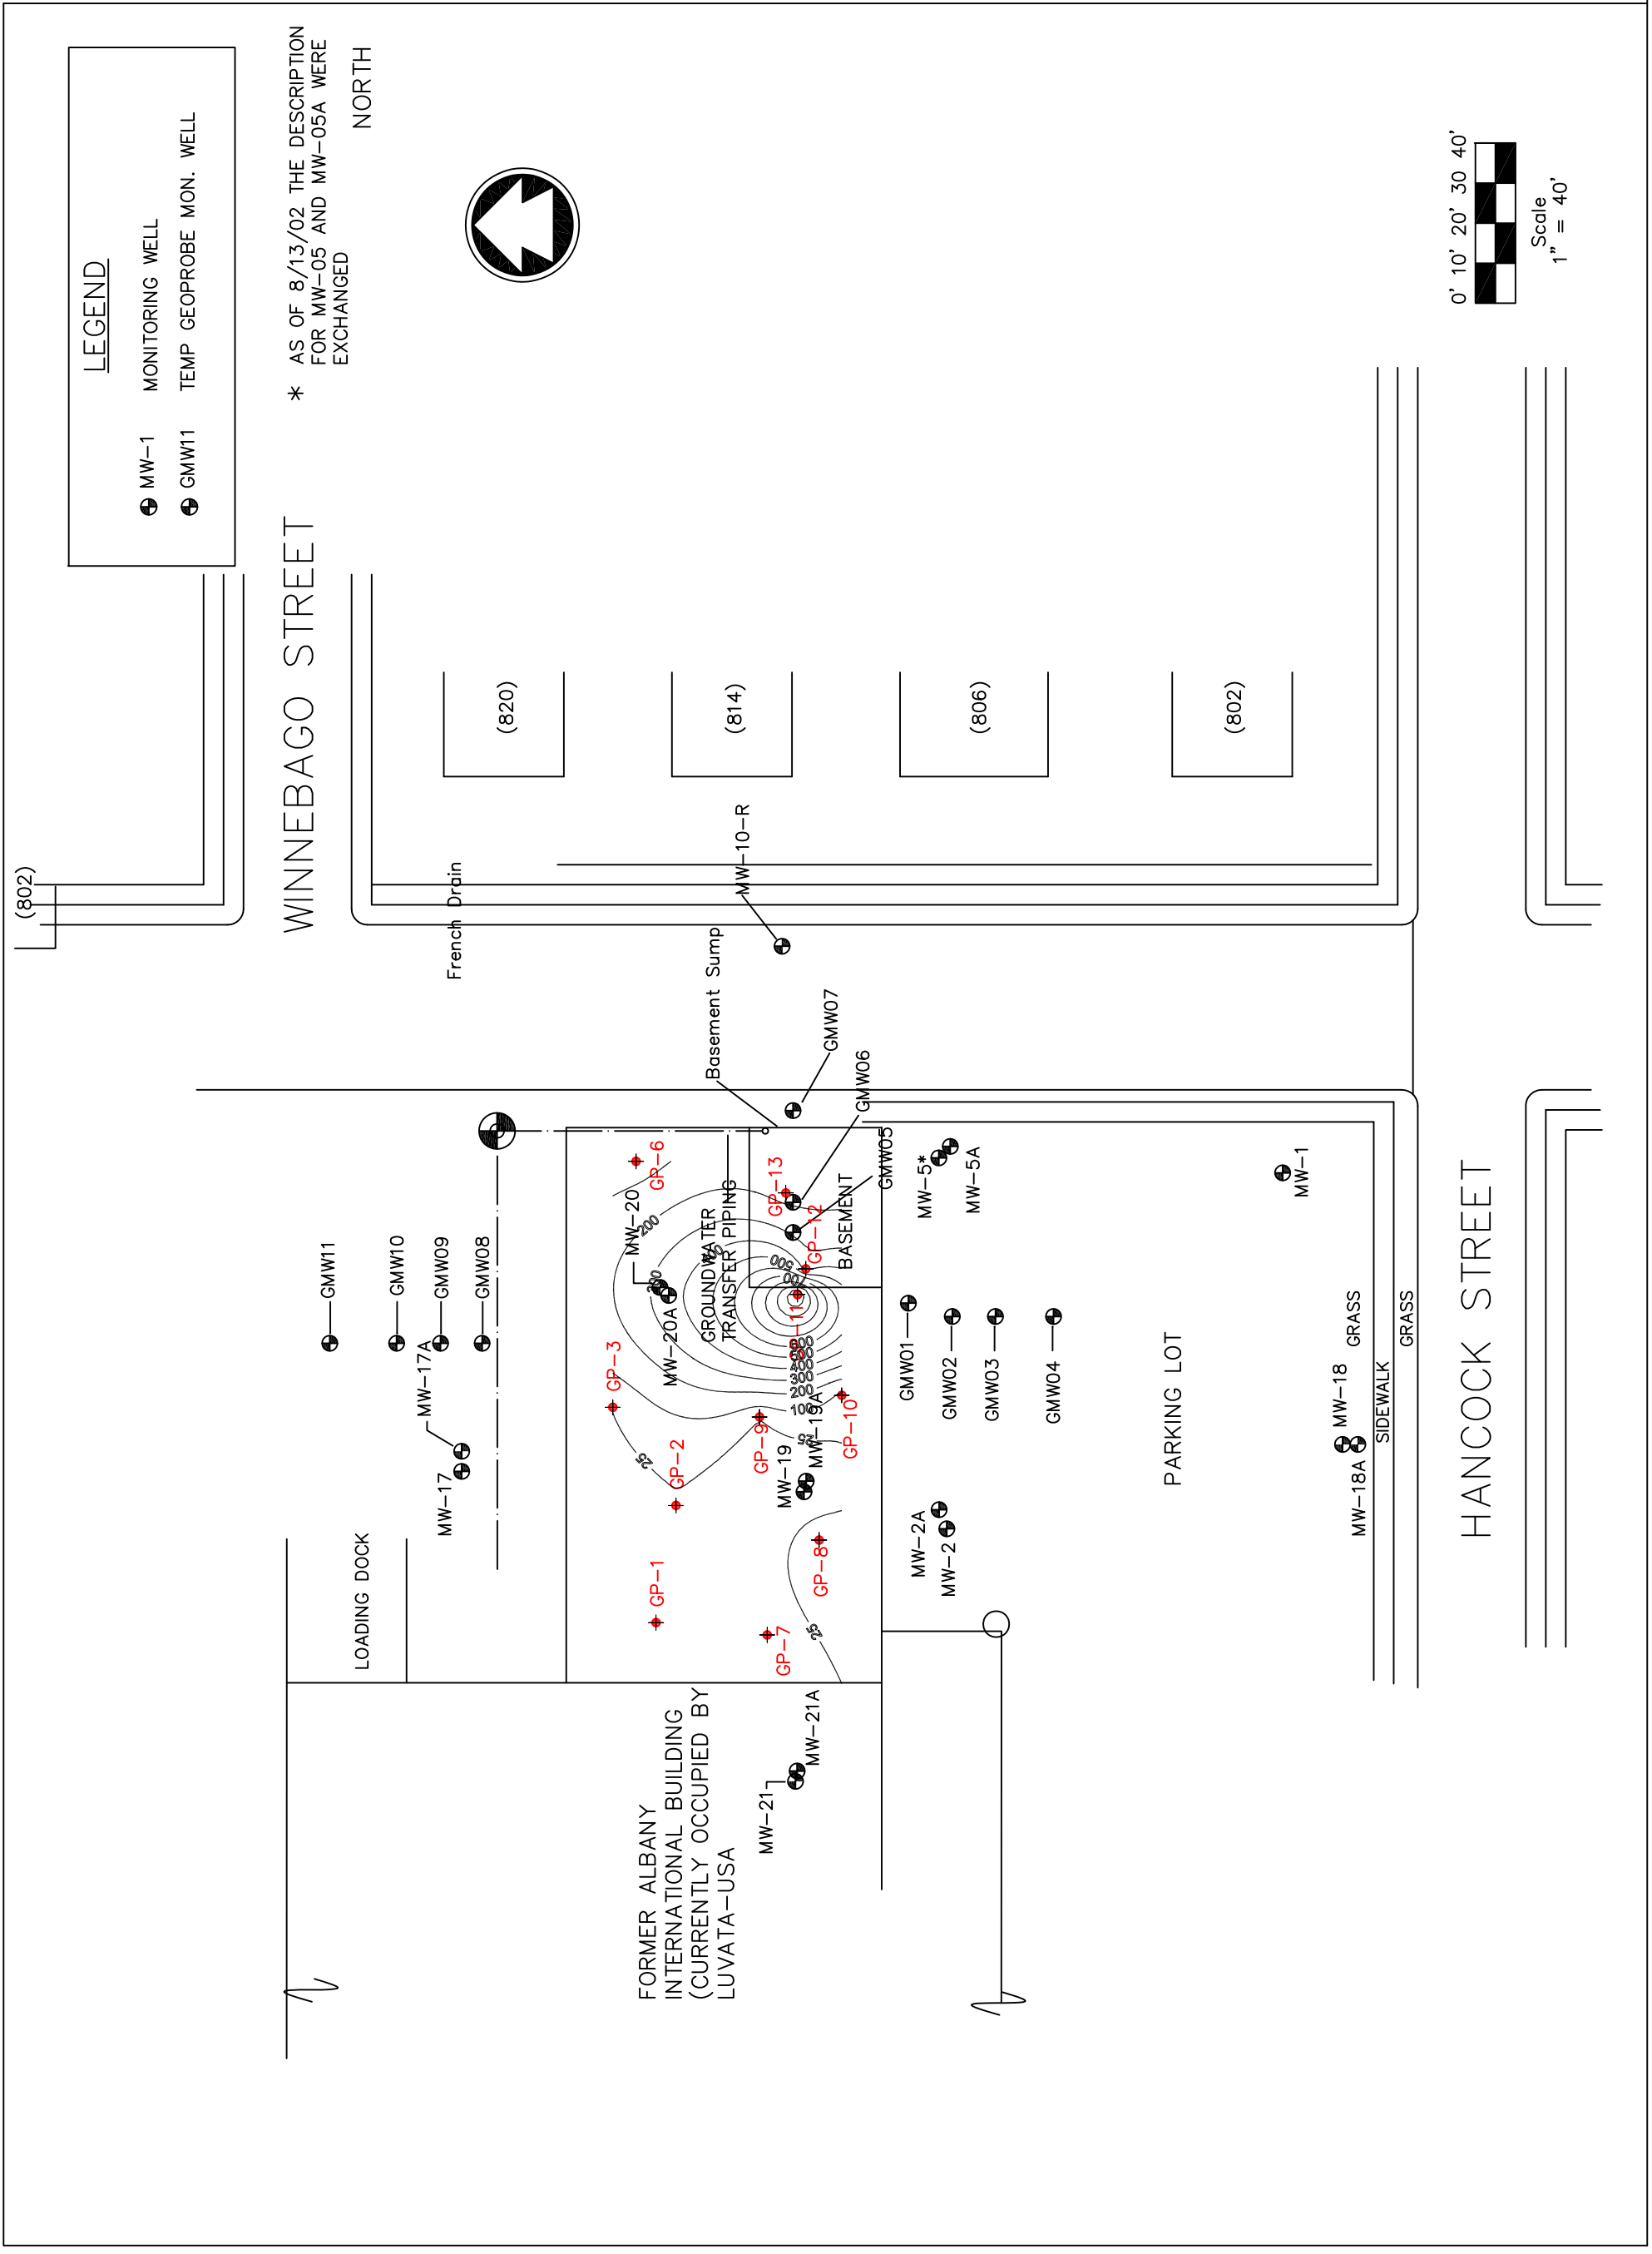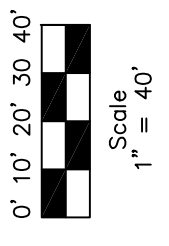

WINNEBAGO STREET

HANCOCK STREET

FORMER ALBANY INTERNATIONAL BUILDING (CURRENTLY OCCUPIED BY LUVATA-USA)

PARKING LOT

LOADING DOCK

GROUNDWATER TRANSFER PIPING

BASEMENT

Basement Sump

French Drain

MW-18A GRASS

SIDEWALK

GRASS

(820)

(814)

(806)

(802)

(802)

MW-21

MW-21A

MW-19

MW-15A

MW-17A

MW-17

MW-20

MW-5\*

MW-5A

MW-6

MW-7

MW-8

MW-9

MW-10

MW-11

MW-12

MW-13

MW-14

MW-15

MW-16

MW-18

MW-18A

MW-1

GMW01

GMW02

GMW03

GMW04

GMW05

GMW06

GMW07

GMW10-R

GMW11

GMW10

GMW09

GMW08

GP-1

GP-2

GP-3

GP-4

GP-5

GP-6

GP-7

GP-8

GP-9


GP-10

GP-11

GP-12

GP-13

SCALE	NO SCALE	DATE	5/20/14	PROJECT NO.	Albany Int. 002
FIGURE NO.	3				
DESIGNED BY	Appleton Wire				
DRAWN BY	Former Albany International Chrome Plant				
CHECKED BY	Total Chrome in Soil 5'-10' Contours May 2014				
KDC	This drawing developed from base drawing provided by Mochon Associates Inc. by Badger Laboratories and Engineering Co. Inc.				
NO.	DATE	REVISION			
1	8/20/08	Overlay 2005 Aerial Photo			
2					
3					
4					
5					
6					
7					
8					
9					
10					

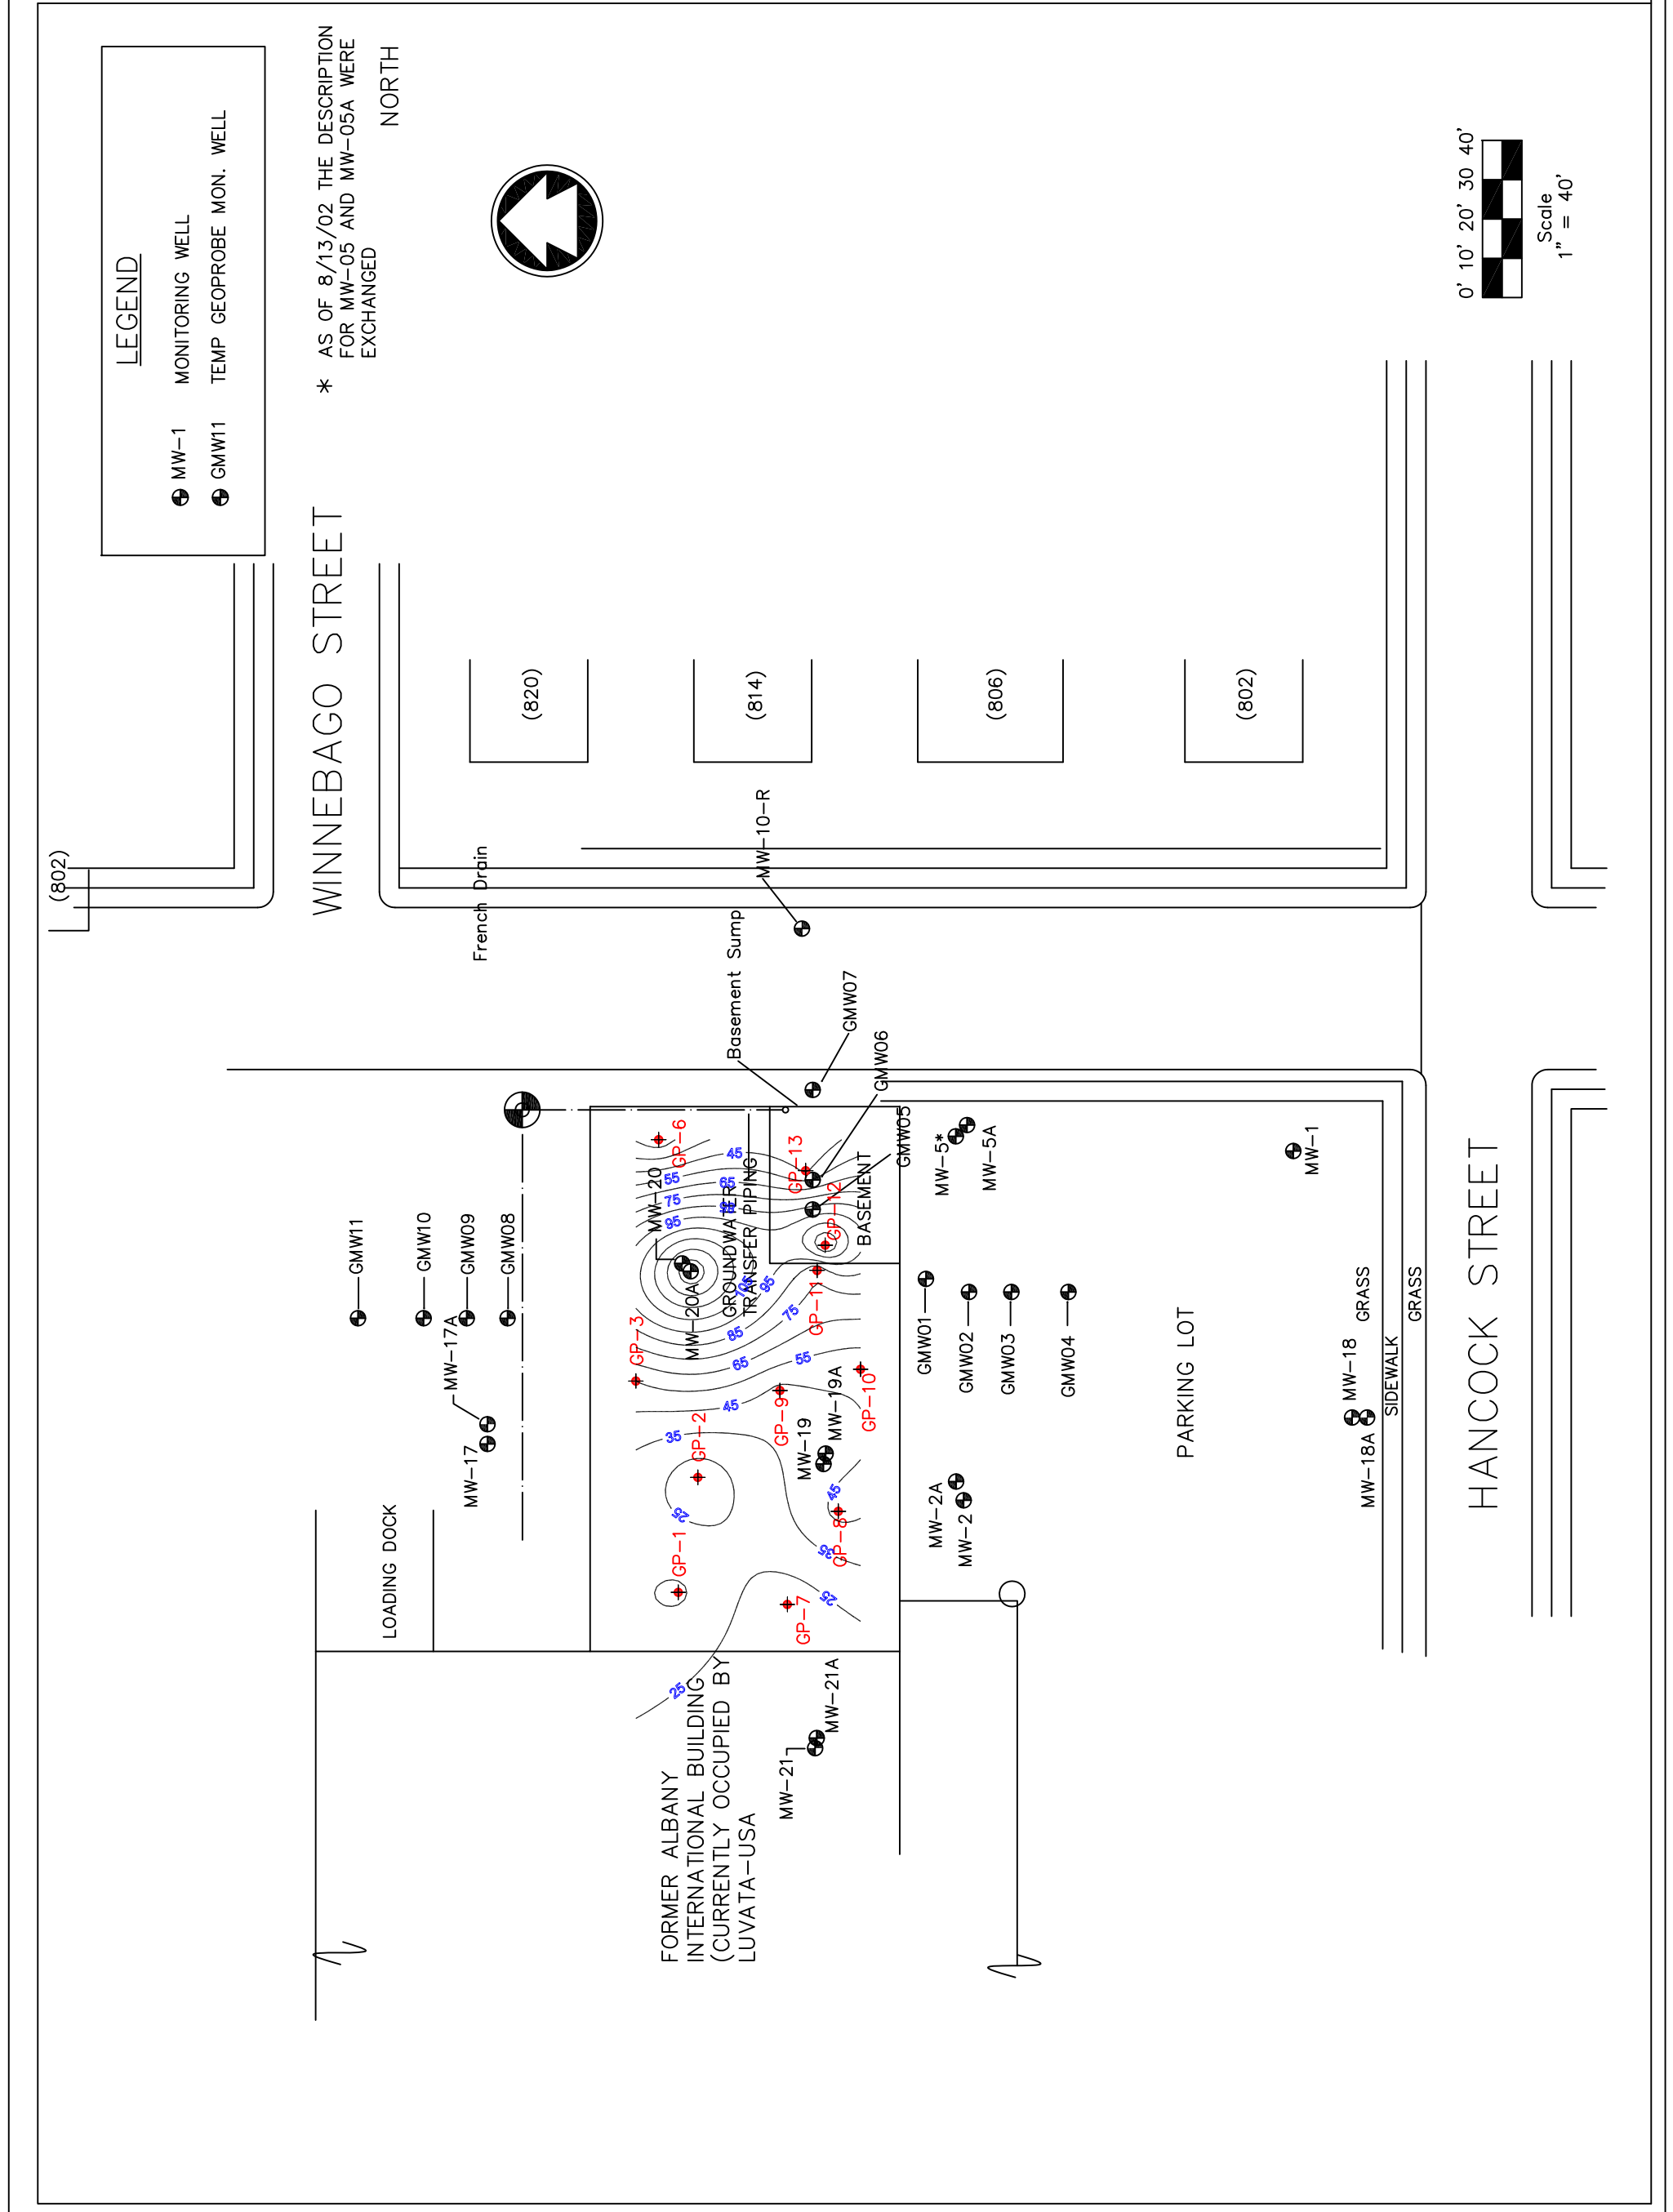

**LEGEND**

- ⊕ MW-1 MONITORING WELL
- ⊕ GMW11 TEMP GEOPROBE MON. WELL



\* AS OF 8/13/02 THE DESCRIPTION FOR MW-05 AND MW-05A WERE EXCHANGED



0' 10' 20' 30' 40'

Scale  
1" = 40'

FILE NO.	
----------	--

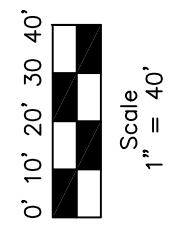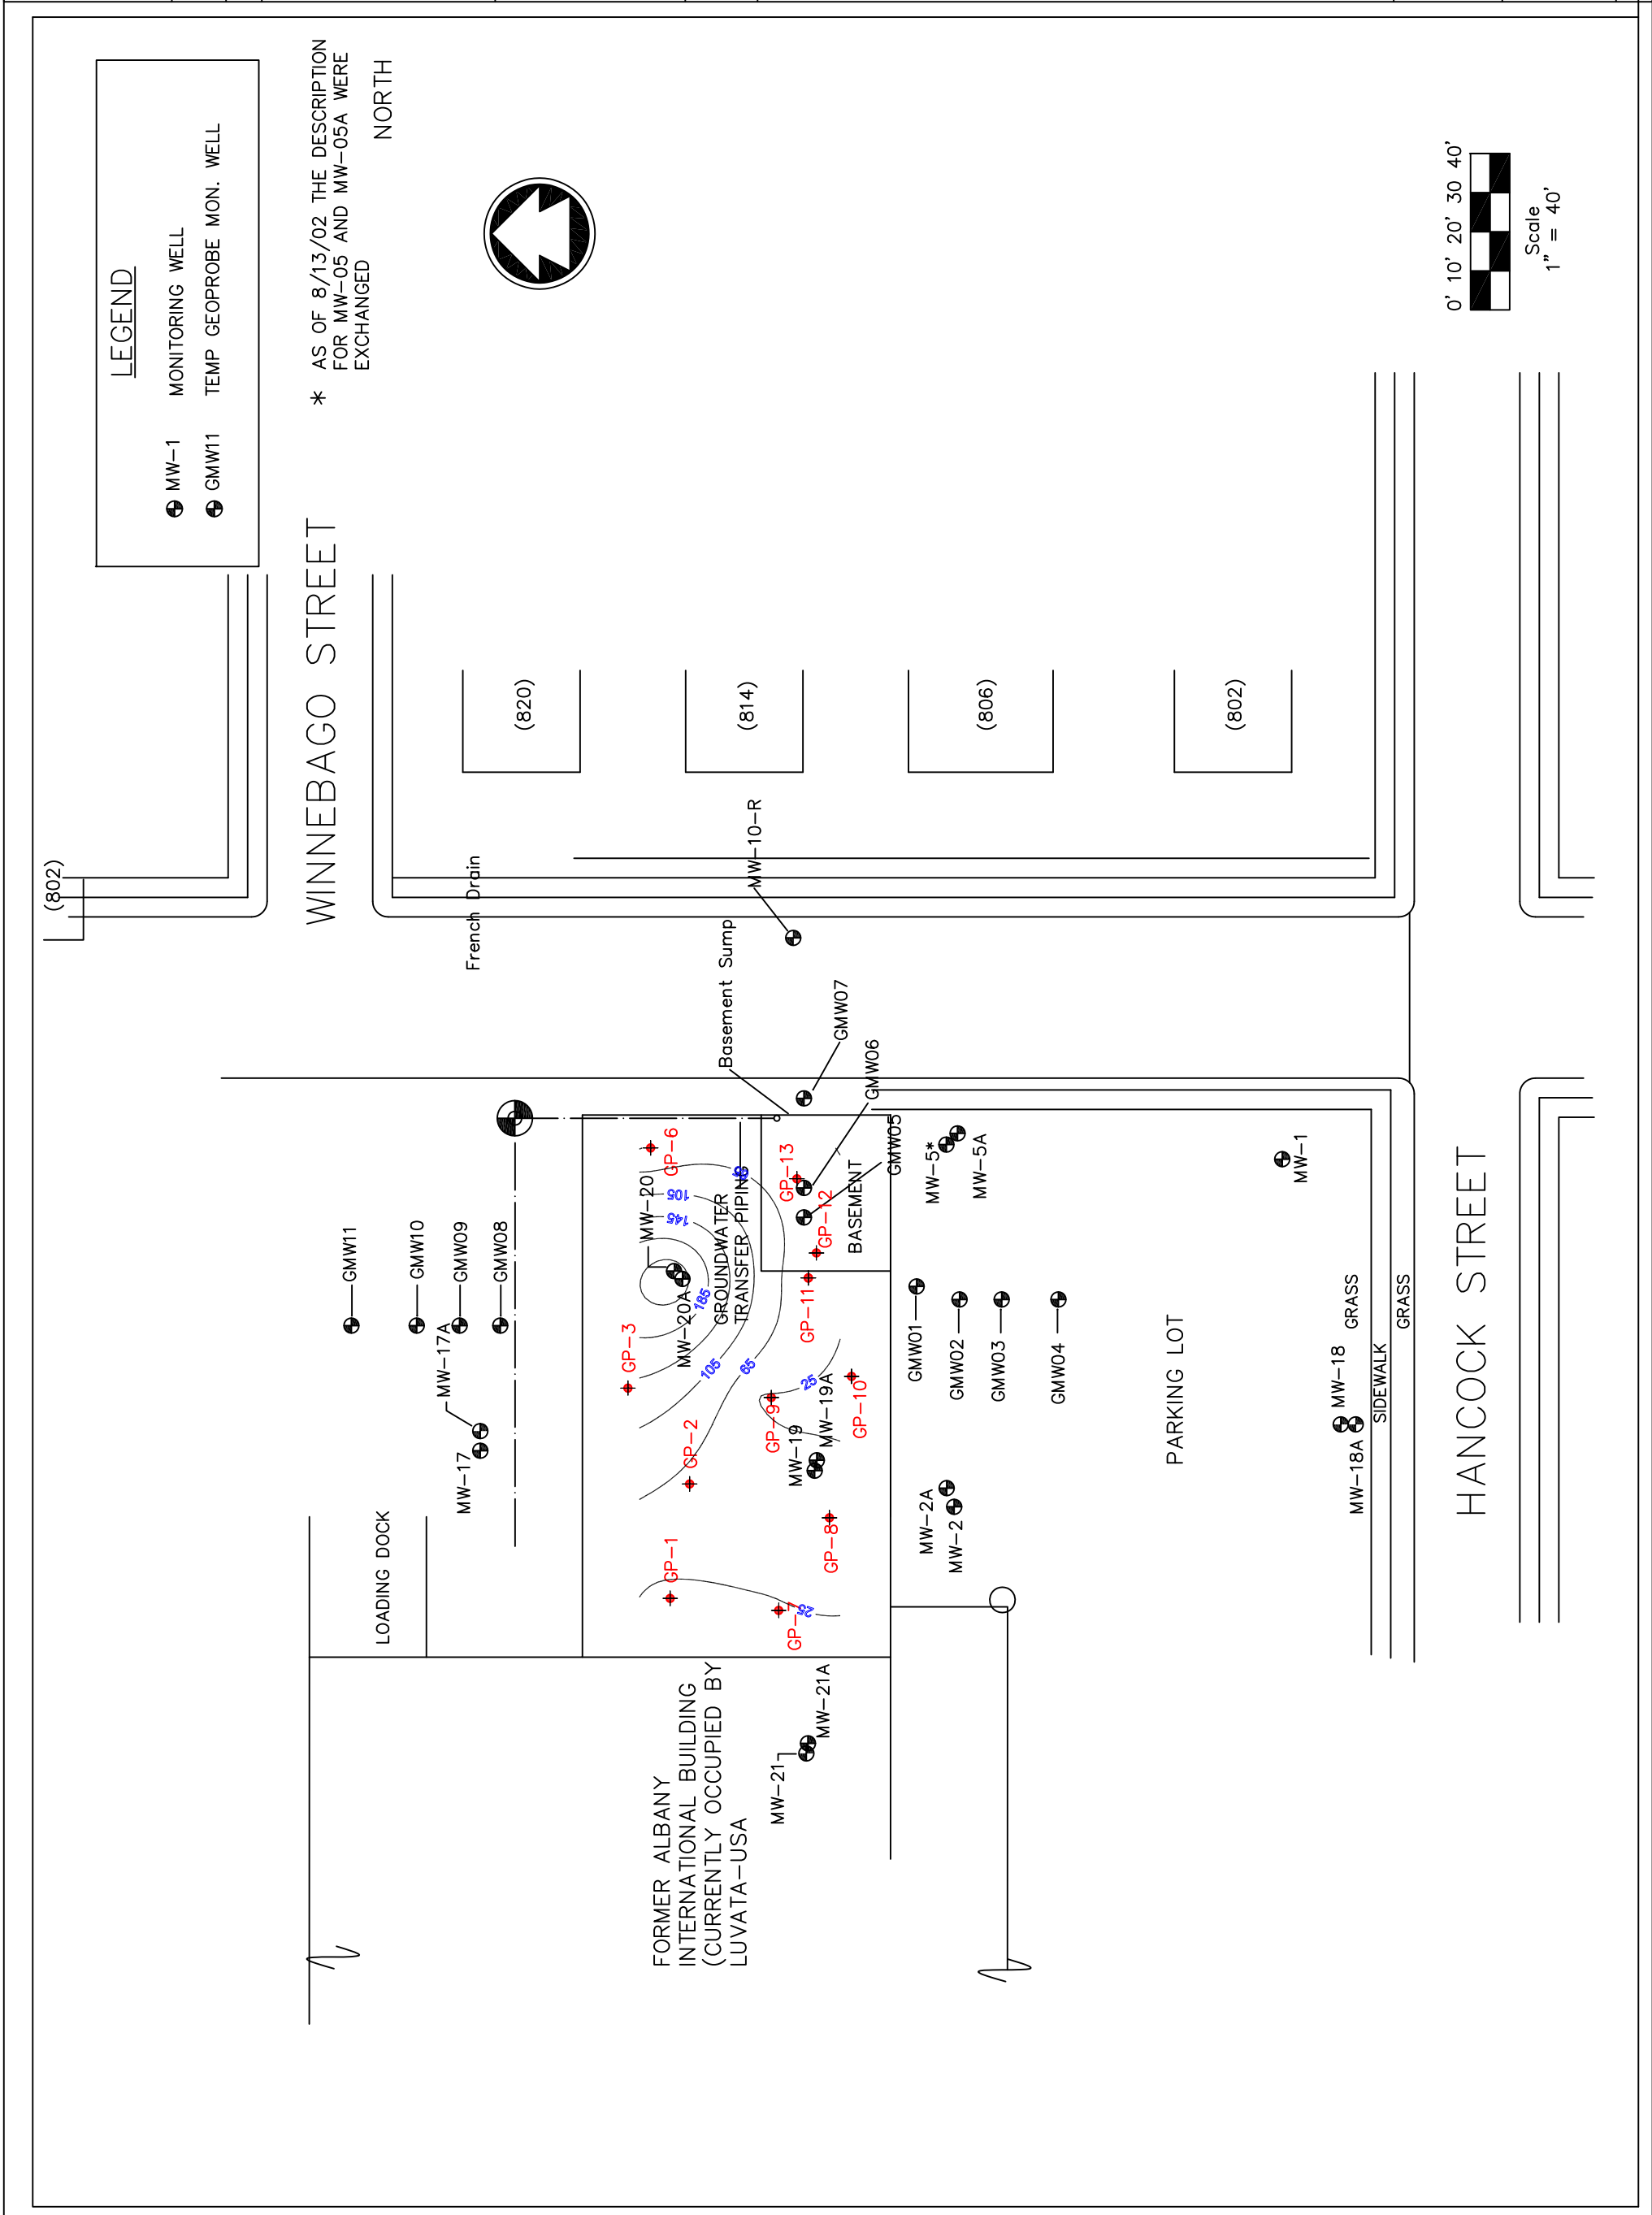

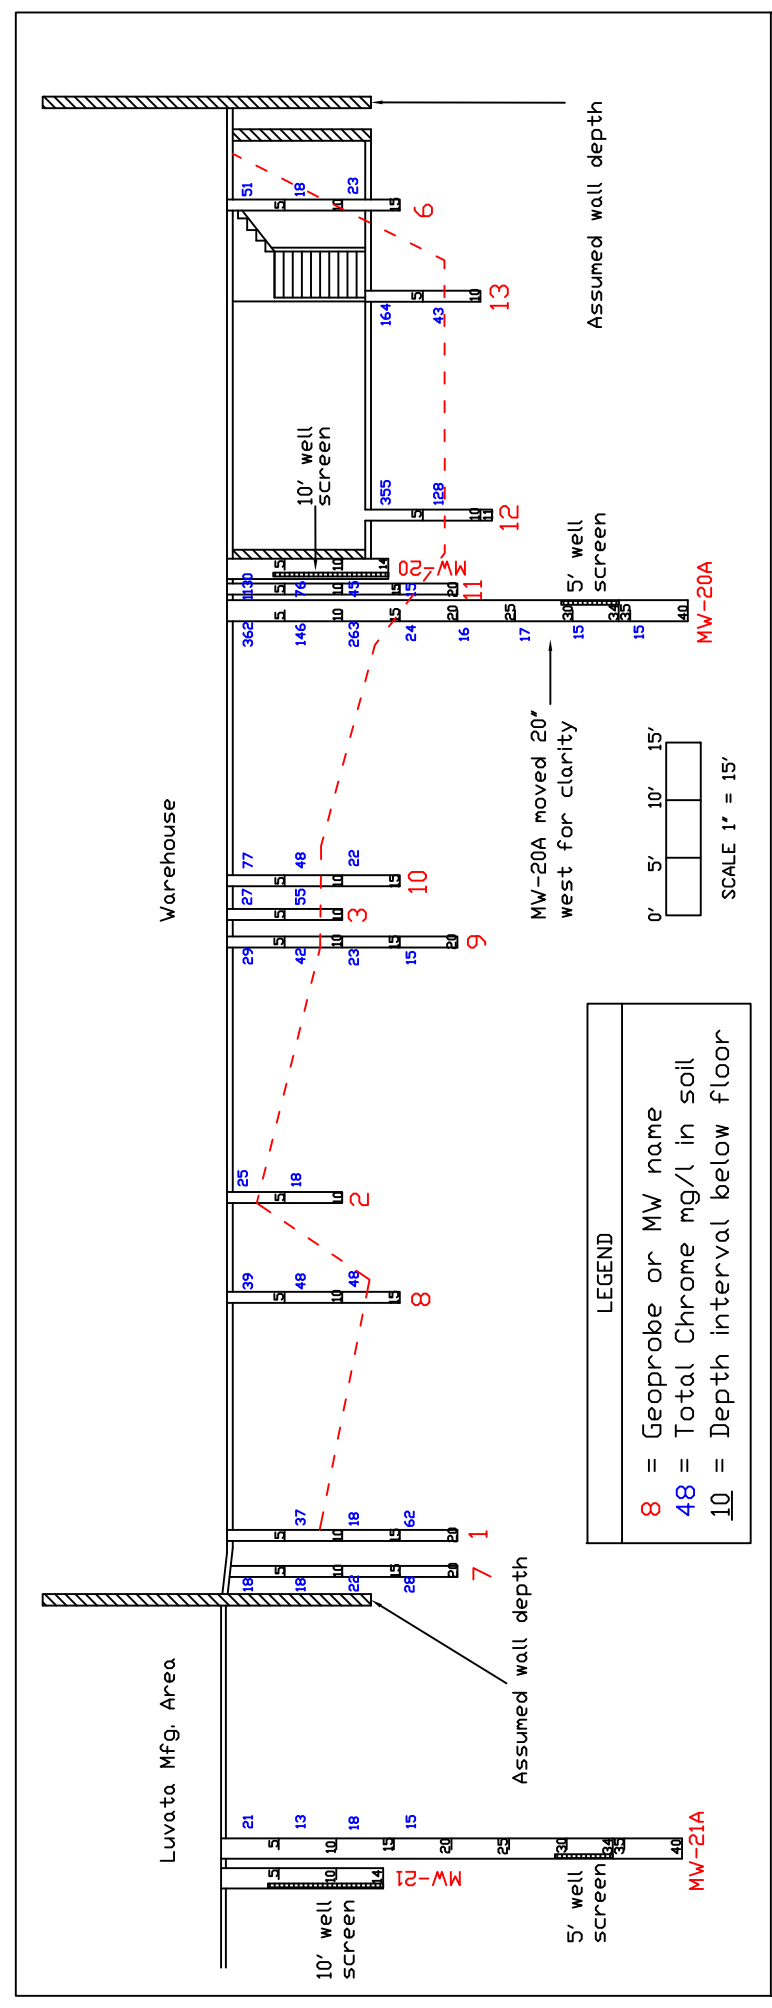
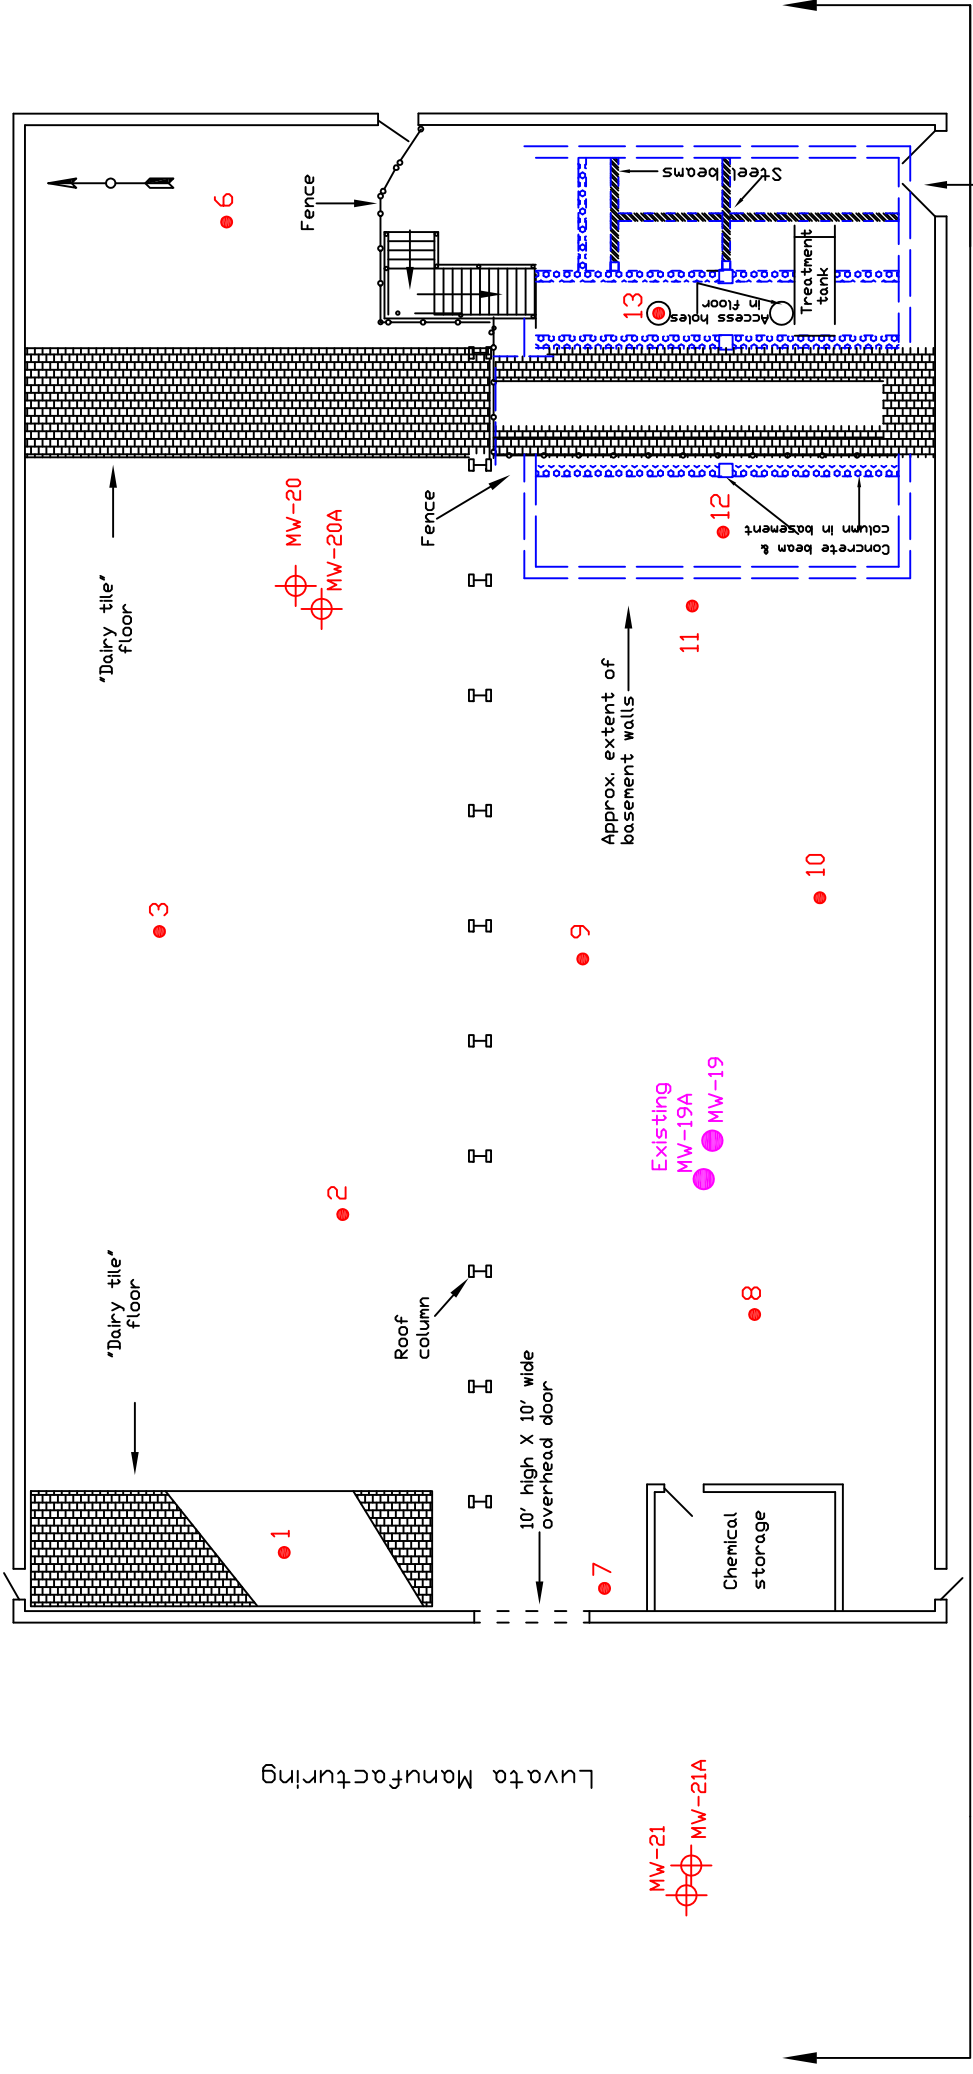



Fig. #5 Cross-section looking south to north through building at soil borings and groundwater monitoring wells with total Chrome concentrations in soil shown with depth.  
 Drawn by Badger Laboratories & Engineering Co. Inc. 5/27/2014






Figure #6 Aerial of Property

Information and aerial photo taken from City of Appleton  
GIS Website "Property Viewer"

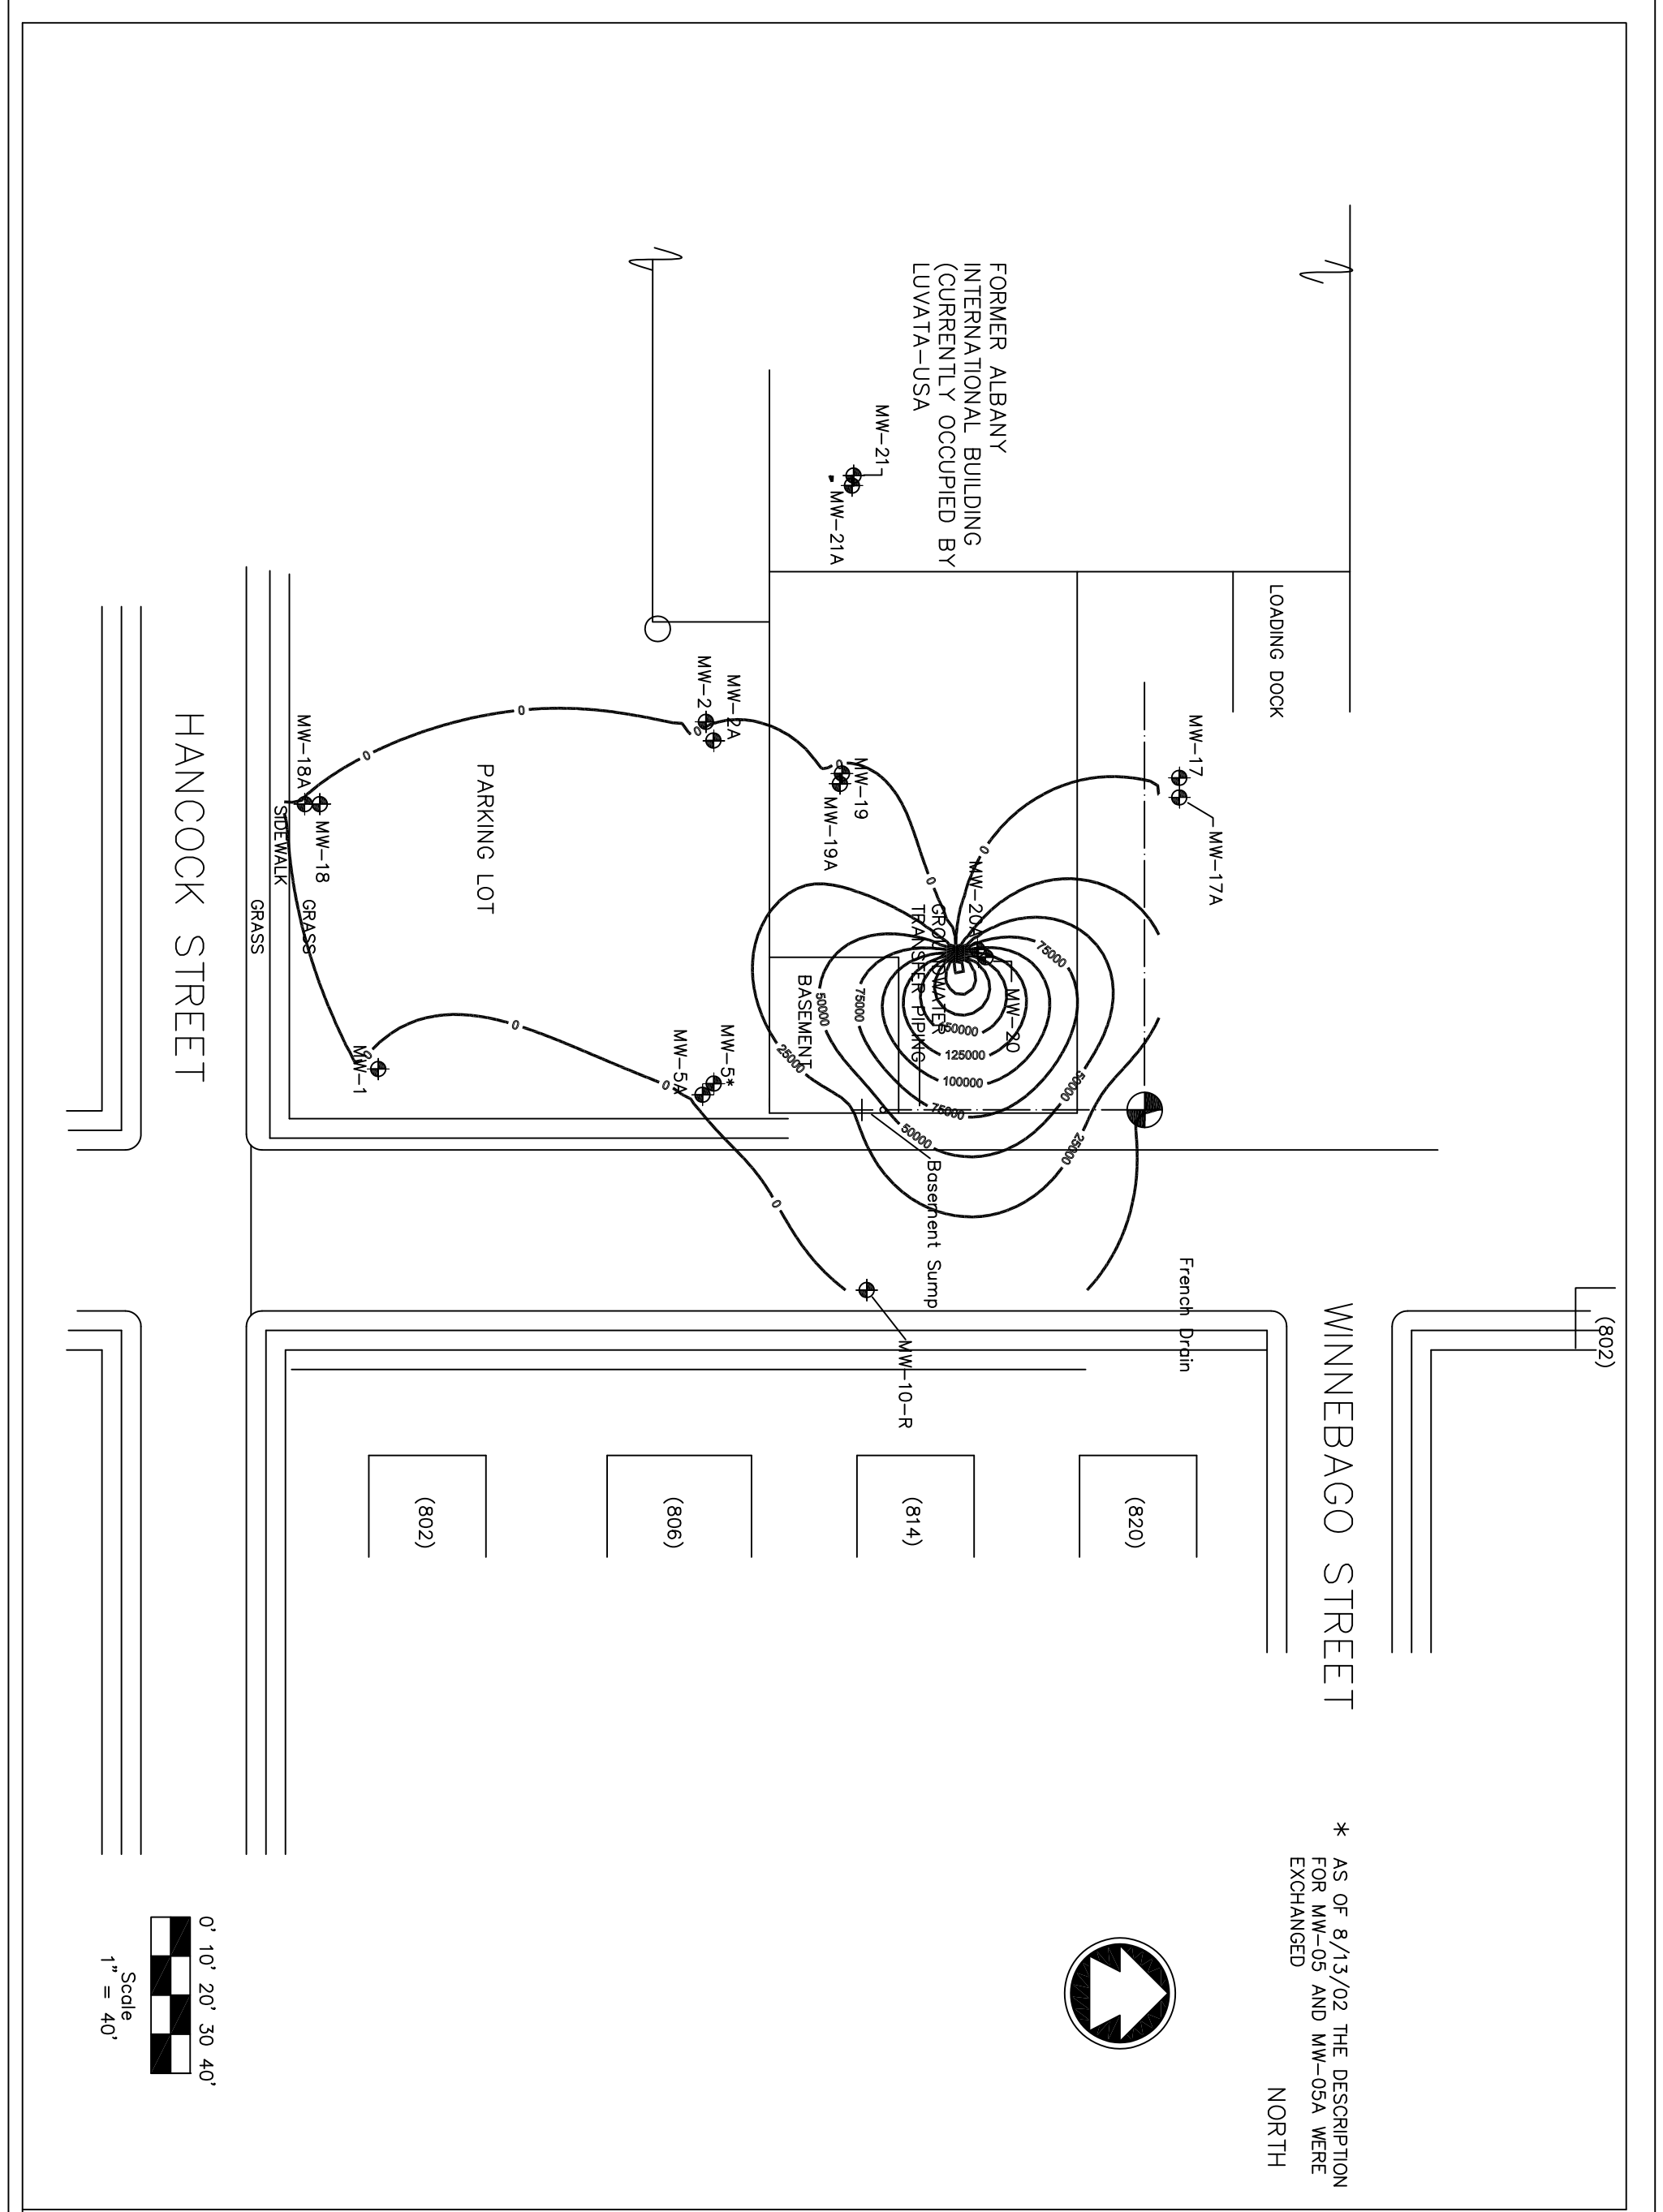

\* AS OF 8/13/02 THE DESCRIPTION FOR MW-05 AND MW-05A WERE EXCHANGED

NORTH

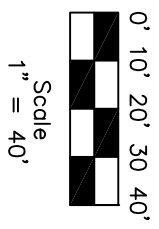

NO.	DATE	REVISION
	8/20/09	Overlay 2005 Aerial Photo

Badger Laboratories & Engineering Co. Inc.  
 501 W. Bell St., Neenah WI 54956  
 TEL: (920) 729-1100 FAX: (920) 729-4945

DESIGNED BY  
 DRAWN BY  
 D.J.C.  
 CHECKED BY  
 K.D.C.

This drawing developed from base drawing provided by McMahon Associates Inc. by Badger Laboratories and Engineering Co. Inc.

Appleton Wire Former Albany International Chrome Plant  
 April 27, 2015 Groundwater  
 Total Chromium Isoconcentration Map (ug/l)

SCALE  
 NO SCALE  
 DATE  
 4/27/09  
 PROJECT NO.  
 Albany Int. Cr02

FIGURE NO.  
 7

FILE NO.



## Soil and Groundwater Results

### Summary Tables

Table #1

Summary of Total and Hex Chromium Concentration in Soil Samples

Sample Name	Sample Date	0'-5' Total chrome (mg/kg)	0'-5' Hex chrome (mg/kg)	0'-5' TCLP chrome (mg/kg)	5'-10' Total chrome (mg/kg)	5'-10' Hex chrome (mg/kg)	5'-10' TCLP chrome (mg/kg)	10'-15' Total chrome (mg/kg)	10'-15' Hex chrome (mg/kg)	10'-15' TCLP chrome (mg/kg)	15'-20' Total chrome (mg/kg)	15'-20' Hex chrome (mg/kg)	20'-25' Total chrome (mg/kg)	20'-25' Hex chrome (mg/kg)	25'-30' Total chrome (mg/kg)	25'-30' Hex chrome (mg/kg)	30'-35' Total chrome (mg/kg)	30'-35' Hex chrome (mg/kg)	35'-40' Total chrome (mg/kg)	35'-40' Hex chrome (mg/kg)
MW-20A	5/13/14	362	3.08	2.6	146	0.941	1.8	263	0.343	4.5	24	0.469	16	0.550	17	0.277	15	<0.231	15	<0.211
MW-21A	5/14/14	21	<0.229	NA	13	<0.224	NA	18	<0.230	NA	15	<0.226	NS	NS	NS	NS	NS	NS	NS	NS
GP-1	5/13/14	NS	NS	NS	37	<0.221	NA	18	<0.218	NA	62	<0.234	NS	NS	NS	NS	NS	NS	NS	NS
GP-2	5/13/14	25	<0.253	NA	18	<0.211	NA	NS	NS	NS	NS	NS	NS	NS	NS	NS	NS	NS	NS	NS
GP-3	5/13/14	27	<0.212	NA	55	<0.223	NA	NS	NS	NS	NS	NS	NS	NS	NS	NS	NS	NS	NS	NS
GP-6	5/13/14	51	<0.229	NA	18	1.23	NA	23	1.35	NS	NS	NS	NS	NS	NS	NS	NS	NS	NS	NS
GP-7	5/12/14	18	<0.227	NA	18	0.368	NA	22	0.582	NA	28	0.287	NS	NS	NS	NS	NS	NS	NS	NS
GP-8	5/12/14	39	0.45	NA	48	0.761	NA	46	0.709	NA	NS	NS	NS	NS	NS	NS	NS	NS	NS	NS
GP-9	5/12/14	29	<0.228	NA	42	0.748	NA	23	<0.221	NA	15	0.774	NS	NS	NS	NS	NS	NS	NS	NS
GP-10	5/12/14	77	1.03	NA	48	1.11	NA	22	<0.225	NA	NS	NS	NS	NS	NS	NS	NS	NS	NS	NS
GP-11	5/12/14	1130	4.48	<b>13</b>	76	1.77	NA	45	<0.235	NA	15	<0.236	NS	NS	NS	NS	NS	NS	NS	NS
GP-12	5/12/14	355	<0.221	0.09	128	<0.237	<0.03	NS	NS	NA	NS	NS	NS	NS	NS	NS	NS	NS	NS	NS
GP-13	5/12/14	164	3.06	<0.03	43	0.306	NA	NS	NS	NS	NS	NS	NS	NS	NS	NS	NS	NS	NS	NS

NA = Not Analyzed

NS = Not Sampled

**13** Exceedance of EPA TCLP limit of 5 mg/L for hazardous waste

**13** Exceedance of DC-RCL limit of 5.58 mg/kg in an Industrial setting.

Table 2  
Summary of Total and Hex Chromium Concentrations  
in Groundwater Samples

Name	Sample Date	Total Chrome (ug/l)	Hex Chrome (ug/l)	NR140 ES (ug/l)	NR140 PAL (ug/l)
GP-13 Temp	5/12/14	<b>2,991</b>	<b>1,600</b>	100	10
GP-7 Temp	5/13/14	<b>183</b>	<b>29</b>	100	10
MW-20	6/2/14	<b>338,000</b>	<b>338,000</b>	100	10
MW-20A	6/2/14	<b>1,200</b>	<b>1,060</b>	100	10
MW-21	6/2/14	3	<30	100	10
MW-21A	6/2/14	2	<30	100	10
<b>183</b>	Exceedance of NR 140 Enforcement Standard of 100 ug/l				
<b>29</b>	Exceedance of NR 140 Preventive Action Limit of 10 ug/l				

## Laboratory Analytical Reports



# BADGER LABORATORIES & ENGINEERING INC.

501 WEST BELL STREET • NEENAH, WISCONSIN 54956-4868 • EST. 1966

(920) 729-1100 • FAX (920) 729-4945 • 1-800-776-7196

ALBANY INTERNATIONAL-APPLETON  
253 TROY RD  
RENSSELAER, NY 12144-

Report Number: 1404784  
Report Date: 7/11/2016  
Sampled By: BL&E

Attn:

PO#:   
# Samples: 22

CC DAVE

Sample Number: 44011288  
Description: GP-7-1 0-5'  
Sample Date: 5/12/2014  
Date Received: 5/12/2014

Parameter	Results	Units	Codes	LOD	LOQ	Method	Analyzed
CHROMIUM,TOTAL REC	18	ppm		0.58	1.9	SM3111D	05/20/14
HEX CHROME	<0.227	ppm		0.227	0.75	SM3500CrD	06/04/14
SOLIDS DIGESTION	DONE			0	0	EPA200.2	05/19/14
TOTAL SOLIDS	86.9	%		0.01	0.01	SM2540B	06/07/14

Sample Number: 44011289  
Description: GP-7-2 5-10'  
Sample Date: 5/12/2014  
Date Received: 5/12/2014

Parameter	Results	Units	Codes	LOD	LOQ	Method	Analyzed
CHROMIUM,TOTAL REC	18	ppm		0.58	1.9	SM3111D	05/20/14
HEX CHROME	0.368	ppm		0.239	0.789	SM3500CrD	06/04/14
SOLIDS DIGESTION	DONE			0	0	EPA200.2	05/19/14
TOTAL SOLIDS	87.6	%		0.01	0.01	SM2540B	06/07/14

Sample Number: 44011290  
Description: GP-7-3 10-15'  
Sample Date: 5/12/2014  
Date Received: 5/12/2014

Parameter	Results	Units	Codes	LOD	LOQ	Method	Analyzed
CHROMIUM,TOTAL REC	22	ppm		0.59	1.9	SM3111D	05/20/14
HEX CHROME	0.582	ppm		0.239	0.789	SM3500CrD	06/04/14
SOLIDS DIGESTION	DONE			0	0	EPA200.2	05/19/14
TOTAL SOLIDS	86.2	%		0.01	0.01	SM2540B	06/07/14





# BADGER LABORATORIES & ENGINEERING INC.

501 WEST BELL STREET • NEENAH, WISCONSIN 54956-4868 • EST. 1966

(920) 729-1100 • FAX (920) 729-4945 • 1-800-776-7196

Sample Number: 44011291  
Description: GP-7-4 15-20'  
Sample Date: 5/12/2014  
Date Received: 5/12/2014

Parameter	Results	Units	Codes	LOD	LOQ	Method	Analyzed
CHROMIUM,TOTAL REC	28	ppm		0.45	1.5	SM3111D	05/20/14
HEX CHROME	0.287	ppm		0.233	0.77	SM3500CrD	06/04/14
SOLIDS DIGESTION	DONE			0	0	EPA200.2	05/19/14
TOTAL SOLIDS	83.4	%		0.01	0.01	SM2540B	06/07/14

Sample Number: 44011292  
Description: GP-8-1 0-5'  
Sample Date: 5/12/2014  
Date Received: 5/12/2014

Parameter	Results	Units	Codes	LOD	LOQ	Method	Analyzed
CHROMIUM,TOTAL REC	39	ppm		0.54	1.8	SM3111D	05/20/14
HEX CHROME	0.450	ppm		0.221	0.729	SM3500CrD	06/04/14
SOLIDS DIGESTION	DONE			0	0	EPA200.2	05/19/14
TOTAL SOLIDS	86.4	%		0.01	0.01	SM2540B	06/07/14

Sample Number: 44011293  
Description: GP-8-2 5-10'  
Sample Date: 5/12/2014  
Date Received: 5/12/2014

Parameter	Results	Units	Codes	LOD	LOQ	Method	Analyzed
CHROMIUM,TOTAL REC	48	ppm		1.5	5	SM3111D	05/20/14
HEX CHROME	0.761	ppm		0.209	0.69	SM3500CrD	06/04/14
SOLIDS DIGESTION	DONE			0	0	EPA200.2	05/19/14
TOTAL SOLIDS	87.1	%		0.01	0.01	SM2540B	06/07/14



# BADGER LABORATORIES & ENGINEERING INC.

501 WEST BELL STREET • NEENAH, WISCONSIN 54956-4868 • EST. 1966

(920) 729-1100 • FAX (920) 729-4945 • 1-800-776-7196

Sample Number: 44011294  
Description: GP-8-3 10-15'  
Sample Date: 5/12/2014  
Date Received: 5/12/2014

Parameter	Results	Units	Codes	LOD	LOQ	Method	Analyzed
CHROMIUM,TOTAL REC	46	ppm		1.4	4.6	SM3111D	05/20/14
HEX CHROME	0.709	ppm		0.219	0.73	SM3500CrD	06/04/14
SOLIDS DIGESTION	DONE			0	0	EPA200.2	05/19/14
TOTAL SOLIDS	82.7	%		0.01	0.01	SM2540B	06/07/14

Sample Number: 44011295  
Description: GP-9-1 0-5'  
Sample Date: 5/12/2014  
Date Received: 5/12/2014

Parameter	Results	Units	Codes	LOD	LOQ	Method	Analyzed
CHROMIUM,TOTAL REC	29	ppm		0.9	2.97	SM3111D	05/20/14
HEX CHROME	<0.228	ppm		0.228	0.752	SM3500CrD	06/04/14
SOLIDS DIGESTION	DONE			0	0	EPA200.2	05/19/14
TOTAL SOLIDS	85.4	%		0.01	0.01	SM2540B	06/07/14

Sample Number: 44011296  
Description: GP-9-2 5-10'  
Sample Date: 5/12/2014  
Date Received: 5/12/2014

Parameter	Results	Units	Codes	LOD	LOQ	Method	Analyzed
CHROMIUM,TOTAL REC	42	ppm		1.3	4.3	SM3111D	05/20/14
HEX CHROME	0.748	ppm		0.231	0.762	SM3500CrD	06/04/14
SOLIDS DIGESTION	DONE			0	0	EPA200.2	05/19/14
TOTAL SOLIDS	88.2	%		0.01	0.01	SM2540B	06/07/14



# BADGER LABORATORIES & ENGINEERING INC.

501 WEST BELL STREET • NEENAH, WISCONSIN 54956-4868 • EST. 1966

(920) 729-1100 • FAX (920) 729-4945 • 1-800-776-7196

Sample Number: 44011297  
Description: GP-9-3 10-15'  
Sample Date: 5/12/2014  
Date Received: 5/12/2014

Parameter	Results	Units	Codes	LOD	LOQ	Method	Analyzed
CHROMIUM,TOTAL REC	23	ppm		0.41	1.4	SM3111D	05/20/14
HEX CHROME	<0.221	ppm		0.221	0.729	SM3500CrD	06/04/14
SOLIDS DIGESTION	DONE			0	0	EPA200.2	05/19/14
TOTAL SOLIDS	85.1	%		0.01	0.01	SM2540B	06/07/14

Sample Number: 44011298  
Description: GP-9-4 15-20'  
Sample Date: 5/12/2014  
Date Received: 5/12/2014

Parameter	Results	Units	Codes	LOD	LOQ	Method	Analyzed
CHROMIUM,TOTAL REC	15	ppm		0.35	1.2	SM3111D	05/20/14
HEX CHROME	0.774	ppm		0.213	0.703	SM3500CrD	06/04/14
SOLIDS DIGESTION	DONE			0	0	EPA200.2	05/19/14
TOTAL SOLIDS	81.7	%		0.01	0.01	SM2540B	06/07/14

Sample Number: 44011299  
Description: GP-10-1 0-5'  
Sample Date: 5/12/2014  
Date Received: 5/12/2014

Parameter	Results	Units	Codes	LOD	LOQ	Method	Analyzed
CHROMIUM,TOTAL REC	77	ppm		2.3	7.6	SM3111D	05/20/14
HEX CHROME	1.03	ppm		0.232	0.766	SM3500CrD	06/04/14
SOLIDS DIGESTION	DONE			0	0	EPA200.2	05/19/14
TOTAL SOLIDS	87.8	%		0.01	0.01	SM2540B	06/07/14



# BADGER LABORATORIES & ENGINEERING INC.

501 WEST BELL STREET • NEENAH, WISCONSIN 54956-4868 • EST. 1966

(920) 729-1100 • FAX (920) 729-4945 • 1-800-776-7196

Sample Number: 44011300  
Description: GP-10-2 5-10'  
Sample Date: 5/12/2014  
Date Received: 5/12/2014

Parameter	Results	Units	Codes	LOD	LOQ	Method	Analyzed
CHROMIUM,TOTAL REC	48	ppm		1.5	5	SM3111D	05/20/14
HEX CHROME	1.11	ppm		0.23	0.759	SM3500CrD	06/04/14
SOLIDS DIGESTION	DONE			0	0	EPA200.2	05/19/14
TOTAL SOLIDS	86.5	%		0.01	0.01	SM2540B	06/07/14

Sample Number: 44011301  
Description: GP-10-3 10-15'  
Sample Date: 5/12/2014  
Date Received: 5/12/2014

Parameter	Results	Units	Codes	LOD	LOQ	Method	Analyzed
CHROMIUM,TOTAL REC	22	ppm		0.45	1.5	SM3111D	05/20/14
HEX CHROME	<0.225	ppm		0.225	0.743	SM3500CrD	06/04/14
SOLIDS DIGESTION	DONE			0	0	EPA200.2	05/19/14
TOTAL SOLIDS	84.4	%		0.01	0.01	SM2540B	06/07/14

Sample Number: 44011302  
Description: GP-11-1 0-5'  
Sample Date: 5/12/2014  
Date Received: 5/12/2014

Parameter	Results	Units	Codes	LOD	LOQ	Method	Analyzed
CHROMIUM,TOTAL REC	1130	ppm		34	112	SM3111D	05/20/14
HEX CHROME	4.48	ppm		0.214	0.706	SM3500CrD	06/04/14
METALS DIGESTION	DONE			0	0	EPA200.2	05/29/14
SOLIDS DIGESTION	DONE			0	0	EPA200.2	05/19/14
TCLP CHROMIUM	13	mg/l		0.37	1.2	SM3111B	06/02/14
TCLP EXTRACTION	COMPLETE			0	0	SW846-1311	05/27/14
TOTAL SOLIDS	95.7	%		0.01	0.01	SM2540B	06/07/14



# BADGER LABORATORIES & ENGINEERING INC.

501 WEST BELL STREET • NEENAH, WISCONSIN 54956-4868 • EST. 1966

(920) 729-1100 • FAX (920) 729-4945 • 1-800-776-7196

Sample Number: 44011303  
Description: GP-11-2 5-10'  
Sample Date: 5/12/2014  
Date Received: 5/12/2014

Parameter	Results	Units	Codes	LOD	LOQ	Method	Analyzed
CHROMIUM,TOTAL REC	76	ppm		2.1	6.9	SM3111D	05/20/14
HEX CHROME	1.77	ppm		0.22	0.726	SM3500CrD	06/04/14
SOLIDS DIGESTION	DONE			0	0	EPA200.2	05/19/14
TOTAL SOLIDS	95.6	%		0.01	0.01	SM2540B	06/07/14

Sample Number: 44011304  
Description: GP-11-3 10-15'  
Sample Date: 5/12/2014  
Date Received: 5/12/2014

Parameter	Results	Units	Codes	LOD	LOQ	Method	Analyzed
CHROMIUM,TOTAL REC	45	ppm		1.3	4.3	SM3111D	05/20/14
HEX CHROME	<0.235	ppm		0.235	0.776	SM3500CrD	06/04/14
SOLIDS DIGESTION	DONE			0	0	EPA200.2	05/19/14
TOTAL SOLIDS	80.8	%		0.01	0.01	SM2540B	06/07/14

Sample Number: 44011305  
Description: GP-11-4 15-20'  
Sample Date: 5/12/2014  
Date Received: 5/12/2014

Parameter	Results	Units	Codes	LOD	LOQ	Method	Analyzed
CHROMIUM,TOTAL REC	15	ppm		0.31	1	SM3111D	05/20/14
HEX CHROME	<0.236	ppm		0.236	0.779	SM3500CrD	06/04/14
SOLIDS DIGESTION	DONE			0	0	EPA200.2	05/19/14
TOTAL SOLIDS	80.4	%		0.01	0.01	SM2540B	06/07/14



# BADGER LABORATORIES & ENGINEERING INC.

501 WEST BELL STREET • NEENAH, WISCONSIN 54956-4868 • EST. 1966

(920) 729-1100 • FAX (920) 729-4945 • 1-800-776-7196

Sample Number: 44011306  
Description: GP-12-1 0-5'  
Sample Date: 5/12/2014  
Date Received: 5/12/2014

Parameter	Results	Units	Codes	LOD	LOQ	Method	Analyzed
CHROMIUM,TOTAL REC	355	ppm		0.38	1.3	SM3111D	05/20/14
HEX CHROME	<0.221	ppm		0.221	0.729	SM3500CrD	06/04/14
METALS DIGESTION	DONE			0	0	EPA200.2	05/29/14
SOLIDS DIGESTION	DONE			0	0	EPA200.2	05/19/14
TCLP CHROMIUM	0.09	mg/l		0.03	0.1	SM3111B	06/02/14
TCLP EXTRACTION	COMPLETE			0	0	SW846-1311	05/27/14
TOTAL SOLIDS	80.9	%		0.01	0.01	SM2540B	06/07/14

Sample Number: 44011307  
Description: GP-1202 5-10'  
Sample Date: 5/12/2014  
Date Received: 5/12/2014

Parameter	Results	Units	Codes	LOD	LOQ	Method	Analyzed
CHROMIUM,TOTAL REC	128	ppm		0.44	1.5	SM3111D	05/20/14
HEX CHROME	<0.237	ppm		0.237	0.782	SM3500CrD	06/04/14
METALS DIGESTION	DONE			0	0	EPA200.2	05/29/14
SOLIDS DIGESTION	DONE			0	0	EPA200.2	05/19/14
TCLP CHROMIUM	<0.03	mg/l		0.03	0.1	SM3111B	06/02/14
TCLP EXTRACTION	COMPLETE			0	0	SW846-1311	05/27/14
TOTAL SOLIDS	81.7	%		0.01	0.01	SM2540B	06/07/14

Sample Number: 44011308  
Description: GP-13-1 0-5'  
Sample Date: 5/12/2014  
Date Received: 5/12/2014

Parameter	Results	Units	Codes	LOD	LOQ	Method	Analyzed
CHROMIUM,TOTAL REC	164	ppm		0.36	1.2	SM3111D	05/20/14
HEX CHROME	3.06	ppm		0.224	0.739	SM3500CrD	06/04/14
METALS DIGESTION	DONE			0	0	EPA200.2	05/29/14
SOLIDS DIGESTION	DONE			0	0	EPA200.2	05/19/14
TCLP CHROMIUM	<0.03	mg/l		0.03	0.1	SM3111B	06/02/14
TCLP EXTRACTION	COMPLETE			0	0	SW846-1311	05/27/14
TOTAL SOLIDS	80.0	%		0.01	0.01	SM2540B	06/07/14



# BADGER LABORATORIES & ENGINEERING INC.

501 WEST BELL STREET • NEENAH, WISCONSIN 54956-4868 • EST. 1966

(920) 729-1100 • FAX (920) 729-4945 • 1-800-776-7196

Sample Number: 44011309  
Description: GP-13-2 5-11'  
Sample Date: 5/12/2014  
Date Received: 5/12/2014

Parameter	Results	Units	Codes	LOD	LOQ	Method	Analyzed
CHROMIUM,TOTAL REC	43	ppm		0.42	1.4	SM3111D	05/20/14
HEX CHROME	0.306	ppm		0.248	0.818	SM3500CrD	06/04/14
SOLIDS DIGESTION	DONE			0	0	EPA200.2	05/19/14
TOTAL SOLIDS	80.0	%		0.01	0.01	SM2540B	06/07/14

BADGER LABS & ENGINEERING  
WDNR Certified Lab #445023150  
Approved By:

JMW:dc

**CHEMISTS**  
**ENGINEERS**

# BADGER LABORATORIES & ENGINEERING, INC.

501 WEST BELL STREET - NEENAH, WISCONSIN 54956-4868 - EST. 1966  
(920) 729-1100 - Fax (920) 729-4945 - 1-800-776-7196

## SAMPLE RECEIPT FORM

### CLIENT INFORMATION

**COMPANY:** ALBANY INTERNATIONAL RON BUCK  
**NAME:** 435 6th Street  
**ADDRESS:** Menasha WA 54952  
**PHONE:**  
**P.O. #:**  
**PROJECT/SITE:**  
**REPORT & BILL TO:** RON BUCK  
**ADDITIONAL REPORTS TO:** DAVE CASPER

### TURN AROUND TIME:

Normal  
 Rush (Approval \_\_\_\_\_)

### SAMPLE TYPE:

Groundwater  
 Wastewater  
 WPDES  
 Cooling Water  
 Drinking Water  
 Solid Waste  
 Oil  
 Other SOIL

Lab Filtered  
 Field Filtered  
 Grab  
 Composite  
 Flow Proportional  
 Time Proportional

CUSTOMER SAMPLE ID	SAMPLE DATE/TIME	DATE RECD	BL & E REPORT #	BL & E SAMPLE #	TEMP °F	CONTAINER	ICG Y/N	DELIVERY METHOD				PRESERVATION				ANALYTICAL REQUESTS	pH ok	EP			
								BL&E	CLIENT	UPS	OTHER	PIF	NON-PRES	H2SO4	HNO3				NaOH	OTHER	
GP-7-1 0-5'	13:00 5-12-14	5-12-14	4889	1188	7	1	Y											TOTAL + HEY CHROME			
GP-7-2 5-10'	15:10 5-12-14			1189	7	1															
GP-7-3 10-15'	15:20 5-12-14			1090	7	1															
GP-7-4 15-20'	15:30 5-12-14			1121	7	1															
GP-8-1 0-5'	14:00 5-12-14			1122	7	1															
GP-8-2 5-10'	14:10 5-12-14			1093	7	1															
GP-8-3 10-15'	14:15 5-12-14			1124	7	1															
GP-9-1 0-5'	18:45 5-12-14			1125	7	1															
GP-9-2 5-10'	18:55 5-12-14			1090	7	1															
GP-9-3 10-15'	13:00 5-12-14			1127	7	1															

### CHAIN OF CUSTODY RECORD

**FILLED IN BY CUSTOMER**  
 SAMPLED BY: Dave Casper  
 DATE/TIME SAMPLED: 5-12-14  
 RELINQUISHED BY: Dave Casper

**FILLED IN BY BADGER LABS & ENG**  
 RECEIVED BY: [Signature]  
 DATE/TIME RECEIVED: 5/12/14  
 LOGGED IN:

\* Temperature over 4°C are above EPA/DNR Protocol unless received on ice.  
 \* EP= if pH was not correct, extra preservation was added until correct pH was achieved.  
 \* PIF= Preserved in field.  
 \* PIL= Preserved in lab.



**CHEMISTS**  
**ENGINEERS**

**BADGER LABORATORIES & ENGINEERING, INC.**  
501 WEST BELL STREET - NEENAH, WISCONSIN 54956-4868 - EST. 1966  
(920) 729-1100 - Fax (920) 729-4945 - 1-800-776-7196

**SAMPLE RECEIPT FORM**

**CLIENT INFORMATION**

**COMPANY:** ALBANY INTERNATIONAL (ROND BUCK)  
**NAME:** ALBANY INTERNATIONAL (ROND BUCK)  
**ADDRESS:** 435 6th STREET  
 MENASHA, WI 54952  
**PHONE:**  
**P.O. #:**  
**PROJECT/SITE:**  
**REPORT & BILL TO:** ROND BUCK  
**ADDITIONAL REPORTS TO:** DAVE CASPER

**TURN AROUND TIME:**  
 Normal  
 Rush (Approval \_\_\_\_\_)

**SAMPLE TYPE:**  
 Groundwater  
 Wastewater  
 WPDES  
 Cooling Water  
 Drinking Water  
 Solid Waste  
 Oil  
 Other SOIL

Lab Filtered  
 Field Filtered  
 Grab  
 Composite  
 Flow Proportional  
 Time Proportional

CUSTOMER SAMPLE ID	SAMPLE DATE/TIME	DATE RECD	BL & E REPORT #	BL & E SAMPLE #	TEMP °C	CONTAINER	Ice Y/N	DELIVERY METHOD				PRESERVATION				ANALYTICAL REQUESTS	PH OK	EP
								BL&E	CLIENT	UPS	OTHER	PIF	NON-PRES	H2SO4	HNO3			
GP-9-4 15-20	13:12 5-12-14	5/12/14	4881	11288	-1	1												TOTAL 4 HEX CHROME
GP-10-1 0-5	12:10 5-12-14			11229	1	1												
GP-10-2 5-10	12:15 5-12-14			11300	1	1												
GP-10-3 10-15	12:20 5-12-20			11301	1	1												
GP-11-1 0-5	10:30 5-12-14			11302	1	1												
GP-11-2 5-10	10:40 5-12-14			11303	1	1												
GP-11-3 10-15	10:50 5-12-14			11304	1	1												
GP-11-4 15-20	10:00 5-12-14			11305	1	1												
GP-12-1 0-5	10:00 5/12/14			11306	1	1												
GP-12-2 5-10	10:10 5/12/14			11307	1	1												

**CHAIN OF CUSTODY RECORD**

<b>FILLED IN BY CUSTOMER</b> SAMPLED BY: <u>Dave Casper</u> DATE/TIME SAMPLED: <u>5-12-14</u> RELINQUISHED BY: <u>Dave Casper</u>	<b>FILLED IN BY BADGER LABS &amp; ENG</b> RECEIVED BY: <u>BSB</u> DATE/TIME RECEIVED: <u>5/12/14</u> LOGGED IN: <u>S/12/14</u>
--	---

\* Temperature over 4°C are above EPA/DNR Protocol unless received on ice.  
 \* EP= if pH was not correct, extra preservation was added until correct pH was achieved.  
 \* PIF= Preserved in field.  
 \* PIL= Preserved in lab.

CHEMISTS  
ENGINEERS

# BADGER LABORATORIES & ENGINEERING, INC.

501 WEST BELL STREET - NEENAH, WISCONSIN 54956-4868 - EST. 1966  
(920) 729-1100 - Fax (920) 729-4945 - 1-800-776-7196

## SAMPLE RECEIPT FORM

### CLIENT INFORMATION

COMPANY: ALBANY INTERNATIONAL (ROO BACK)  
 NAME: ALBANY INTERNATIONAL (ROO BACK)  
 ADDRESS: 435 6th STREET  
MEWASHA WI 54952  
 PHONE: \_\_\_\_\_  
 P.O.#: \_\_\_\_\_  
 PROJECT/SITE: \_\_\_\_\_  
 REPORT & BILL TO: RON BUCK  
 ADDITIONAL REPORTS TO: DAVE CASPER

TURN AROUND TIME:  Normal  Rush (Approval \_\_\_\_\_)

SAMPLE TYPE:  
 Groundwater  Lab Filtered  
 Wastewater  Field Filtered  
 WPDES  Grab  
 Cooling Water  Composite  
 Drinking Water  Flow Proportional  
 Solid Waste  Time Proportional  
 Oil  Other SOIL

CUSTOMER SAMPLE ID	SAMPLE DATE/TIME	DATE RECD	BL & E REPORT #	BL & E SAMPLE #	TEMP	CONTAINER	Ice Y/N	DELIVERY METHOD				PRESERVATION				ANALYTICAL REQUESTS	pH ok	EP
								BL&E	CLIENT	UPS	OTHER	PIF	PIL	NON-PRES	H2SO4			
GP-13-1 0-5	09:30 5-13-14	5/21/14	4788	11308	21	S	Y											TOTAL & HEX CHLORIDE ↓
GP-13-2 5-11	09:40 5-13-14	↓		11309	21	S	Y											

### CHAIN OF CUSTODY RECORD

FILLED IN BY CUSTOMER: \_\_\_\_\_  
 SAMPLED BY: Ron Buck  
 DATE/TIME SAMPLED: 5-13-14  
 RELINQUISHED BY: Ron Buck

FILLED IN BY BADGER LABS & ENG  
 RECEIVED BY: Bob Strick  
 DATE/TIME RECEIVED: \_\_\_\_\_  
 LOGGED IN: 1710

\* Temperature over 4°C are above EPA/ENR Protocol unless received on ice.  
 \* EP= if pH was not correct, extra preservation was added until correct pH was achieved.  
 \* PIF= Preserved in field.  
 \* PIL= Preserved in lab.



# BADGER LABORATORIES & ENGINEERING INC.

501 WEST BELL STREET • NEENAH, WISCONSIN 54956-4868 • EST. 1966

(920) 729-1100 • FAX (920) 729-4945 • 1-800-776-7196

ALBANY INTERNATIONAL-APPLETON  
253 TROY RD  
RENSSELAER, NY 12144-

Report Number: 1404841  
Report Date: 7/11/2016  
Sampled By: BL&E

Attn:

PO#:   
# Samples: 1

CC DAVE

Sample Number: 44011413  
Description: GEO PROBE GP-7 TEMP  
WELL #7  
Sample Date: 5/13/2014  
Date Received: 5/14/2014

Parameter	Results	Units	Codes	LOD	LOQ	Method	Analyzed
CHROMIUM,TOTAL REC	183	ug/l		30	100	SM3111D	05/23/14
HEX CHROME	0.029	mg/l		0.003	0.009	SM3500CrD	05/17/14
METALS DIGESTION	DONE			0	0	EPA200.2	05/23/14

BADGER LABS & ENGINEERING  
WDNR Certified Lab #445023150  
Approved By:

JMW:dc





# BADGER LABORATORIES & ENGINEERING INC.

501 WEST BELL STREET • NEENAH, WISCONSIN 54956-4868 • EST. 1966

(920) 729-1100 • FAX (920) 729-4945 • 1-800-776-7196

ALBANY INTERNATIONAL-APPLETON  
253 TROY RD  
RENSSELAER, NY 12144-

Report Number: 1404948  
Report Date: 7/11/2016  
Sampled By: BL&E

Attn:

PO#: 22  
# Samples: 22

CC DAVE

Sample Number: 44011634  
Description: MW 20-A-1 0-5'  
Sample Date: 5/14/2014  
Date Received: 5/15/2014

Parameter	Results	Units	Codes	LOD	LOQ	Method	Analyzed
CHROMIUM,TOTAL REC	362	ppm		9.3	31	SM3111D	05/20/14
HEX CHROME	3.08	ppm		0.247	0.815	SM3500CrD	06/04/14
METALS DIGESTION	DONE			0	0	EPA200.2	05/29/14
SOLIDS DIGESTION	DONE			0	0	EPA200.2	05/19/14
TCLP CHROMIUM	2.6	mg/l		0.03	0.1	SM3111B	06/02/14
TCLP EXTRACTION	COMPLETE			0	0	SW846-1311	05/27/14
TOTAL SOLIDS	86.1	%		0.01	0.01	SM2540B	06/07/14

Sample Number: 44011635  
Description: MW 20-A-2 5-10'  
Sample Date: 5/13/2014  
Date Received: 5/15/2014

Parameter	Results	Units	Codes	LOD	LOQ	Method	Analyzed
CHROMIUM,TOTAL REC	146	ppm		4.2	14	SM3111D	05/20/14
HEX CHROME	0.941	ppm		0.259	0.855	SM3500CrD	06/04/14
METALS DIGESTION	DONE			0	0	EPA200.2	05/29/14
SOLIDS DIGESTION	DONE			0	0	EPA200.2	05/19/14
TCLP CHROMIUM	1.8	mg/l		0.03	0.1	SM3111B	06/02/14
TCLP EXTRACTION	COMPLETE			0	0	SW846-1311	05/27/14
TOTAL SOLIDS	87.1	%		0.01	0.01	SM2540B	06/07/14



# BADGER LABORATORIES & ENGINEERING INC.

501 WEST BELL STREET • NEENAH, WISCONSIN 54956-4868 • EST. 1966

(920) 729-1100 • FAX (920) 729-4945 • 1-800-776-7196

Sample Number: 44011636  
Description: MW 20-A-3 10-15'  
Sample Date: 5/13/2014  
Date Received: 5/15/2014

Parameter	Results	Units	Codes	LOD	LOQ	Method	Analyzed
CHROMIUM,TOTAL REC	263	ppm		7.1	23	SM3111D	05/20/14
HEX CHROME	0.343	ppm		0.21	0.693	SM3500CrD	06/04/14
METALS DIGESTION	DONE			0	0	EPA200.2	05/29/14
SOLIDS DIGESTION	DONE			0	0	EPA200.2	05/19/14
TCLP CHROMIUM	4.5	mg/l		0.03	0.1	SM3111B	06/02/14
TCLP EXTRACTION	COMPLETE			0	0	SW846-1311	05/27/14
TOTAL SOLIDS	84.6	%		0.01	0.01	SM2540B	06/07/14

Sample Number: 44011637  
Description: MW 20-A-4 15-20'  
Sample Date: 5/13/2014  
Date Received: 5/15/2014

Parameter	Results	Units	Codes	LOD	LOQ	Method	Analyzed
CHROMIUM,TOTAL REC	24	ppm		0.47	1.6	SM3111D	05/20/14
HEX CHROME	0.469	ppm		0.231	0.762	SM3500CrD	06/04/14
SOLIDS DIGESTION	DONE			0	0	EPA200.2	05/19/14
TOTAL SOLIDS	81.6	%		0.01	0.01	SM2540B	06/07/14

Sample Number: 44011638  
Description: MW 20-A-5 20-25'  
Sample Date: 5/13/2014  
Date Received: 5/15/2014

Parameter	Results	Units	Codes	LOD	LOQ	Method	Analyzed
CHROMIUM,TOTAL REC	16	ppm		0.4	1.32	SM3111D	05/20/14
HEX CHROME	0.550	ppm		0.226	0.746	SM3500CrD	06/04/14
SOLIDS DIGESTION	DONE			0	0	EPA200.2	05/19/14
TOTAL SOLIDS	80.8	%		0.01	0.01	SM2540B	06/07/14



# BADGER LABORATORIES & ENGINEERING INC.

501 WEST BELL STREET • NEENAH, WISCONSIN 54956-4868 • EST. 1966

(920) 729-1100 • FAX (920) 729-4945 • 1-800-776-7196

Sample Number: 44011639  
Description: MW 20-A-6 25-30'  
Sample Date: 5/13/2014  
Date Received: 5/15/2014

Parameter	Results	Units	Codes	LOD	LOQ	Method	Analyzed
CHROMIUM,TOTAL REC	17	ppm		0.41	1.4	SM3111D	05/20/14
HEX CHROME	0.277	ppm		0.225	0.743	SM3500CrD	06/04/14
SOLIDS DIGESTION	DONE			0	0	EPA200.2	05/19/14
TOTAL SOLIDS	81.4	%		0.01	0.01	SM2540B	06/07/14

Sample Number: 44011640  
Description: MW 20-A-7 30-35'  
Sample Date: 5/13/2014  
Date Received: 5/15/2014

Parameter	Results	Units	Codes	LOD	LOQ	Method	Analyzed
CHROMIUM,TOTAL REC	15	ppm		0.48	1.6	SM3111D	05/20/14
HEX CHROME	<0.231	ppm		0.231	0.762	SM3500CrD	06/04/14
SOLIDS DIGESTION	DONE			0	0	EPA200.2	05/19/14
TOTAL SOLIDS	80.6	%		0.01	0.01	SM2540B	06/07/14

Sample Number: 44011641  
Description: MW 20-A-8 35-40'  
Sample Date: 5/13/2014  
Date Received: 5/15/2014

Parameter	Results	Units	Codes	LOD	LOQ	Method	Analyzed
CHROMIUM,TOTAL REC	15	ppm		0.38	1.3	SM3111D	05/20/14
HEX CHROME	<0.211	ppm		0.211	0.696	SM3500CrD	06/04/14
SOLIDS DIGESTION	DONE			0	0	EPA200.2	05/19/14
TOTAL SOLIDS	80.4	%		0.01	0.01	SM2540B	06/07/14



# BADGER LABORATORIES & ENGINEERING INC.

501 WEST BELL STREET • NEENAH, WISCONSIN 54956-4868 • EST. 1966

(920) 729-1100 • FAX (920) 729-4945 • 1-800-776-7196

Sample Number: 44011642  
Description: GP-1-2 5-10'  
Sample Date: 5/13/2014  
Date Received: 5/15/2014

Parameter	Results	Units	Codes	LOD	LOQ	Method	Analyzed
CHROMIUM,TOTAL REC	37	ppm		1.2	4	SM3111D	05/20/14
HEX CHROME	<0.221	ppm		0.221	0.729	SM3500CrD	06/04/14
SOLIDS DIGESTION	DONE			0	0	EPA200.2	05/19/14
TOTAL SOLIDS	85.3	%		0.01	0.01	SM2540B	06/07/14

Sample Number: 44011643  
Description: GP-1-3 10-15'  
Sample Date: 5/13/2014  
Date Received: 5/15/2014

Parameter	Results	Units	Codes	LOD	LOQ	Method	Analyzed
CHROMIUM,TOTAL REC	18	ppm		0.4	1.32	SM3111D	05/20/14
HEX CHROME	<0.218	ppm		0.218	0.719	SM3500CrD	06/04/14
SOLIDS DIGESTION	DONE			0	0	EPA200.2	05/19/14
TOTAL SOLIDS	82.6	%		0.01	0.01	SM2540B	06/07/14

Sample Number: 44011644  
Description: GP-1-4 15-20'  
Sample Date: 5/13/2014  
Date Received: 5/15/2014

Parameter	Results	Units	Codes	LOD	LOQ	Method	Analyzed
CHROMIUM,TOTAL REC	62	ppm		1.9	6.3	SM3111D	05/20/14
HEX CHROME	<0.234	ppm		0.234	0.772	SM3500CrD	06/04/14
SOLIDS DIGESTION	DONE			0	0	EPA200.2	05/19/14
TOTAL SOLIDS	82.4	%		0.01	0.01	SM2540B	06/07/14





# BADGER LABORATORIES & ENGINEERING INC.

501 WEST BELL STREET • NEENAH, WISCONSIN 54956-4868 • EST. 1966

(920) 729-1100 • FAX (920) 729-4945 • 1-800-776-7196

Sample Number: 44011645  
Description: GP-2-1 0-5'  
Sample Date: 5/13/2014  
Date Received: 5/15/2014

Parameter	Results	Units	Codes	LOD	LOQ	Method	Analyzed
CHROMIUM,TOTAL REC	25	ppm		0.4	1.32	SM3111D	05/20/14
HEX CHROME	<0.253	ppm		0.253	0.835	SM3500CrD	06/04/14
SOLIDS DIGESTION	DONE			0	0	EPA200.2	05/19/14
TOTAL SOLIDS	77.7	%		0.01	0.01	SM2540B	06/07/14

Sample Number: 44011646  
Description: GP-2-2 5-10'  
Sample Date: 5/13/2014  
Date Received: 5/15/2014

Parameter	Results	Units	Codes	LOD	LOQ	Method	Analyzed
CHROMIUM,TOTAL REC	18	ppm		0.38	1.3	SM3111D	05/20/14
HEX CHROME	<0.211	ppm		0.211	0.696	SM3500CrD	06/04/14
SOLIDS DIGESTION	DONE			0	0	EPA200.2	05/19/14
TOTAL SOLIDS	83.5	%		0.01	0.01	SM2540B	06/07/14

Sample Number: 44011647  
Description: GP-3-1 0-5'  
Sample Date: 5/13/2014  
Date Received: 5/15/2014

Parameter	Results	Units	Codes	LOD	LOQ	Method	Analyzed
CHROMIUM,TOTAL REC	27	ppm		0.83	2.7	SM3111D	05/20/14
HEX CHROME	<0.212	ppm		0.212	0.7	SM3500CrD	06/04/14
SOLIDS DIGESTION	DONE			0	0	EPA200.2	05/19/14
TOTAL SOLIDS	79.7	%		0.01	0.01	SM2540B	06/07/14



# BADGER LABORATORIES & ENGINEERING INC.

501 WEST BELL STREET • NEENAH, WISCONSIN 54956-4868 • EST. 1966

(920) 729-1100 • FAX (920) 729-4945 • 1-800-776-7196

Sample Number: 44011648  
Description: GP-3-2 5-10'  
Sample Date: 5/13/2014  
Date Received: 5/15/2014

Parameter	Results	Units	Codes	LOD	LOQ	Method	Analyzed
CHROMIUM,TOTAL REC	55	ppm		1.7	5.6	SM3111D	05/20/14
HEX CHROME	<0.223	ppm		0.223	0.736	SM3500CrD	06/04/14
SOLIDS DIGESTION	DONE			0	0	EPA200.2	05/19/14
TOTAL SOLIDS	84.2	%		0.01	0.01	SM2540B	06/07/14

Sample Number: 44011649  
Description: GP-6-1 0-5'  
Sample Date: 5/13/2014  
Date Received: 5/15/2014

Parameter	Results	Units	Codes	LOD	LOQ	Method	Analyzed
CHROMIUM,TOTAL REC	51	ppm		1.5	5	SM3111D	05/20/14
HEX CHROME	<0.229	ppm		0.229	0.756	SM3500CrD	06/04/14
SOLIDS DIGESTION	DONE			0	0	EPA200.2	05/19/14
TOTAL SOLIDS	82.9	%		0.01	0.01	SM2540B	06/07/14

Sample Number: 44011650  
Description: GP-6-2 5-10'  
Sample Date: 5/13/2014  
Date Received: 5/15/2014

Parameter	Results	Units	Codes	LOD	LOQ	Method	Analyzed
CHROMIUM,TOTAL REC	18	ppm		0.54	1.8	SM3111D	05/20/14
HEX CHROME	1.23	ppm		0.234	0.772	SM3500CrD	06/04/14
SOLIDS DIGESTION	DONE			0	0	EPA200.2	05/19/14
TOTAL SOLIDS	86.7	%		0.01	0.01	SM2540B	06/07/14



# BADGER LABORATORIES & ENGINEERING INC.

501 WEST BELL STREET • NEENAH, WISCONSIN 54956-4868 • EST. 1966

(920) 729-1100 • FAX (920) 729-4945 • 1-800-776-7196

Sample Number: 44011651  
Description: GP-6-3 10-15'  
Sample Date: 5/13/2014  
Date Received: 5/15/2014

Parameter	Results	Units	Codes	LOD	LOQ	Method	Analyzed
CHROMIUM,TOTAL REC	23	ppm		0.45	1.5	SM3111D	05/20/14
HEX CHROME	1.35	ppm		0.223	0.736	SM3500CrD	06/04/14
SOLIDS DIGESTION	DONE			0	0	EPA200.2	05/19/14
TOTAL SOLIDS	88.2	%		0.01	0.01	SM2540B	06/07/14

Sample Number: 44011652  
Description: MW 21-1-A 0-5'  
Sample Date: 5/14/2014  
Date Received: 5/15/2014

Parameter	Results	Units	Codes	LOD	LOQ	Method	Analyzed
CHROMIUM,TOTAL REC	21	ppm		0.53	1.7	SM3111D	05/20/14
HEX CHROME	<0.229	ppm		0.229	0.756	SM3500CrD	06/04/14
SOLIDS DIGESTION	DONE			0	0	EPA200.2	05/19/14
TOTAL SOLIDS	81.9	%		0.01	0.01	SM2540B	06/07/14

Sample Number: 44011653  
Description: MW 21-A-2 5-10'  
Sample Date: 5/14/2014  
Date Received: 5/15/2014

Parameter	Results	Units	Codes	LOD	LOQ	Method	Analyzed
CHROMIUM,TOTAL REC	13	ppm		0.49	1.6	SM3111D	05/20/14
HEX CHROME	<0.224	ppm		0.224	0.739	SM3500CrD	06/04/14
SOLIDS DIGESTION	DONE			0	0	EPA200.2	05/19/14
TOTAL SOLIDS	86.1	%		0.01	0.01	SM2540B	06/07/14



# BADGER LABORATORIES & ENGINEERING INC.

501 WEST BELL STREET • NEENAH, WISCONSIN 54956-4868 • EST. 1966

(920) 729-1100 • FAX (920) 729-4945 • 1-800-776-7196

Sample Number: 44011654  
Description: MW 21-A-3 10-15'  
Sample Date: 5/14/2014  
Date Received: 5/15/2014

Parameter	Results	Units	Codes	LOD	LOQ	Method	Analyzed
CHROMIUM,TOTAL REC	18	ppm		0.41	1.4	SM3111D	05/20/14
HEX CHROME	<0.230	ppm		0.23	0.759	SM3500CrD	06/04/14
SOLIDS DIGESTION	DONE			0	0	EPA200.2	05/19/14
TOTAL SOLIDS	82.8	%		0.01	0.01	SM2540B	06/07/14

Sample Number: 44011655  
Description: MW 21-A-4 15-20'  
Sample Date: 5/14/2014  
Date Received: 5/15/2014

Parameter	Results	Units	Codes	LOD	LOQ	Method	Analyzed
CHROMIUM,TOTAL REC	15	ppm		0.5	1.65	SM3111D	05/20/14
HEX CHROME	<0.226	ppm		0.226	0.746	SM3500CrD	06/04/14
SOLIDS DIGESTION	DONE			0	0	EPA200.2	05/19/14
TOTAL SOLIDS	84.2	%		0.01	0.01	SM2540B	06/07/14

BADGER LABS & ENGINEERING  
WDNR Certified Lab #445023150  
Approved By:

JMW:dc

# BADGER LABORATORIES & ENGINEERING, INC.

501 WEST BELL STREET - NEENAH, WISCONSIN 54956-4868 - EST. 1966  
(920) 729-1100 - Fax (920) 729-4945 - 1-800-776-7196

**CHEMISTS**  
**ENGINEERS**

## SAMPLE RECEIPT FORM

### CLIENT INFORMATION

COMPANY: ALBANY  
 NAME: ALBANY  
 ADDRESS: 435 6th STREET  
MEENASHA WI 54952  
 PHONE: \_\_\_\_\_  
 P.O. #: \_\_\_\_\_  
 PROJECT/SITE: LOUATA - APPLETON  
 REPORT & BILL TO: RON BUCK  
 ADDITIONAL REPORTS TO: DAVE CASPER

**TURN AROUND TIME:**  
 Normal  
 Rush (Approval \_\_\_\_\_)  
*C August*

**SAMPLE TYPE:**  
 Groundwater  
 Wastewater  
 WPDES  
 Cooling Water  
 Drinking Water  
 Solid Waste  
 Oil  
 Other SOIL

Lab Filtered  
 Field Filtered  
 Grab  
 Composite  
 Flow Proportional  
 Time Proportional

CUSTOMER SAMPLE ID	SAMPLE DATETIME	DATE RECD	BL & E REPORT #	BL & E SAMPLE #	TEMP °	CONTAINER S	Ice Y/N	DELIVERY METHOD				PRESERVATION				ANALYTICAL REQUESTS	pH ok	EP
								BL&E	CLIENT	UPS	OTHER	PIF	PIL	NON-PRES	H2SO4			
MW20-A-1 D-5	5-13-14 15:11	5/15/14	998	11634	17	1	Y	PL										
MW20-A-2 5-18	5-13-14 15:20			11635	17	1												
MW20-A-3 10 L/S	5-13-14 15:28			11636	17	1												
MW20-A-4 15 L/S	5-13-14 15:36			11637	17	1												
MW20-A-5 20-25	5-13-14 15:55			11638	17	1												
MW20-A-6 25-30	5-13-14 16:10			11639	17	1												
MW20-A-7 35-40	5-13-14 16:25			11640	17	1												
MW20-A-7 30-35	5-13-14 16:18			11640	17	1												

### CHAIN OF CUSTODY RECORD

FILLED IN BY CUSTOMER SAMPLED BY: <u>DJC</u> DATETIME SAMPLED: <u>5-13-14</u> RELINQUISHED BY: <u>Dave Casper</u>	FILLED IN BY BADGER LABS & ENG RECEIVED BY: <u>DJC</u> DATETIME RECEIVED: <u>5/15/14</u> LOGGED IN: _____
--	--

\* Temperature over 4°C are above EPA/DNR Protocol unless received on ice.  
 \* EP = if pH was not correct, extra preservation was added until correct pH was achieved.  
 \* PIF = Preserved in field.  
 \* PIL = Preserved in lab.

**CHEMISTS**  
**ENGINEERS**

# BADGER LABORATORIES & ENGINEERING, INC.

501 WEST BELL STREET - NEENAH, WISCONSIN 54956-4868 - EST. 1966  
(920) 729-1100 - Fax (920) 729-4945 - 1-800-776-7196

## SAMPLE RECEIPT FORM

### CLIENT INFORMATION

COMPANY: ALBANY

NAME: ALBANY

ADDRESS: 435 6th STREET  
MEMASHA WI 54952

PHONE: \_\_\_\_\_

P.O. #: \_\_\_\_\_

PROJECT/SITE: LUVATA - APPLETON

REPORT & BILL TO: RON BUCK

ADDITIONAL REPORTS TO: DAVE CASPER

TURN AROUND TIME:  Normal  Rush (Approval \_\_\_\_\_)

SAMPLE TYPE:  Groundwater  Lab Filtered  
 Wastewater  Field Filtered  
 WPDES  Grab  
 Cooling Water  Composite  
 Drinking Water  Flow Proportional  
 Solid Waste  Time Proportional  
 Oil  Other SOIL

CUSTOMER SAMPLE ID	SAMPLE DATETIME	DATE RECD	BL & E REPORT #	BL & E SAMPLE #	TEMP °	CONTAINER S	JOB Y/N	DELIVERY METHOD			PRESERVATION				ANALYTICAL REQUESTS	pH ok	EP
								BL&E	CLIENT	UPS	OTHER	PIF	NON-PRES	H2SO4			
CP-1-2	5-13-14 11:55	5/15	4448	11648	7	1	X										
GP-1-1	5-13-14 12:00			11649		1											
GP-1-4	5-13-14 18:06			11649		1											
GP-3-1	5-13-14 18:40			11649		1											
GP-3-2	5-13-14 18:45			11649		1											
GP-3-4	5-13-14 18:58			11649		1											
GP-3-2	5-13-14 14:05			11649		1											
GP-6-1	5-13-14 14:30			11650		1											
GP-6-2	5-13-14 14:40			11650		1											
GP-10	5-13-14 14:44			11651		1											
GP-6-3	5-13-14 14:44			11651		1											

### CHAIN OF CUSTODY RECORD

FILLED IN BY CUSTOMER  
SAMPLED BY: DJC  
DATE/TIME SAMPLED: 5-13-14  
RELINQUISHED BY: [Signature]

FILLED IN BY BADGER LABS & ENG  
RECEIVED BY: [Signature]  
DATE/TIME RECEIVED: \_\_\_\_\_  
LOGGED IN: \_\_\_\_\_

\* Temperature over 4°C are above EPA/DNR Protocol unless received on ice.  
\* EP= If pH was not correct, extra preservation was added until correct pH was achieved.  
\* PIF= Preserved in field.  
\* PIL= Preserved in lab.

**CHEMISTS**

**ENGINEERS**

# BADGER LABORATORIES & ENGINEERING, INC.

501 WEST BELL STREET - NEENAH, WISCONSIN 54956-4868 - EST. 1966  
(920) 729-1100 - Fax (920) 729-4945 - 1-800-776-7196

## SAMPLE RECEIPT FORM

**CLIENT INFORMATION**

COMPANY: \_\_\_\_\_  
 NAME: ALBANY  
 ADDRESS: 435 6th STREET  
 NEENASHA WI 54952  
 PHONE: \_\_\_\_\_  
 P.O. #: \_\_\_\_\_  
 PROJECT/SITE: \_\_\_\_\_  
 REPORT & BILL TO: \_\_\_\_\_  
 ADDITIONAL REPORTS TO: \_\_\_\_\_

**TURN AROUND TIME:**

Normal  
 Rush (Approval \_\_\_\_\_)

**SAMPLE TYPE:**

Groundwater  Lab Filtered  
 Wastewater  Field Filtered  
 WPDES  Grab  
 Cooling Water  Composite  
 Drinking Water  Flow Proportional  
 Solid Waste  Time Proportional  
 Oil  
 Other SOIL

CUSTOMER SAMPLE ID	SAMPLE DATE/TIME	DATE RECD	BL & E REPORT #	BL & E SAMPLE #	TEMP	CONTAINER	JOB Y/N	DELIVERY METHOD				PRESERVATION				ANALYTICAL REQUESTS	PH OK	EP
								BL&E	CLIENT	UPS	OTHER	PIF	PIL	NON-PRES	H2SO4			
MW 21-A-1 0-5'	5-14-14 11:52	5/15/14	1928	1102	7	1	X											
MW 21-A-2 5-10'	5-14-14 11:58			1103	7	1												
MW 21-A-3 10-15'	5-14-14 12:05			1104	7	1												
MW 21-A-4 15-20'	5-14-14 12:10			1105	7	1												

**CHAIN OF CUSTODY RECORD**

FILLED IN BY CUSTOMER SAMPLED BY: <u>DFC</u> DATE/TIME SAMPLED: <u>5-14-14</u> RELINQUISHED BY: <u>[Signature]</u>	FILLED IN BY BADGER LABS & ENG RECEIVED BY: <u>[Signature]</u> DATE/TIME RECEIVED: _____ LOGGED IN: _____
---	--

\* Temperature over 4°C are above EPA/DNR Protocol unless received on ice.  
 \* EP= If pH was not correct, extra preservation was added until correct pH was achieved.  
 \* PIF= Preserved in field.  
 \* PIL= Preserved in lab.



# BADGER LABORATORIES & ENGINEERING INC.

501 WEST BELL STREET • NEENAH, WISCONSIN 54956-4868 • EST. 1966

(920) 729-1100 • FAX (920) 729-4945 • 1-800-776-7196

ALBANY INTERNATIONAL-APPLETON  
253 TROY RD  
RENSSELAER, NY 12144-

Report Number: 1405296  
Report Date: 7/11/2016  
Sampled By: BL&E

Attn:

PO#:   
# Samples: 1

Sample Number: 44011279  
Description: GP-13 TEMP  
WELL #13  
Sample Date: 5/12/2014  
Date Received: 5/12/2014

Parameter	Results	Units	Codes	LOD	LOQ	Method	Analyzed
CHROMIUM,TOTAL REC	2991	ug/l		30	100	SM3111D	05/23/14
HEX CHROME	1.6	mg/l		0.03	0.1	SM3500CrD	05/12/14
METALS DIGESTION	DONE			0	0	EPA200.2	05/23/14

BADGER LABS & ENGINEERING  
WDNR Certified Lab #445023150  
Approved By:

JMW:dc







# BADGER LABORATORIES & ENGINEERING INC.

501 WEST BELL STREET • NEENAH, WISCONSIN 54956-4868 • EST. 1966

(920) 729-1100 • FAX (920) 729-4945 • 1-800-776-7196

ALBANY INTERNATIONAL-APPLETON  
253 TROY RD  
RENSSELAER, NY 12144-

Report Number: 1405494  
Report Date: 7/11/2016  
Sampled By: CLIENT

Attn:

PO#:   
# Samples: 7

Sample Number: 44012829  
Description: MW-20  
Sample Date: 6/2/2014  
Date Received: 6/2/2014

Parameter	Results	Units	Codes	LOD	LOQ	Method	Analyzed
CHROMIUM,TOTAL REC	338	mg/l		7.9	26	SM3111D	06/02/14
HEX CHROME	338	mg/l		15	50	SM3500CrD	06/03/14

Sample Number: 44012830  
Description: MW-20A  
Sample Date: 6/2/2014  
Date Received: 6/2/2014

Parameter	Results	Units	Codes	LOD	LOQ	Method	Analyzed
CHROMIUM,TOTAL REC	1.2	mg/l		0.03	0.1	SM3111D	06/02/14
HEX CHROME	1.06	mg/l		0.03	0.1	SM3500CrD	06/03/14

Sample Number: 44012831  
Description: MW-21  
Sample Date: 6/2/2014  
Date Received: 6/2/2014

Parameter	Results	Units	Codes	LOD	LOQ	Method	Analyzed
CHROMIUM,TOTAL REC	0.0026	mg/l		0.0001	0.0003	SM3113D	06/17/14
HEX CHROME	<0.03	mg/l		0.03	0.1	SM3500CrD	06/03/14



# BADGER LABORATORIES & ENGINEERING INC.

501 WEST BELL STREET • NEENAH, WISCONSIN 54956-4868 • EST. 1966

(920) 729-1100 • FAX (920) 729-4945 • 1-800-776-7196

Sample Number: 44012832  
Description: MW-21A  
Sample Date: 6/2/2014  
Date Received: 6/2/2014

Parameter	Results	Units	Codes	LOD	LOQ	Method	Analyzed
CHROMIUM,TOTAL REC	0.0018	mg/l		0.0001	0.0003	SM3113D	06/17/20
HEX CHROME	<0.03	mg/l		0.03	0.1	SM3500CrD	06/03/14

Sample Number: 44012833  
Description: SUMP  
Sample Date: 6/2/2014  
Date Received: 6/2/2014

Parameter	Results	Units	Codes	LOD	LOQ	Method	Analyzed
CHROMIUM,TOTAL REC	7.0	mg/l		0.3	1	SM3111D	06/11/14
HEX CHROME	6.8	mg/l		0.6	2	SM3500CrD	06/03/14
METALS DIGESTION	DONE			0	0	EPA200.2	06/06/14

Sample Number: 44012834  
Description: MANHOLE  
Sample Date: 6/2/2014  
Date Received: 6/2/2014

Parameter	Results	Units	Codes	LOD	LOQ	Method	Analyzed
CHROMIUM,TOTAL REC	1.5	mg/l		0.03	0.1	SM3111D	06/02/14
HEX CHROME	1.5	mg/l		0.06	0.2	SM3500CrD	06/03/14
TURBIDITY-LAB	0.4	NTU		0	0	EPA180.1	06/03/14

Sample Number: 44012835  
Description: OUTFALL  
Sample Date: 6/2/2014  
Date Received: 6/2/2014

Parameter	Results	Units	Codes	LOD	LOQ	Method	Analyzed
CHROMIUM,TOTAL REC	0.04	mg/l		0.03	0.1	SM3111D	06/02/14
TURBIDITY-LAB	0.4	NTU		0	0	EPA180.1	06/03/14



# BADGER LABORATORIES & ENGINEERING INC.

501 WEST BELL STREET • NEENAH, WISCONSIN 54956-4868 • EST. 1966

(920) 729-1100 • FAX (920) 729-4945 • 1-800-776-7196

BADGER LABS & ENGINEERING  
WDNR Certified Lab #445023150  
Approved By:

JMW:dc





# BADGER LABORATORIES & ENGINEERING INC.

501 WEST BELL STREET • NEENAH, WISCONSIN 54956-4868 • EST. 1966

(920) 729-1100 • FAX (920) 729-4945 • 1-800-776-7196

ALBANY INTERNATIONAL-APPLETON  
253 TROY RD  
RENSSELAER, NY 12144-

Report Number: 1406724  
Report Date: 7/11/2016  
Sampled By: CLIENT

Attn:

PO#: 4500208835  
# Samples: 13

Sample Number: 44015840  
Description: SUMP  
Sample Date: 7/8/2014  
Date Received: 7/8/2014

Parameter	Results	Units	Codes	LOD	LOQ	Method	Analyzed
CHROMIUM,TOTAL REC	27	mg/l		0.27	0.89	SM3111D	07/18/14
HEX CHROME	27	mg/l		0.6	1.98	SM3500CrD	07/08/14
METALS DIGESTION	DONE			0	0	EPA200.2	07/16/14

Sample Number: 44015841  
Description: MANHOLE  
Sample Date: 7/8/2014  
Date Received: 7/8/2014

Parameter	Results	Units	Codes	LOD	LOQ	Method	Analyzed
CHROMIUM,TOTAL REC	3.8	mg/l		0.11	0.37	SM3111D	07/09/14
HEX CHROME	3.20	mg/l		0.06	0.198	SM3500CrD	07/08/14
TURBIDITY-LAB	0.3	NTU		0	0	EPA180.1	07/09/14

Sample Number: 44015842  
Description: MW-05  
Sample Date: 7/8/2014  
Date Received: 7/8/2014

Parameter	Results	Units	Codes	LOD	LOQ	Method	Analyzed
CHROMIUM, DISSOLVED	1.3	mg/l		0.03	0.1	SM3111D	07/09/14
HEX CHROME	1.18	mg/l		0.03	0.099	SM3500CrD	07/08/14



# BADGER LABORATORIES & ENGINEERING INC.

501 WEST BELL STREET • NEENAH, WISCONSIN 54956-4868 • EST. 1966

(920) 729-1100 • FAX (920) 729-4945 • 1-800-776-7196

Sample Number: 44015843  
Description: MW-05A  
Sample Date: 7/8/2014  
Date Received: 7/8/2014

Parameter	Results	Units	Codes	LOD	LOQ	Method	Analyzed
CHROMIUM, DISSOLVED	0.004	mg/l		0.0001	0	SM3113D	07/16/14
HEX CHROME	<0.003	mg/l		0.003	0.009	SM3500CrD	07/08/14

Sample Number: 44015844  
Description: MW-19  
Sample Date: 7/8/2014  
Date Received: 7/8/2014

Parameter	Results	Units	Codes	LOD	LOQ	Method	Analyzed
CHROMIUM, DISSOLVED	18	mg/l		0.3	1	SM3111D	07/09/14
HEX CHROME	17	mg/l		0.15	0.495	SM3500CrD	07/08/14

Sample Number: 44015845  
Description: MW-19A  
Sample Date: 7/8/2014  
Date Received: 7/8/2014

Parameter	Results	Units	Codes	LOD	LOQ	Method	Analyzed
CHROMIUM, DISSOLVED	0.0038	mg/l		0.0001	0.0003	SM3113D	07/16/14
HEX CHROME	<0.003	mg/l		0.003	0.009	SM3500CrD	07/08/14

Sample Number: 44015846  
Description: MW-20  
Sample Date: 7/8/2014  
Date Received: 7/8/2014

Parameter	Results	Units	Codes	LOD	LOQ	Method	Analyzed
CHROMIUM, DISSOLVED	283	mg/l		7.9	26	SM3111D	07/09/14
HEX CHROME	89	mg/l		0.6	1.98	SM3500CrD	07/08/14



# BADGER LABORATORIES & ENGINEERING INC.

501 WEST BELL STREET • NEENAH, WISCONSIN 54956-4868 • EST. 1966

(920) 729-1100 • FAX (920) 729-4945 • 1-800-776-7196

Sample Number: 44015847  
Description: MW-20A  
Sample Date: 7/8/2014  
Date Received: 7/8/2014

Parameter	Results	Units	Codes	LOD	LOQ	Method	Analyzed
CHROMIUM, DISSOLVED	0.23	mg/l		0.03	0.1	SM3111D	07/09/14
HEX CHROME	0.015	mg/l		0.003	0.009	SM3500CrD	07/08/14

Sample Number: 44015848  
Description: MW-200  
Sample Date: 7/8/2014  
Date Received: 7/8/2014

Parameter	Results	Units	Codes	LOD	LOQ	Method	Analyzed
CHROMIUM, DISSOLVED	301	mg/l		8.5	28	SM3111D	07/09/14
HEX CHROME	255	mg/l		3	9.9	SM3500CrD	07/08/14

Sample Number: 44015849  
Description: MW-21  
Sample Date: 7/8/2014  
Date Received: 7/8/2014

Parameter	Results	Units	Codes	LOD	LOQ	Method	Analyzed
CHROMIUM, DISSOLVED	0.21	mg/l		0.03	0.1	SM3111D	07/09/14
HEX CHROME	<0.003	mg/l		0.003	0.009	SM3500CrD	07/08/14

Sample Number: 44015850  
Description: MW-21A  
Sample Date: 7/8/2014  
Date Received: 7/8/2014

Parameter	Results	Units	Codes	LOD	LOQ	Method	Analyzed
CHROMIUM, DISSOLVED	0.0011	mg/l		0.0001	0.0003	SM3113D	07/16/14
HEX CHROME	<0.003	mg/l		0.003	0.009	SM3500CrD	07/08/14





# BADGER LABORATORIES & ENGINEERING INC.

501 WEST BELL STREET • NEENAH, WISCONSIN 54956-4868 • EST. 1966

(920) 729-1100 • FAX (920) 729-4945 • 1-800-776-7196

Sample Number: 44015851  
Description: 001 OUTFALL  
Sample Date: 7/8/2014  
Date Received: 7/8/2014

Parameter	Results	Units	Codes	LOD	LOQ	Method	Analyzed
CHROMIUM,TOTAL REC	0.36	mg/l		0.03	0.1	SM3111D	07/09/14
TURBIDITY-LAB	0.3	NTU		0	0	EPA180.1	07/09/14

Sample Number: 44015852  
Description: CANISTER A  
Sample Date: 7/8/2014  
Date Received: 7/8/2014

Parameter	Results	Units	Codes	LOD	LOQ	Method	Analyzed
CHROMIUM,TOTAL REC	2.2	mg/l		0.03	0.1	SM3111D	07/18/14
METALS DIGESTION	DONE			0	0	EPA200.2	07/16/14

BADGER LABS & ENGINEERING  
WDNR Certified Lab #445023150  
Approved By:

JMW:dc



# BADGER LABORATORIES & ENGINEERING CO., INC.

## SAMPLE RECEIPT FORM

### CLIENT INFORMATION

COMPANY: Albany International  
 NAME: 253 Troy Road  
 ADDRESS: Rensselaer, NY 12144  
 PHONE/FAX: 4500 208835  
 P.O. #: Appl. Chem. Site  
 PROJECT/SITE: Monthly Billing No Report To Albany  
 REPORT & BILL TO: John Stogger & DJC  
 ADDITIONAL REPORTS TO:

### TURN AROUND TIME:

Normal  
 Rush (Approval \_\_\_\_\_)

### SAMPLE TYPE:

Groundwater  
 Wastewater  
 WPDES  
 Cooling Water  
 Drinking Water  
 Solid Waste  
 Oil  
 Other \_\_\_\_\_

Lab Filtered  
 Field Filtered  
 Grab  
 Composite  
 Flow Proportional  
 Time Proportional

CUSTOMER SAMPLE ID	SAMPLE DATETIME	DATE RECD	BL & E REPORT #	BL & E SAMPLE #	TEMP	# OF CONTAINERS	IN Y/N	DELIVERY METHOD				PRESERVATION				ANALYTICAL REQUESTS	PH OK	EP		
								BL/IE	CLIENT	UFS	OTHER	PIF	PIL	NON PRES	MS00				MS03	MS04
MU-21	7/18/14 9:15 am	7/18/14	604	15840	7	2	Y	X					X					Total Hex Chlorine		
MU-21A				15850	7	2	Y	X					X					Total Chlorine		
Outfall out				15851	7	1	Y	X					X							
Conster A				15852	7	1	Y	X					X							

### CHAIN OF CUSTODY RECORD

FILLED IN BY CUSTOMER SAMPLED BY: <u>John Stogger</u> DATE/TIME SAMPLED: <u>7/18/14 9:15 am</u> RELINQUISHED BY: <u>[Signature]</u>	FILLED IN BY BADGER LABS & ENG RECEIVED BY: <u>[Signature]</u> DATE/TIME RECEIVED: <u>JUL 08 2014 14:40</u> LOGGED IN: <u>[Signature]</u>
--	--

- \* Temperature over 6°C are above EPA/DNR Protocol unless received on ice.
- \* EP= If pH was not correct, extra preservation was added until correct pH was achieved.
- \* PIF= Preserved in field.
- \* PIL= Preserved in lab.

## Monitoring Well Construction Forms

Facility/Project Name Former Albany Intrn'l Chrome Plan	Local Grid Location of Well 55.5 ft. <input checked="" type="checkbox"/> N. 40 ft. <input checked="" type="checkbox"/> E. <input type="checkbox"/> S. <input type="checkbox"/> W.	Well Name MW-20
Facility License, Permit or Monitoring No. 0245000015	Local Grid Origin <input checked="" type="checkbox"/> (estimated: <input type="checkbox"/> ) or Well Location <input type="checkbox"/> Lat. 44° 16' 9.3" Long. 88° 23' 43" or	Wis. Unique Well No. VN452 DNR Well ID No.
Facility ID 445035910	St. Plane _____ ft. N, _____ ft. E. S/C/N	Date Well Installed 05 / 14 / 2014 m m d d y y y y
Type of Well Well Code 11 / mw	Section Location of Waste/Source SW 1/4 of NW 1/4 of Sec. 25, T. 21 N, R. 17 <input checked="" type="checkbox"/> E <input type="checkbox"/> W	Well Installed By: Name (first, last) and Firm Tony Kapugi
Distance from Waste/Source _____ ft.	Location of Well Relative to Waste/Source u <input type="checkbox"/> Upgradient s <input checked="" type="checkbox"/> Sidegradient d <input type="checkbox"/> Downgradient n <input type="checkbox"/> Not Known	On-site Environmental
Enf. Stds. Apply <input checked="" type="checkbox"/>	Gov. Lot Number 11	

- A. Protective pipe, top elevation -- 768.67 ft. MSL
- B. Well casing, top elevation -- 768.36 ft. MSL
- C. Land surface elevation -- 768.67 ft. MSL
- D. Surface seal, bottom -- 768.2 ft. MSL or \_\_\_\_\_ ft.

12. USCS classification of soil near screen:  
 GP  GM  GC  GW  SW  SP   
 SM  SC  ML  MH  CL  CH   
 Bedrock


13. Sieve analysis performed?  Yes  No

14. Drilling method used: Rotary  50  
 Hollow Stem Auger  41  
 Other

15. Drilling fluid used: Water  02 Air  01  
 Drilling Mud  03 None  99

16. Drilling additives used?  Yes  No  
 Describe \_\_\_\_\_

17. Source of water (attach analysis, if required):  
 \_\_\_\_\_

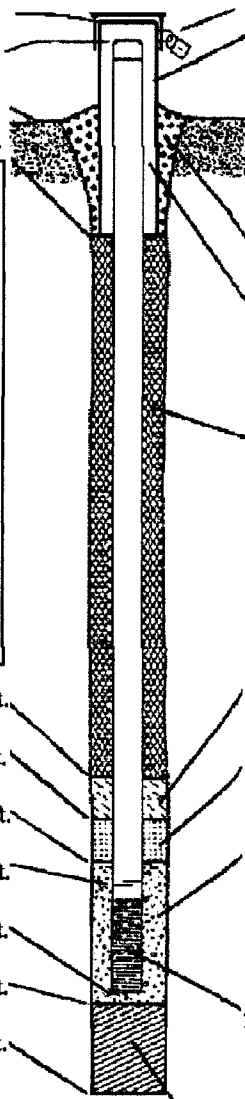

- 1. Cap and lock?  Yes  No
- 2. Protective cover pipe:
  - a. Inside diameter: 8 in.
  - b. Length: 1.5 ft.
  - c. Material: Steel  04  
Morrison Flush Mount HD  Other
  - d. Additional protection?  Yes  No  
If yes, describe: \_\_\_\_\_
- 3. Surface seal: Bentonite  30  
Concrete  01  
Other
- 4. Material between well casing and protective pipe: Bentonite  30  
Other
- 5. Annular space seal:
  - a. Granular/Chipped Bentonite  33
  - b. \_\_\_\_\_ Lbs/gal mud weight... Bentonite-sand slurry  35
  - c. \_\_\_\_\_ Lbs/gal mud weight... Bentonite slurry  31
  - d. \_\_\_\_\_ % Bentonite... Bentonite-cement grout  50
  - e. 2.5 Ft<sup>3</sup> volume added for any of the above
  - f. How installed: Tremie  01  
Tremie pumped  02  
Gravity  08
- 6. Bentonite seal:
  - a. Bentonite granules  33
  - b.  1/4 in.  3/8 in.  1/2 in. Bentonite chips  32
  - c. \_\_\_\_\_ Other
- 7. Fine sand material: Manufacturer, product name & mesh size  
 a. Sidley #5000  
 b. Volume added 0.75 ft<sup>3</sup>
- 8. Filter pack material: Manufacturer, product name & mesh size  
 a. Sidley #5  
 b. Volume added 3.75 ft<sup>3</sup>
- 9. Well casing: Flush threaded PVC schedule 40  23  
 Flush threaded PVC schedule 80  24  
 PVC  Other
- 10. Screen material:
  - a. Screen type: Factory cut  11  
Continuous slot  01  
Monoflex  Other
  - b. Manufacturer \_\_\_\_\_
  - c. Slot size: 0.01 in.
  - d. Slotted length: 10 ft.
- 11. Backfill material (below filter pack): None  14  
Other

- E. Bentonite seal, top -- 768.2 ft. MSL or \_\_\_\_\_ ft.
- F. Fine sand, top -- 767.7 ft. MSL or \_\_\_\_\_ ft.
- G. Filter pack, top -- 766.7 ft. MSL or \_\_\_\_\_ ft.
- H. Screen joint, top -- 764.7 ft. MSL or \_\_\_\_\_ ft.
- I. Well bottom -- 754.7 ft. MSL or \_\_\_\_\_ ft.
- J. Filter pack, bottom -- 754.4 ft. MSL or \_\_\_\_\_ ft.
- K. Borehole, bottom -- 753.7 ft. MSL or \_\_\_\_\_ ft.
- L. Borehole, diameter -- 8.5 in.
- M. O.D. well casing -- 2.38 in.
- N. I.D. well casing -- 2.05 in.

I hereby certify that the information on this form is true and correct to the best of my knowledge.

Signature: *David J. Kapugi* Firm: Badger Laboratories and Engineering Inc.

Please complete both Forms 4400-113A and 4400-113B and return them to the appropriate DNR office and bureau. Completion of these reports is required by chs. 160, 281, 283, 289, 291, 292, 293, 295, and 299, Wis. Stats., and ch. NR 141, Wis. Adm. Code. In accordance with chs. 281, 289, 291, 292, 293, 295, and 299, Wis. Stats., failure to file these forms may result in a forfeiture of between \$10 and \$25,000, or imprisonment for up to one year, depending on the program and conduct involved. Personally identifiable information on these forms is not intended to be used for any other purpose. NOTE: See the instructions for more information, including where the completed forms should be sent.

Facility/Project Name Former Albany Intrn'l Chrome Plan	Local Grid Location of Well 53.4 ft. <input checked="" type="checkbox"/> N. 42 ft. <input checked="" type="checkbox"/> E. <input type="checkbox"/> S. <input type="checkbox"/> W.	Well Name MW-20-A
Facility License, Permit or Monitoring No. 0245000015	Local Grid Origin <input checked="" type="checkbox"/> (estimated: <input type="checkbox"/> ) or Well Location <input type="checkbox"/> Lat. 44° 13' 9.3" Long. 88° 23' 43" or	Wis. Unique Well No. VN453 DNR Well ID No.
Facility ID 445035910	St. Plane _____ ft. N. _____ ft. E. S/C/N	Date Well Installed 05 / 14 / 2014 m m d d / y y y y
Type of Well Well Code 12 / pz	Section Location of Waste/Source SW 1/4 of NW 1/4 of Sec. 25, T. 21 N, R. 17 <input checked="" type="checkbox"/> E. <input type="checkbox"/> W.	Well Installed By: Name (first, last) and Firm Tony Kapugi
Distance from Waste/Source _____ ft.	Location of Well Relative to Waste/Source u <input type="checkbox"/> Upgradient s <input checked="" type="checkbox"/> Sidegradient d <input type="checkbox"/> Downgradient n <input type="checkbox"/> Not Known	Gov. Lot Number 11
Enf. Stds. Apply <input checked="" type="checkbox"/>		On-site Environmental

- A. Protective pipe, top elevation -- 768.67 ft. MSL
- B. Well casing, top elevation -- 768.29 ft. MSL
- C. Land surface elevation -- 768.67 ft. MSL
- D. Surface seal, bottom -- 762.5 ft. MSL or 3 ft.

12. USCS classification of soil near screen:  
 GP  GM  GC  GW  SW  SP   
 SM  SC  ML  MH  CL  CH   
 Bedrock

13. Sieve analysis performed?  Yes  No


14. Drilling method used: Rotary  50  
 Hollow Stem Auger  41  
 Other

15. Drilling fluid used: Water  02 Air  01  
 Drilling Mud  03 None  99

16. Drilling additives used?  Yes  No

Describe \_\_\_\_\_

17. Source of water (attach analysis, if required): \_\_\_\_\_

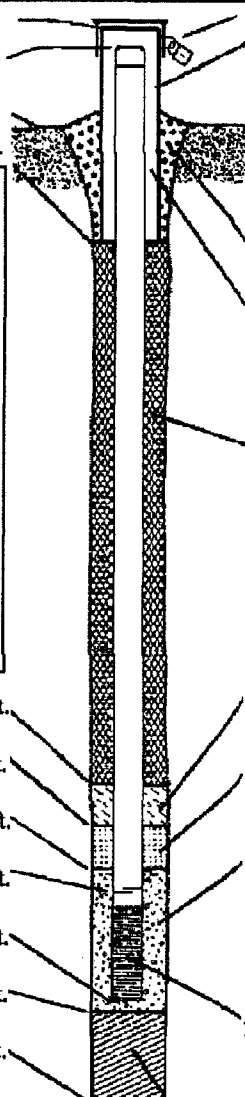

- 1. Cap and lock?  Yes  No
- 2. Protective cover pipe:
  - a. Inside diameter: 8. in.
  - b. Length: 1.5 ft.
  - c. Material: Steel  04  
Other
  - d. Additional protection?  Yes  No  
If yes, describe: Morrison HD Flush Mount
- 3. Surface seal: Bentonite  30  
Concrete  01  
Other
- 4. Material between well casing and protective pipe: Bentonite  30  
Other
- 5. Annular space seal:
  - a. Granular/Chipped Bentonite  33
  - b. \_\_\_\_\_ Lbs/gal mud weight... Bentonite-sand slurry  35
  - c. \_\_\_\_\_ Lbs/gal mud weight... Bentonite slurry  31
  - d. \_\_\_\_\_ % Bentonite... Bentonite-cement grout  50
  - e. 8 Ft<sup>3</sup> volume added for any of the above
  - f. How installed: Tremie  01  
Tremie pumped  02  
Gravity  08
- 6. Bentonite seal:
  - a. Bentonite granules  33
  - b.  1/4 in.  3/8 in.  1/2 in. Bentonite chips  32
  - c. Other
- 7. Fine sand material: Manufacturer, product name & mesh size  
 a. Sidley 5000  
 b. Volume added 0.5 ft<sup>3</sup>
- 8. Filter pack material: Manufacturer, product name & mesh size  
 a. Sidley #5  
 b. Volume added 3.5 ft<sup>3</sup>
- 9. Well casing: Flush threaded PVC schedule 40  23  
 Flush threaded PVC schedule 80  24  
 PVC Other
- 10. Screen material:
  - a. Screen type: Factory cut  11  
Continuous cut  01  
Other
  - b. Manufacturer Monoflex
  - c. Slot size: 0.01 in.
  - d. Slotted length: 5 ft.
- 11. Backfill material (below filter pack): None  14  
Other

I hereby certify that the information on this form is true and correct to the best of my knowledge.

Signature David Kapugi Firm Badger Laboratories and Engineering Inc.

Please complete both Forms 4400-113A and 4400-113B and return them to the appropriate DNR office and bureau. Completion of these reports is required by chs. 160, 281, 283, 289, 291, 292, 293, 295, and 299, Wis. Stats., and ch. NR 141, Wis. Adm. Code. In accordance with chs. 281, 289, 291, 292, 293, 295, and 299, Wis. Stats., failure to file these forms may result in a forfeiture of between \$10 and \$25,000, or imprisonment for up to one year, depending on the program and conduct involved. Personally identifiable information on these forms is not intended to be used for any other purpose. NOTE: See the instructions for more information, including where the completed forms should be sent.

Facility/Project Name Former Albany Intrn'l Chrome Plan	Local Grid Location of Well 21.58 ft. <input checked="" type="checkbox"/> N. 153.66 ft. <input checked="" type="checkbox"/> E. <input type="checkbox"/> S. <input type="checkbox"/> W.	Well Name MW-21
Facility License, Permit or Monitoring No. 0245000015	Local Grid Origin <input checked="" type="checkbox"/> (estimated: <input type="checkbox"/> ) or Well Location <input type="checkbox"/> Lat. 44° 16' 9.3" Long. 88° 23' 43" or	Wis. Unique Well No. <u>VN450</u> DNR Well ID No. _____
Facility ID 445035910	St. Plane _____ ft. N. _____ ft. E. S/C/N	Date Well Installed <u>05</u> / <u>14</u> / <u>2014</u> m m d d y y v v y
Type of Well Well Code <u>11</u> / mw	Section Location of Waste/Source SW 1/4 of NW 1/4 of Sec. <u>25</u> , T. <u>21</u> N, R. <u>17</u> <input checked="" type="checkbox"/> E <input type="checkbox"/> W	Well Installed By: Name (first, last) and Firm Tony Kapugi
Distance from Waste/Source <u>125</u> ft.	Location of Well Relative to Waste/Source u <input checked="" type="checkbox"/> Upgradient s <input type="checkbox"/> Sidegradient d <input type="checkbox"/> Downgradient n <input type="checkbox"/> Not Known	Gov. Lot Number <u>11</u>
Enf. Stds. Apply <input checked="" type="checkbox"/>		On-site Environmental

- A. Protective pipe, top elevation 769.19 ft. MSL
- B. Well casing, top elevation 768.85 ft. MSL
- C. Land surface elevation 769.19 ft. MSL
- D. Surface seal, bottom 767.7 ft. MSL or \_\_\_\_\_ ft.

12. USCS classification of soil near screen:  
 GP  GM  GC  GW  SW  SP   
 SM  SC  ML  MH  CL  CH   
 Bedrock

13. Sieve analysis performed?  Yes  No


14. Drilling method used: Rotary  50  
 Hollow Stem Auger  41  
 Other

15. Drilling fluid used: Water  02 Air  01  
 Drilling Mud  03 None  99

16. Drilling additives used?  Yes  No

Describe \_\_\_\_\_

17. Source of water (attach analysis, if required):  
 \_\_\_\_\_

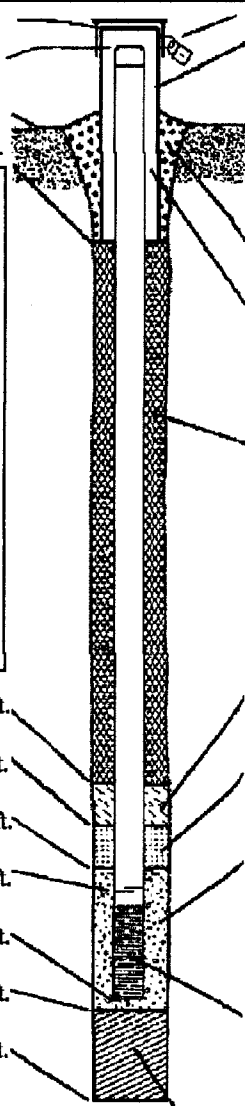

- 1. Cap and lock?  Yes  No
- 2. Protective cover pipe:
  - a. Inside diameter: 8 in.
  - b. Length: 1.5 ft.
  - c. Material: Steel  04  
Other
  - d. Additional protection?  Yes  No  
If yes, describe: Morrison HD Flush Mount
- 3. Surface seal: Bentonite  30  
Concrete  01  
Other
- 4. Material between well casing and protective pipe: Bentonite  30  
Other
- 5. Annular space seal:
  - a. Granular/Chipped Bentonite  33
  - b. \_\_\_\_\_ Lbs/gal mud weight ... Bentonite-sand slurry  35
  - c. \_\_\_\_\_ Lbs/gal mud weight ... Bentonite slurry  31
  - d. \_\_\_\_\_ % Bentonite ... Bentonite-cement grout  50
  - e. \_\_\_\_\_ Ft<sup>3</sup> volume added for any of the above
  - f. How installed: Tremie  01  
Tremie pumped  02  
Gravity  08
- 6. Bentonite seal:
  - a. Bentonite granules  33
  - b.  1/4 in.  3/8 in.  1/2 in. Bentonite chips  32
  - c. \_\_\_\_\_ Other
- 7. Fine sand material: Manufacturer, product name & mesh size  
a. Sidley 5000
- b. Volume added \_\_\_\_\_ ft<sup>3</sup>
- 8. Filter pack material: Manufacturer, product name & mesh size  
a. Sidley #5
- b. Volume added \_\_\_\_\_ ft<sup>3</sup>
- 9. Well casing: Flush threaded PVC schedule 40  23  
Flush threaded PVC schedule 80  24  
PVC Other
- 10. Screen material:
  - a. Screen type: Factory cut  11  
Continuous slot  01  
Other
  - b. Manufacturer Monoflex
  - c. Slot size: 0.01 in.
  - d. Slotted length: 10 ft.
- 11. Backfill material (below filter pack): None  14  
Other

- E. Bentonite seal, top 767.7 ft. MSL or \_\_\_\_\_ ft.
- F. Fine sand, top 766.7 ft. MSL or \_\_\_\_\_ ft.
- G. Filter pack, top 765.7 ft. MSL or \_\_\_\_\_ ft.
- H. Screen joint, top 765.2 ft. MSL or \_\_\_\_\_ ft.
- I. Well bottom 755.2 ft. MSL or \_\_\_\_\_ ft.
- J. Filter pack, bottom 755.2 ft. MSL or \_\_\_\_\_ ft.
- K. Borehole, bottom 754.7 ft. MSL or \_\_\_\_\_ ft.
- L. Borehole, diameter 8.5 in.
- M. O.D. well casing 2.38 in.
- N. I.D. well casing 2.05 in.

I hereby certify that the information on this form is true and correct to the best of my knowledge.

Signature [Signature] Firm Badger Laboratories and Engineering Inc.

Please complete both Forms 4400-113A and 4400-113B and return them to the appropriate DNR office and bureau. Completion of these reports is required by chs. 160, 281, 283, 289, 291, 292, 293, 295, and 299, Wis. Stats., and ch. NR 141, Wis. Adm. Code. In accordance with chs. 281, 289, 291, 292, 293, 295, and 299, Wis. Stats., failure to file these forms may result in a forfeiture of between \$10 and \$25,000, or imprisonment for up to one year, depending on the program and conduct involved. Personally identifiable information on these forms is not intended to be used for any other purpose. NOTE: See the instructions for more information, including where the completed forms should be sent.

Facility/Project Name Former Albany Intrn'l Chrome Plan	Local Grid Location of Well 21.2 ft <input checked="" type="checkbox"/> N. 151.1 ft <input checked="" type="checkbox"/> E. <input type="checkbox"/> S. <input type="checkbox"/> W.	Well Name MW21-A
Facility License, Permit or Monitoring No. 0245000015	Local Grid Origin <input checked="" type="checkbox"/> (estimated: <input type="checkbox"/> ) or Well Location <input type="checkbox"/> Lat. 44° 16' 9.25" Long. 88° 23' 42.6" or	Wis. Unique Well No. VN451 DNR Well ID No.
Facility ID 445035910	St. Plane _____ ft. N. _____ ft. E. S/C/N	Date Well Installed 05 / 14 / 2014 m m d d y y y y
Type of Well Well Code 12 / pz	Section Location of Waste/Source SW 1/4 of NW 1/4 of Sec. 25, T. 21 N, R. 17 <input checked="" type="checkbox"/> E. <input type="checkbox"/> W.	Well Installed By: Name (first, last) and Firm Tony Kapugi
Distance from Waste/Source 125 ft. Inf. Stds. Apply <input checked="" type="checkbox"/>	Location of Well Relative to Waste/Source u <input checked="" type="checkbox"/> Upgradient s <input type="checkbox"/> Sidegradient d <input type="checkbox"/> Downgradient n <input type="checkbox"/> Not Known	On-site Environmental

- A. Protective pipe, top elevation -- 769.2 -- ft. MSL
- B. Well casing, top elevation -- 768.85 -- ft. MSL
- C. Land surface elevation -- 769.2 -- ft. MSL
- D. Surface seal, bottom -- 767.7 -- ft. MSL or \_\_\_\_\_ ft.

12. USCS classification of soil near screen:  
 GP  GM  GC  GW  SW  SP   
 SM  SC  ML  MH  CL  CH   
 Bedrock


13. Sieve analysis performed?  Yes  No

14. Drilling method used: Rotary  5 0  
 Hollow Stem Auger  4 1  
 Other

15. Drilling fluid used: Water  0 2 Air  0 1  
 Drilling Mud  0 3 None  9 9

16. Drilling additives used?  Yes  No  
 Describe \_\_\_\_\_

17. Source of water (attach analysis, if required):  
 \_\_\_\_\_

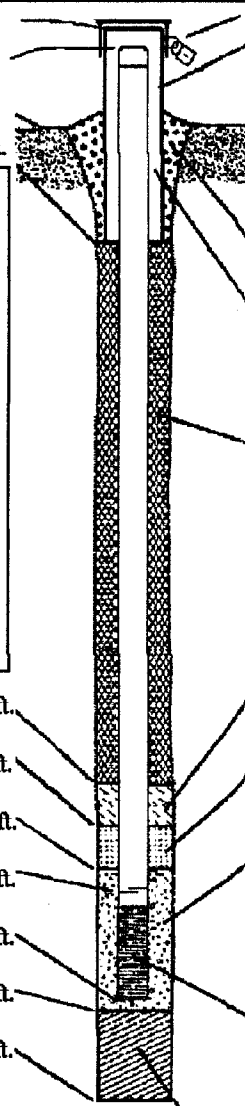

- 1. Cap and lock?  Yes  No
- 2. Protective cover pipe:
  - a. Inside diameter: 8 -- in.
  - b. Length: 1.5 -- ft.
  - c. Material: Steel  0 4  
Other
  - d. Additional protection?  Yes  No  
If yes, describe: Morrison HD Flush Mount
- 3. Surface seal: Bentonite  3 0  
Concrete  0 1  
Other
- 4. Material between well casing and protective pipe: Bentonite  3 0  
Other
- 5. Annular space seal:
  - a. Granular/Chipped Bentonite  3 3
  - b. \_\_\_\_\_ Lbs/gal mud weight ... Bentonite-sand slurry  3 5
  - c. \_\_\_\_\_ Lbs/gal mud weight ... Bentonite slurry  3 1
  - d. \_\_\_\_\_ % Bentonite ... Bentonite-cement grout  5 0
  - e. \_\_\_\_\_ Ft<sup>3</sup> volume added for any of the above
  - f. How installed: Tremie  0 1  
Tremie pumped  0 2  
Gravity  0 8
- 6. Bentonite seal:
  - a. Bentonite granules  3 3
  - b.  1/4 in.  3/8 in.  1/2 in. Bentonite chips  3 2
  - c. \_\_\_\_\_ Other
- 7. Fine sand material: Manufacturer, product name & mesh size  
 a. Sidley #5000  
 b. Volume added \_\_\_\_\_ ft<sup>3</sup>
- 8. Filter pack material: Manufacturer, product name & mesh size  
 a. Sidley #5  
 b. Volume added \_\_\_\_\_ ft<sup>3</sup>
- 9. Well casing: Flush threaded PVC schedule 40  2 3  
 Flush threaded PVC schedule 80  2 4  
 Other
- 10. Screen material:
  - a. Screen type: Factory cut  1 1  
Continuous slot  0 1  
Monofles \_\_\_\_\_ Other
  - b. Manufacturer \_\_\_\_\_
  - c. Slot size: 0.01 in.
  - d. Slotted length: 5 -- ft.
- 11. Backfill material (below filter pack): None  1 4  
Other

- E. Bentonite seal, top -- 767.7 -- ft. MSL or \_\_\_\_\_ ft.
- F. Fine sand, top -- 741.5 -- ft. MSL or \_\_\_\_\_ ft.
- G. Filter pack, top -- 739.3 -- ft. MSL or \_\_\_\_\_ ft.
- H. Screen joint, top -- 737.2 -- ft. MSL or \_\_\_\_\_ ft.
- I. Well bottom -- 735.2 -- ft. MSL or \_\_\_\_\_ ft.
- J. Filter pack, bottom -- 732.7 -- ft. MSL or \_\_\_\_\_ ft.
- K. Borehole, bottom -- 731.2 -- ft. MSL or \_\_\_\_\_ ft.
- L. Borehole, diameter -- 8.25 -- in.
- M. O.D. well casing -- 2.12 -- in.
- N. I.D. well casing -- 2.05 -- in.

I hereby certify that the information on this form is true and correct to the best of my knowledge.

Signature *David J. Capri* Firm Badger Laboratories and Engineering Inc.

Please complete both forms 4400-113A and 4400-113B and return them to the appropriate DNR office and bureau. Completion of these reports is required by chs. 160, 281, 283, 289, 291, 292, 293, 295, and 299, Wis. Stats., and ch. NR 141, Wis. Adm. Code. In accordance with chs. 281, 289, 291, 292, 293, 295, and 299, Wis. Stats., failure to file these forms may result in a forfeiture of between \$10 and \$25,000, or imprisonment for up to one year, depending on the program and conduct involved. Personally identifiable information on these forms is not intended to be used for any other purpose. NOTE: See the instructions for more information, including where the completed forms should be sent.



## Monitoring Well Development Forms

Route to: Watershed/Wastewater  Waste Management   
Remediation/Redevelopment  Other

Facility/Project Name Former Albany Intrn'l Chrome Plant	County Name OUTAGAMIE	Well Name MW-20
Facility License, Permit or Monitoring Number 0245000015	County Code 45	Wis. Unique Well Number VN452
		DNR Well ID Number _____

1. Can this well be purged dry?  Yes  No
2. Well development method
- surged with bailer and bailed  4 1
  - surged with bailer and pumped  6 1
  - surged with block and bailed  4 2
  - surged with block and pumped  6 2
  - surged with block, bailed and pumped  7 0
  - compressed air  2 0
  - bailed only  1 0
  - pumped only  5 1
  - pumped slowly  5 0
  - Other  \_\_\_\_\_
3. Time spent developing well 97 min.
4. Depth of well (from top of well casing) 13.9 ft.
5. Inside diameter of well 2.05 in.
6. Volume of water in filter pack and well casing 1.3 gal.
7. Volume of water removed from well 14 gal.
8. Volume of water added (if any) \_\_\_\_\_ gal.
9. Source of water added NA
10. Analysis performed on water added?  Yes  No  
(If yes, attach results)

	Before Development	After Development
11. Depth to Water (from top of well casing)	a. <u>6.03</u> ft.	<u>13.43</u> ft.
Date	b. <u>05 / 28 / 2014</u>	<u>05 / 28 / 2014</u>
Time	c. <u>13 : 53</u> <input type="checkbox"/> a.m. <input type="checkbox"/> p.m.	<u>15 : 30</u> <input type="checkbox"/> a.m. <input type="checkbox"/> p.m.
12. Sediment in well bottom	<u>0.2</u> inches	_____ inches
13. Water clarity	Clear <input type="checkbox"/> 1 0 Turbid <input checked="" type="checkbox"/> 1 5 (Describe) <u>Chrome stained</u> <u>yellow Very</u> <u>little sediment</u> <u>except for PVC</u> <u>cuttings from</u> <u>well construction</u>	Clear <input type="checkbox"/> 2 0 Turbid <input checked="" type="checkbox"/> 2 5 (Describe) <u>Slightly turbid,</u> <u>sandy brown</u>

Fill in if drilling fluids were used and well is at solid waste facility:

14. Total suspended solids \_\_\_\_\_ mg/l \_\_\_\_\_ mg/l

15. COD \_\_\_\_\_ mg/l \_\_\_\_\_ mg/l

16. Well developed by: Name (first, last) and Firm

First Name: David Last Name: Casper

Firm: Badger Laboratories and Engineering Inc.

17. Additional comments on development:  
Highly stained yellow (Chrome) Very little sediment except for some small bits of PVC that fell down well when riser pipe was trimmed to length during installation. Water rise about 0.01ft/20 seconds on recharge

Name and Address of Facility Contact /Owner/Responsible Party


First Name: JP Last Name: Hammerton

Facility/Firm: Albany International

Street: 3601 Electric City Blvd.

City/State/Zip: Kaukauna WI 54130-

I hereby certify that the above information is true and correct to the best of my knowledge.

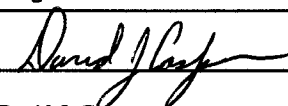Signature: 

Print Name: David J. Casper

Firm: Badger Laboratories and Engineering Inc.

NOTE: See instructions for more information including a list of county codes and well type codes.

Route to: Watershed/Wastewater  Waste Management   
Remediation/Redevelopment  Other

Facility/Project Name Former Albany Intrn'l Chrome Plant	County Name OUTAGAMIE	Well Name MW-20-A
Facility License, Permit or Monitoring Number 0245000015	County Code .45	Wis. Unique Well Number VN453
		DNR Well ID Number _____

1. Can this well be purged dry?  Yes  No

2. Well development method

surged with bailer and bailed	<input checked="" type="checkbox"/> 4 1
surged with bailer and pumped	<input type="checkbox"/> 6 1
surged with block and bailed	<input type="checkbox"/> 4 2
surged with block and pumped	<input type="checkbox"/> 6 2
surged with block, bailed and pumped	<input type="checkbox"/> 7 0
compressed air	<input type="checkbox"/> 2 0
bailed only	<input type="checkbox"/> 1 0
pumped only	<input type="checkbox"/> 5 1
pumped slowly	<input type="checkbox"/> 5 0
Other _____	<input type="checkbox"/> _____

3. Time spent developing well 127 min.

4. Depth of well (from top of well casing) 34.3 ft.

5. Inside diameter of well 2.05 in.

6. Volume of water in filter pack and well casing 0.4 gal.

7. Volume of water removed from well 4.2 gal.

8. Volume of water added (if any) \_\_\_\_\_ gal.

9. Source of water added \_\_\_\_\_

10. Analysis performed on water added?  Yes  No  
(If yes, attach results)

	Before Development	After Development
11. Depth to Water (from top of well casing)	a. <u>31.7</u> ft.	<u>34.02</u> ft.
Date	b. <u>05 / 28 / 2014</u> m m d d y y y y	<u>05 / 28 / 2014</u> m m d d y y y y
Time	c. <u>13 : 58</u> <input type="checkbox"/> a.m. <input type="checkbox"/> p.m.	<u>16 : 05</u> <input type="checkbox"/> a.m. <input type="checkbox"/> p.m.
12. Sediment in well bottom	<u>0.2</u> inches	_____ inches
13. Water clarity	Clear <input type="checkbox"/> 1 0 Turbid <input checked="" type="checkbox"/> 1 5 (Describe) <u>Highly turbid</u> (brown sandy clay)	Clear <input type="checkbox"/> 2 0 Turbid <input type="checkbox"/> 2 5 (Describe) <u>Slightly turbid</u> (brown sandy clay)
Fill in if drilling fluids were used and well is at solid waste facility:		
14. Total suspended solids	_____ mg/l	_____ mg/l
15. COD	_____ mg/l	_____ mg/l
16. Well developed by: Name (first, last) and Firm		
First Name:	David	Last Name: Casper
Firm:	Badger Laboratories and Engineering Inc.	

17. Additional comments on development:  
High initial turbidity (first 3 bailers), then significant reduction. Bailed to dry after each 0.5 gallon but recovered to full bailer depth (1000 ml) in about 15 minutes each time.

Name and Address of Facility Contact /Owner/Responsible Party


First Name: JP Last Name: Hammerton

Facility/Firm: Albany International

Street: 3601 Electric City Blvd.

City/State/Zip: Kaukauna WI 54130-

I hereby certify that the above information is true and correct to the best of my knowledge.

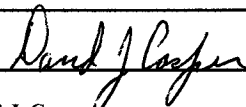Signature: 

Print Name: David J. Casper

Firm: Badger Laboratories and Engineering Inc.

NOTE: See instructions for more information including a list of county codes and well type codes.

Route to: Watershed/Wastewater  Waste Management   
Remediation/Redevelopment  Other

Facility/Project Name Former Albany Intrn'l Chrome Plant	County Name OUTAGAMIE	Well Name MW-21
Facility License, Permit or Monitoring Number 0245000015	County Code 45	Wis. Unique Well Number VN450
		DNR Well ID Number _____

1. Can this well be purged dry?  Yes  No
2. Well development method
- surged with bailer and bailed  41
  - surged with bailer and pumped  61
  - surged with block and bailed  42
  - surged with block and pumped  62
  - surged with block, bailed and pumped  70
  - compressed air  20
  - bailed only  10
  - pumped only  51
  - pumped slowly  50
  - Other  \_\_\_\_\_
3. Time spent developing well 161 min.
4. Depth of well (from top of well casing) 14 ft.
5. Inside diameter of well 2.05 in.
6. Volume of water in filter pack and well casing 1.5 gal.
7. Volume of water removed from well 15.2 gal.
8. Volume of water added (if any) \_\_\_\_\_ gal.
9. Source of water added \_\_\_\_\_
10. Analysis performed on water added?  Yes  No  
(If yes, attach results)

- |  | Before Development  | After Development  |
|--|---|--|
| 11. Depth to Water (from top of well casing) | a. <u>4.91</u> ft.  | <u>13.25</u> ft.   |
| Date   | b. <u>05 / 29 / 2014</u><br>m m d d y y y y   | <u>05 / 29 / 2014</u><br>m m d d y y y y   |
| Time   | c. <u>10 : 04</u> <input checked="" type="checkbox"/> a.m. <input type="checkbox"/> p.m.  | <u>12 : 45</u> <input type="checkbox"/> a.m. <input checked="" type="checkbox"/> p.m.  |
| 12. Sediment in well bottom                  | <u>0.4</u> inches   | _____ inches   |
| 13. Water clarity                            | Clear <input type="checkbox"/> 10<br>Turbid <input checked="" type="checkbox"/> 15<br>(Describe) <u>High turbidity</u><br>(Sandy brown) | Clear <input type="checkbox"/> 20<br>Turbid <input checked="" type="checkbox"/> 25<br>(Describe) <u>Low turbidity</u><br>(Low turbidity) |

Fill in if drilling fluids were used and well is at solid waste facility:

14. Total suspended solids \_\_\_\_\_ mg/l \_\_\_\_\_ mg/l
15. COD \_\_\_\_\_ mg/l \_\_\_\_\_ mg/l

16. Well developed by: Name (first, last) and Firm  
First Name: David Last Name: Casper  
Firm: Badger Laboratories and Engineering Inc.

17. Additional comments on development:

Fine sandy clay sediment removed after 8 gallons. Well recharges to yield 200 ml in every bailer. Does not go dry.  
Check with water level meter shows significant inflow

Name and Address of Facility Contact /Owner/Responsible Party


First Name: JP Last Name: Hammerton

Facility/Firm: Albany International

Street: 3601 Electric City Blvd.

City/State/Zip: Kaukauna WI 54130-

I hereby certify that the above information is true and correct to the best of my knowledge.

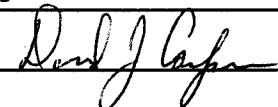Signature: 

Print Name: \_\_\_\_\_

Firm: Badger Laboratories and Engineering Inc.

Route to: Watershed/Wastewater  Waste Management   
Remediation/Redevelopment  Other

Facility/Project Name Former Albany Intrn'l Chrome Plant	County Name OUTAGAMIE	Well Name MW21-A
Facility License, Permit or Monitoring Number 0245000015	County Code 45	Wis. Unique Well Number VN451
		DNR Well ID Number _____

1. Can this well be purged dry?  Yes  No

2. Well development method

surged with bailer and bailed	<input checked="" type="checkbox"/>	4 1
surged with bailer and pumped	<input type="checkbox"/>	6 1
surged with block and bailed	<input type="checkbox"/>	4 2
surged with block and pumped	<input type="checkbox"/>	6 2
surged with block, bailed and pumped	<input type="checkbox"/>	7 0
compressed air	<input type="checkbox"/>	2 0
bailed only	<input type="checkbox"/>	1 0
pumped only	<input type="checkbox"/>	5 1
pumped slowly	<input type="checkbox"/>	5 0
Other _____	<input type="checkbox"/>	

3. Time spent developing well 259 min.

4. Depth of well (from top of well casing) 34 ft.

5. Inside diameter of well 2.05 in.

6. Volume of water in filter pack and well casing 0.5 gal.

7. Volume of water removed from well 5.2 gal.

8. Volume of water added (if any) \_\_\_\_\_ gal.

9. Source of water added \_\_\_\_\_

10. Analysis performed on water added?  Yes  No  
(If yes, attach results)

	Before Development	After Development
11. Depth to Water (from top of well casing)	a. <u>31.14</u> ft.	<u>33.25</u> ft.
Date	b. <u>05 / 29 / 2014</u>	<u>05 / 29 / 2014</u>
Time	c. <u>08 : 57</u> <input checked="" type="checkbox"/> a.m. <input type="checkbox"/> p.m.	<u>13 : 16</u> <input type="checkbox"/> a.m. <input checked="" type="checkbox"/> p.m.
12. Sediment in well bottom	<u>0.5</u> inches	<u>0.1</u> inches
13. Water clarity	Clear <input type="checkbox"/> 1 0 Turbid <input checked="" type="checkbox"/> 1 5 (Describe) <u>Medium turbidity</u> <u>Sandy brown</u>	Clear <input type="checkbox"/> 2 0 Turbid <input type="checkbox"/> 2 5 (Describe) <u>Slight turbidity</u> <u>Sandy brown</u>

Fill in if drilling fluids were used and well is at solid waste facility:

14. Total suspended solids \_\_\_\_\_ mg/l

15. COD \_\_\_\_\_ mg/l

16. Well developed by: Name (first, last) and Firm

First Name: David Last Name: Casper

Firm: Badger Laboratories and Engineering Inc.

17. Additional comments on development:  
Well recharges very slowly per water level indicator. Too slowly to continuously bail, but does not go dry.

Name and Address of Facility Contact /Owner/Responsible Party


First Name: JP Last Name: Hammerton

Facility/Firm: Albany International

Street: 3601 Electric City Blvd.

City/State/Zip: Kaukauna WI 54130-

I hereby certify that the above information is true and correct to the best of my knowledge.

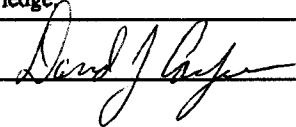Signature: 

Print Name: \_\_\_\_\_

Firm: Badger Laboratories and Engineering Inc.

NOTE: See instructions for more information including a list of county codes and well type codes.

## Soil Boring Logs

Route To: Watershed/Wastewater  Waste Management   
Remediation/Revelopment [x] Other

Page 1 of 1

Facility/Project Name Appleton Wire - Former Albany Internatio		License/Permit/Monitoring Number		Boring Number GP-1	
Boring Drilled By: Name of crew chief (first, last) and Firm First Name: Tony Last Name: Kapugi		Date Drilling Started 5/13/2014	Date Drilling Completed 5/13/2014	Drilling Method vibratory	
Firm: On-Site Environmental					
WI Unique Well No.	DNR Well ID No.	Well Name	Final Static Water Level Feet MSL	Surface Elevation 768.7 Feet MSL	Borehole Diameter 2 inches
Local Grid Origin (estimated: <input type="checkbox"/> ) or Boring Location <input checked="" type="checkbox"/>		Local Grid Location			
State Plane N, E		Lat 44° 16' 9.3"		X N <input checked="" type="checkbox"/> E <input type="checkbox"/>	
SW 1/4 of NW 1/4 of Section 25, T 21 N, R 17 E		Long 88° 23' 43.0"		56.5 Feet <input type="checkbox"/> S 123.9 Feet <input checked="" type="checkbox"/> W	
Facility ID 445035910	County OUTAGAMIE	County Code 45	Civil Town/City/ or Village Appleton		

Sample Number and Type	Length An. & Recovered (m)	Blow Counts	Depth in Feet (Below ground surface)	Soil/Rock Description And Geologic Origin For Each Major Unit	USCS	Graphic Log	Well Diagram	PID/FID	Soil Properties					RQD/ Comments	
									Compressive Strength	Moisture Content	Liquid Limit	Plasticity Index	P 200		
1	60/0			0.0 - 5.0 No recovery											
2	60/60			5.0 - 6.0 Coarse sand/gravel from 5.5 to 6' 6.0 - 10.0 Red/brown clay stiff, dense with at 8-10" and 9'-8"	GP OH										
3	60/60			10.0 - 15.0 Red/brown clay, stiff, dense moist at 14'	OH										
4	60/60			15.0 - 20.0 Red/brown clay, stiff, dense. Wet with some gravel at 18'-7" EOB	OH										

I hereby certify that the information on this form is true and correct to the best of my knowledge.

Signature *Dave Kasper* Firm Badger Laboratories and Engineering, Inc.

This form is authorized by Chapters 281, 283, 289, 291, 292, 293, 295, and 299, Wis. Stats. Completion of this form is mandatory. Failure to file this form may result in forfeiture of between \$10 and \$25,000, or imprisonment for up to one year, depending on the program and conduct involved. Personally identifiable information on this form is not intended to be used for any other purpose. NOTE: See instructions for more information, including where the completed form should be sent.

Route To: Watershed/Wastewater  Waste Management   
Remediation/Revelopment [x] Other

Page 1 of 1

Facility/Project Name Appleton Wire - Former Albany Internatio		License/Permit/Monitoring Number		Boring Number GP-2	
Boring Drilled By: Name of crew chief (first, last) and Firm First Name: Tony Last Name: Kapugi		Date Drilling Started 5/13/2014	Date Drilling Completed 5/13/2014	Drilling Method vibratory	
Firm: On-Site Environmental					
WI Unique Well No.	DNR Well ID No.	Well Name	Final Static Water Level Feet MSL	Surface Elevation 768.7 Feet MSL	Borehole Diameter 2 inches
Local Grid Origin (estimated: <input type="checkbox"/> ) or Boring Location <input checked="" type="checkbox"/>		Local Grid Location			
State Plane N, E		Lat 44° 16' 9.3"		Local Grid Location <input checked="" type="checkbox"/> N <input type="checkbox"/> E	
SW 1/4 of NW 1/4 of Section 25, T 21 N, R 17 E		Long 88° 23' 43.0"		51.5 Feet <input checked="" type="checkbox"/> S 94.7 Feet <input checked="" type="checkbox"/> W	
Facility ID 445035910	County OUTAGAMIE	County Code 45	Civil Town/City/ or Village Appleton		

Sample Number and Type	Length At. & Recovered (in)	Blow Counts	Depth in Feet (Below ground surface)	Soil/Rock Description And Geologic Origin For Each Major Unit	USCS	Graphic Log	Well Diagram	PID/FID	Soil Properties					RQD/ Comments
									Compressive Strength	Moisture Content	Liquid Limit	Plasticity Index	P 200	
1	60/32		0.0 - 0.5	Concrete	FI									
				Dark brown to black sand/gravel fill with black organic soil from 6-15"	OH									
				Red/brown clay, stiff, dense	OH									
2	60/60		5.0 - 10.0	Red/brown clay, stiff, dense to 8.5' Large gravel @ 7'-6" to 7'-8" Wet at 8.5' EOB	OH									

I hereby certify that the information on this form is true and correct to the best of my knowledge.

Signature: *David J. Casper* Firm: Badger Laboratories and Engineering, Inc.

This form is authorized by Chapters 281, 283, 289, 291, 292, 293, 295, and 299, Wis. Stats. Completion of this form is mandatory. Failure to file this form may result in forfeiture of between \$10 and \$25,000, or imprisonment for up to one year, depending on the program and conduct involved. Personally identifiable information on this form is not intended to be used for any other purpose. NOTE: See instructions for more information, including where the completed form should be sent.



Route To: Watershed/Wastewater  Waste Management   
Remediation/Revelopment [x] Other

Page 1 of 1

Facility/Project Name Appleton Wire - Former Albany Internatio		License/Permit/Monitoring Number		Boring Number GP-3	
Boring Drilled By: Name of crew chief (first, last) and Firm First Name: Tony Last Name: Kapugi		Date Drilling Started 5/13/2014	Date Drilling Completed 5/13/2014	Drilling Method vibratory	
Firm: On-Site Environmental					
WI Unique Well No.	DNR Well ID No.	Well Name	Final Static Water Level Feet MSL	Surface Elevation 768.7 Feet MSL	Borehole Diameter 2 inches
Local Grid Origin (estimated: <input type="checkbox"/> ) or Boring Location <input checked="" type="checkbox"/>		Local Grid Location			
State Plane N, E		Lat 44° 16' 9.3"		X N <input checked="" type="checkbox"/> E <input type="checkbox"/>	
SW 1/4 of NW 1/4 of Section 25, T 21 N, R 17 E		Long 88° 23' 43.0"		67.33 Feet <input type="checkbox"/> S 70 Feet <input checked="" type="checkbox"/> W	
Facility ID 445035910	County OUTAGAMIE	County Code 45	Civil Town/City/ or Village Appleton		

Sample Number and Type	Length An. & Recovered (in)	Blow Counts	Depth in Feet (Below ground surface)	Soil/Rock Description And Geologic Origin For Each Major Unit	USCS	Graphic Log	Well Diagram	PID/FID	Soil Properties					RQD/ Comments
									Compressive Strength	Moisture Content	Liquid Limit	Plasticity Index	P 200	
1	60/40			0.0 - 0.5 Concrete	CO									
				0.5 - 1.25 Dark organic wet material (wood or deteriorated charcoal)	CG									
				1.25 - 5.0 3" thick sand/gravel layer above red/brown clay, stiff, dense	OH									
2	60/60			5.0 - 10.0 Wet at 5'-5'6" sand/gravel seam. Then Red/brown clay, stiff, dense and dry to 10'	OH									

I hereby certify that the information on this form is true and correct to the best of my knowledge.

Signature David J. Casper Firm Badger Laboratories and Engineering, Inc.

This form is authorized by chapters 281, 283, 289, 291, 292, 293, 295, and 299, Wis. Stats. Completion of this form is mandatory. Failure to file this form may result in forfeiture of between \$10 and \$25,000, or imprisonment for up to one year, depending on the program and conduct involved. Personally identifiable information on this form is not intended to be used for any other purpose. NOTE: See instructions for more information, including where the completed form should be sent.

Route To: Watershed/Wastewater  Waste Management   
Remediation/Revelopment [x] Other

Page 1 of 1

Facility/Project Name Appleton Wire - Former Albany Internatio		License/Permit/Monitoring Number		Boring Number GP-6	
Boring Drilled By: Name of crew chief (first, last) and Firm First Name: Tony Last Name: Kapugi Firm: On-Site Environmental		Date Drilling Started 5/13/2014 m m d d y y y y	Date Drilling Completed 5/13/2014 m m d d y y y y	Drilling Method vibratory	
WI Unique Well No.	DNR Well ID No.	Well Name	Final Static Water Level Feet MSL	Surface Elevation 768.7 Feet MSL	Borehole Diameter 2 inches
Local Grid Origin <input checked="" type="checkbox"/> (estimated) or Boring Location <input type="checkbox"/> State Plane N, E			Local Grid Location Lat 44° 16' 9.3" N Long 88° 23' 44.0" W		
SW 1/4 of NW 1/4 of Section 25, T 21 N, R 17 E			61.5 Feet <input checked="" type="checkbox"/> N 8.5 Feet <input type="checkbox"/> S <input type="checkbox"/> E <input type="checkbox"/> W		
Facility ID 445035910	County OUTAGAMIE	County Code 45	Civil Town/City/ or Village Appleton		

Sample Number and Type	Length At. & Recovered (in)	Blow Counts	Depth in Feet (Below ground surface)	Soil/Rock Description And Geologic Origin For Each Major Unit	USCS	Graphic Log	Well Diagram	PID/FID	Soil Properties					RQD/ Comments
									Compressive Strength	Moisture Content	Liquid Limit	Plasticity Index	P 200	
1	60/60			0.0 - 0.5 Concrete	CO									
				0.5 - 1.0 Fill	FI									
				1.0 - 5.0 Red/brown clay stiff, dense	OH									
2				5.0 - 10.0 Same as above	OH									
3				10.0 - 15.0 Same as above	OH									

I hereby certify that the information on this form is true and correct to the best of my knowledge.

Signature: *David J. Casper* Firm: Badger Laboratories and Engineering, Inc.

This form is authorized by Chapters 281, 283, 289, 291, 292, 293, 295, and 299, Wis. Stats. Completion of this form is mandatory. Failure to file this form may result in forfeiture of between \$10 and \$25,000, or imprisonment for up to one year, depending on the program and conduct involved. Personally identifiable information on this form is not intended to be used for any other purpose. NOTE: See instructions for more information, including where the completed form should be sent.

Route To: Watershed/Wastewater  Waste Management   
Remediation/Revelopment [x] Other

Page 1 of 1

Facility/Project Name Appleton Wire - Former Albany Internatio		License/Permit/Monitoring Number		Boring Number GP-7	
Boring Drilled By: Name of crew chief (first, last) and Firm First Name: Tony Last Name: Kapugi		Date Drilling Started 5/12/2014	Date Drilling Completed 5/12/2014	Drilling Method vibratory	
Firm: On-Site Environmental					
WI Unique Well No.	DNR Well ID No.	Well Name	Final Static Water Level Feet MSL	Surface Elevation 769.2 Feet MSL	Borehole Diameter 2 inches
Local Grid Origin (estimated: <input type="checkbox"/> ) or Boring Location <input checked="" type="checkbox"/>		Local Grid Location			
State Plane N, E		Lat 44° 16' 9.3"		N <input checked="" type="checkbox"/> S <input type="checkbox"/> E <input type="checkbox"/> W	
SW 1/4 of NW 1/4 of Section 25, T 21 N, R 17 E		Long 88° 23' 43.0"		28.8 Feet <input type="checkbox"/> S 127 Feet <input checked="" type="checkbox"/> W	
Facility ID 445035910	County OUTAGAMIE	County Code 45	Civil Town/City/ or Village Appleton		

Sample Number and Type	Length Ar. & Recovered (in)	Blow Counts	Depth in Feet (below ground surface)	Soil/Rock Description And Geologic Origin For Each Major Unit	USCS	Graphic Log	Well Diagram	PID/FID	Soil Properties					RQD/ Comments
									Compressive Strength	Moisture Content	Liquid Limit	Plasticity Index	P 200	
1	60/48			0.0 - 1.0 Concrete (ramp)	CO									
				1.0 - 1.7 Dark stained fill Slightly wet	FI									
				1.7 - 5.0 Red/brown very stiff dense clay Slightly moist @ 4'	OH									
2	60/60			5.0 - 9.6 Same as above with trace gravel	OH									
3	60/12			9.6 - 10.0 Same as above with large gravel	OH									
				10.0 - 15.0 Same as above. Assumed a small rock was push down blocking sampler	OH									
4	60			15.0 - 20.0 Red/brown very stiff dense clay	OH									

I hereby certify that the information on this form is true and correct to the best of my knowledge.

Signature: David J. Casper Firm: Badger Laboratories and Engineering, Inc.

This form is authorized by Chapters 261, 283, 289, 291, 292, 293, 295, and 299, Wis. Stats. Completion of this form is mandatory. Failure to file this form may result in forfeiture of between \$10 and \$25,000, or imprisonment for up to one year, depending on the program and conduct involved. Personally identifiable information on this form is not intended to be used for any other purpose. NOTE: See instructions for more information, including where the completed form should be sent.

Route To: Watershed/Wastewater  Waste Management   
Remediation/Revelopment [x] Other

Facility/Project Name Appleton Wire - Former Albany Internatio		License/Permit/Monitoring Number		Boring Number GP-8	
Boring Drilled By: Name of crew chief (first, last) and Firm First Name: Tony Last Name: Kapugi		Date Drilling Started 5/12/2014		Date Drilling Completed 5/12/2014	
Firm: On-Site Environmental		Drilling Method vibratory			
WI Unique Well No.	DNR Well ID No.	Well Name	Final Static Water Level Feet MSL	Surface Elevation 768.7 Feet MSL	Borehole Diameter 2 inches
Local Grid Origin (estimated: <input type="checkbox"/> ) or Boring Location <input checked="" type="checkbox"/> State Plane N, E			Local Grid Location		
SW 1/4 of NW 1/4 of Section 25, T 21 N, R 17 E			Lat 44° 16' 9.3"	Long 88° 23' 43.0"	15.8 Feet <input checked="" type="checkbox"/> N <input type="checkbox"/> E <input type="checkbox"/> S 103.25 Feet <input checked="" type="checkbox"/> W
Facility ID 445035910	County OUTAGAMIE	County Code 45	Civil Town/City/ or Village Appleton		

Sample Number and Type	Length At. & Recovered (in)	Blow Counts	Depth in Feet (Below ground surface)	Soil/Rock Description And Geologic Origin For Each Major Unit	USCS	Graphic Log	Well Diagram	PID/FID	Soil Properties					RQD/ Comments
									Compressive Strength	Moisture Content	Liquid Limit	Plasticity Index	P 200	
1	60/48			0.0 - 0.5 Concrete	CO									
				0.5 - 0.85 Fill	FI									
				0.85 - 1.33 Dark stained sandy clay with medium gravel	SC									
				1.33 - 5.0 Red/brown very stiff dense clay with small gravel. Slightly moist @ 5'	OH									
2	60/60			5.0 - 10.0 Red/brown clay	OH									
3	60/60			10.0 - 15.0 Same as above Moist at 13' EOB	OH									

I hereby certify that the information on this form is true and correct to the best of my knowledge.

Signature: *David J. Cooper* Firm: Badger Laboratories and Engineering, Inc.

This form is authorized by Chapters 281, 283, 289, 291, 292, 293, 295, and 299, Wis. Stats. Completion of this form is mandatory. Failure to file this form may result in forfeiture of between \$10 and \$25,000, or imprisonment for up to one year, depending on the program and conduct involved. Personally identifiable information on this form is not intended to be used for any other purpose. NOTE: See instructions for more information, including where the completed form should be sent.

Route To:  Watershed/Wastewater  Waste Management   
 Remediation/Revelopment  Other

Page 1 of 1

Facility/Project Name Appleton Wire - Former Albany Internatio		License/Permit/Monitoring Number		Boring Number GP-9	
Boring Drilled By: Name of crew chief (first, last) and Firm First Name: Tony Last Name: Kapugi		Date Drilling Started 5/12/2014	Date Drilling Completed 5/12/2014	Drilling Method vibratory	
Firm: On-Site Environmental		Final Static Water Level Feet MSL		Surface Elevation 768.7 Feet MSL	
WI Unique Well No.	DNR Well ID No.	Well Name		Borehole Diameter 2 inches	
Local Grid Origin (estimated: <input type="checkbox"/> ) or Boring Location <input checked="" type="checkbox"/>		Lat 44° 16' 9.3"		Local Grid Location	
State Plane N, E		Long 88° 23' 43.0"		30.7 Feet <input checked="" type="checkbox"/> N <input type="checkbox"/> E <input type="checkbox"/> S <input checked="" type="checkbox"/> W 75.5 Feet	
SW 1/4 of NW 1/4 of Section 25, T 21 N, R 17 E		County OUTAGAMIE		Civil Town/City/ or Village Appleton	
Facility ID 445035910		County Code 45			

Sample Number and Type	Length Att. & Recovered (in)	Blow Counts	Depth in Feet (Below ground surface)	Soil/Rock Description And Geologic Origin For Each Major Unit	U S C S	Graphic Log	Well Diagram	PID/FID	Soil Properties					RQD/ Comments	
									Compressive Strength	Moisture Content	Liquid Limit	Plasticity Index	P 200		
1	60/36		0.0 - 0.5	Concrete	CO										
				0.5 - 1.0	Sand fill										FI
				1.0 - 1.3	Dark dry sandy clay										SC
				1.3 - 1.8	Red/brown clay with dispersed black gravel										CL
2	60/60		1.8 - 10.0	Red/brown clay very stiff, dense	OH										
3	60/60		10.0 - 15.0	Same as above. Single large stone at 14'-8"	OH										
4	60/60		15.0 - 20.0	Same as above. Saturated at 20' EOB	OH										

I hereby certify that the information on this form is true and correct to the best of my knowledge.

Signature <i>David J. Casper</i>	Firm Badger Laboratories and Engineering, Inc.
-------------------------------------	---

This form is authorized by Chapters 281, 283, 289, 291, 292, 293, 295, and 299, Wis. Stats. Completion of this form is mandatory. Failure to file this form may result in forfeiture of between \$10 and \$25,000, or imprisonment for up to one year, depending on the program and conduct involved. Personally identifiable information on this form is not intended to be used for any other purpose. NOTE: See instructions for more information, including where the completed form should be sent.

Route To: Watershed/Wastewater  Waste Management   
Remediation/Revelopment  Other

Page 1 of 1

Facility/Project Name Appleton Wire - Former Albany Internatio		License/Permit/Monitoring Number		Boring Number GP-10	
Boring Drilled By: Name of crew chief (first, last) and Firm First Name: Tony Last Name: Kapugi		Date Drilling Started 5/12/2014	Date Drilling Completed 5/12/2014	Drilling Method vibratory	
Firm: On-Site Environmental					
WI Unique Well No.	DNR Well ID No.	Well Name	Final Static Water Level Feet MSL	Surface Elevation 768.7 Feet MSL	Borehole Diameter 2 inches
Local Grid Origin <input checked="" type="checkbox"/> (estimated: <input type="checkbox"/> ) or Boring Location <input checked="" type="checkbox"/>		State Plane N, E		Local Grid Location	
SW 1/4 of NW 1/4 of Section 25, T 21 N, R 17 E		Lat 44° 16' 9.3"		10 Feet <input checked="" type="checkbox"/> N <input type="checkbox"/> E <input type="checkbox"/> S <input checked="" type="checkbox"/> W	
Facility ID 445035910		County OUTAGAMIE	County Code 45	Civil Town/City/ or Village Appleton	

Sample Number and Type	Length Air. & Recovered (ft)	Blow Counts	Depth in Feet (Below ground surface)	Soil/Rock Description And Geologic Origin For Each Major Unit	USCS	Graphic Log	Well Diagram	PID/FID	Soil Properties					RQD/ Comments
									Compressive Strength	Moisture Content	Liquid Limit	Plasticity Index	P 200	
1	60/60			0.0 - 0.5 Concrete floor	CO									
				0.5 - 0.83 Dark stained med/lg gravel & sand from 6-10"	GP									
				0.83 - 2.0 Red/brn sandy clay with small gravel	OH									
				2.0 - 3.0 2-3' as above than abrupt change to Red/brn very dense clay with mottles	OH									
				3.0 - 5.0 Red/brn plastic dense clay	GP									
2	60/60			5.0 - 7.0 Same as above dry	CL									
				7.0 - 8.0 Large (3/8") gravel with med sand	OH									
				8.0 - 10.0 Red/brn clay with trace sand Moist										
3	60/60			10.0 - 15.0 Red/brn very stiff dense clay dry at 15' EOB										

I hereby certify that the information on this form is true and correct to the best of my knowledge.

Signature: *David J. Pappas* Firm: Badger Laboratories and Engineering, Inc.

This form is authorized by Chapters 281, 283, 289, 291, 292, 293, 295, and 299, Wis. Stats. Completion of this form is mandatory. Failure to file this form may result in forfeiture of between \$10 and \$25,000, or imprisonment for up to one year, depending on the program and conduct involved. Personally identifiable information on this form is not intended to be used for any other purpose. NOTE: See instructions for more information, including where the completed form should be sent.

Route To: Watershed/Wastewater  Waste Management   
Remediation/Revelpment [x] Other

Page 1 of 1

Facility/Project Name Appleton Wire - Former Albany Internatio		License/Permit/Monitoring Number	Boring Number GP-11
Boring Drilled By: Name of crew chief (first, last) and Firm First Name: Tony Last Name: Kapugi Firm: On-Site Environmental		Date Drilling Started 5/12/2014	Date Drilling Completed 5/12/2014
Drilling Method vibratory	WI Unique Well No.	DNR Well ID No.	Well Name
Final Static Water Level Feet MSL	Surface Elevation 768.7 Feet MSL	Borehole Diameter 2 inches	
Local Grid Origin 1x (estimated: <input type="checkbox"/> ) or Boring Location <input checked="" type="checkbox"/> State Plane N, E		Local Grid Location Lat 44° 16' 9.3" N Long 88° 23' 43.0" W	
SW 1/4 of NW 1/4 of Section 25, T 21 N, R 17 E		21.1 Feet <input checked="" type="checkbox"/> S 41.75 Feet <input checked="" type="checkbox"/> W	
Facility ID 445035910	County OUTAGAMIE	County Code 45	Civil Town/City/ or Village Appleton

Sample Number and Type	Length Att. & Recovered (in)	Blow Counts	Depth in Feet (Below ground surface)	Soil/Rock Description And Geologic Origin For Each Major Unit	U S C S	Graphic Log	Well Diagram	PID/FID	Soil Properties					ROD/ Comments
									Compressive Strength	Moisture Content	Liquid Limit	Plasticity Index	P 200	
1	60/60			0.0 - 0.42 Concrete 0-5"	CO									
				0.42 - 5.0 Sand	SW									
2	60/60			5.0 - 10.0 Sand wet at 8'	SW									
3	60/60			10.0 - 12.5 Large gravel from 12 -12.5 ft	GP									
				12.5 - 15.0 Brown plastic dense clay	OH									
4	60/60			15.0 - 20.0 Same as above EOB @15'	OH									

I hereby certify that the information on this form is true and correct to the best of my knowledge.

Signature *David J. Cooper* Firm Badger Laboratories and Engineering, Inc.

This form is authorized by Chapters 281, 283, 289, 291, 292, 293, 295, and 299, Wis. Stats. Completion of this form is mandatory. Failure to file this form may result in forfeiture of between \$10 and \$25,000, or imprisonment for up to one year, depending on the program and conduct involved. Personally identifiable information on this form is not intended to be used for any other purpose. NOTE: See instructions for more information, including where the completed form should be sent.

Route To: Watershed/Wastewater  Waste Management   
Remediation/Revelopment [x] Other

Page 1 of 2

Facility/Project Name Appleton Wire - Former Albany Internatio		License/Permit/Monitoring Number		Boring Number GP-12	
Boring Drilled By: Name of crew chief (first, last) and Firm First Name: Tony Last Name: Kapugi		Date Drilling Started 5/12/2014		Date Drilling Completed 5/12/2014	
Firm: On-Site Environmental				Drilling Method vibratory	
WI Unique Well No.	DNR Well ID No.	Well Name	Final Static Water Level Feet MSL	Surface Elevation 757.1 Feet MSL	Borehole Diameter 2 inches
Local Grid Origin [x] (estimated: <input type="checkbox"/> ) or Boring Location <input checked="" type="checkbox"/> State Plane N, E			Local Grid Location		
SW 1/4 of NW 1/4 of Section 25, T 21 N, R 17 E			Lat 44° 16' 9.3" N Long 88° 23' 43.0" W		
Facility ID 445035910		County OUTAGAMIE	County Code 45	Civil Town/City/ or Village Appleton	

Sample Number and Type	Length An. & Recovered (in)	Blow Counts	Depth in Feet (Below ground surface)	Soil/Rock Description And Geologic Origin For Each Major Unit	USCS	Graphic Log	Well Diagram	PID/FID	Soil Properties					RQD/ Comments	
									Compressive Strength	Moisture Content	Liquid Limit	Plasticity Index	P 200		
1	60/60		0.0 - 0.5	6" Concrete floor	CO										
				0.5 - 1.0	Sandy gravel/clay mix										GC
				1.0 - 5.0	Dark brown/red clay, very stiff dense moist to wet										OH
2	60/60		5.0 - 5.5	Large gravel (up to 3 mm) wet	GP										
				5.5 - 10.0	Brown/red clay, very stiff & dense Dry at 10'									OH	

I hereby certify that the information on this form is true and correct to the best of my knowledge.

Signature: *David J. Casper* Firm: Badger Laboratories and Engineering, Inc.

This form is authorized by Chapters 281, 283, 289, 291, 292, 293, 295, and 299, Wis. Stats. Completion of this form is mandatory. Failure to file this form may result in forfeiture of between \$10 and \$25,000, or imprisonment for up to one year, depending on the program and conduct involved. Personally identifiable information on this form is not intended to be used for any other purpose. NOTE: See instructions for more information, including where the completed form should be sent.



Route To: Watershed/Wastewater  Waste Management   
Remediation/Revelopment [x] Other

Page 1 of 1

Facility/Project Name Appleton Wire - Former Albany Internatio		License/Permit/Monitoring Number 1		Boring Number GP-13	
Boring Drilled By: Name of crew chief (first, last) and Firm First Name: Tony Last Name: Kapugi		Date Drilling Started 5/12/2014 m m d d y y y y	Date Drilling Completed 5/12/2014 m m d d y y y y	Drilling Method vibratory	
Firm: On-Site Environmental		Final Static Water Level Feet MSL		Surface Elevation 757.09 Feet MSL	
WI Unique Well No.	DNR Well ID No.	Well Name		Borehole Diameter 2 inches	
Local Grid Origin [x] (estimated: [x]) or Boring Location [x] State Plane N, E		Lat 44° 16' 9.3"		Local Grid Location [x] N [x] E 24 Feet [x] S 16.4 Feet [x] W	
SW 1/4 of NW 1/4 of Section 25, T 21 N, R 17 E		Long 88° 23' 43.0"			
Facility ID 445035910	County OUTAGAMIE	County Code 45	Civil Town/City/ or Village Appleton		

Sample Number and Type	Length An. & Recovered (in)	Blow Counts	Depth in Feet (Below ground surface)	Soil/Rock Description And Geologic Origin For Each Major Unit	USCS	Graphic Log	Well Diagram	PID/FID	Soil Properties					RQD/ Comments
									Compressive Strength	Moisture Content	Liquid Limit	Plasticity Index	P 200	
1	60/30			0.0 - 0.58 Concrete floor	CO									
				0.58 - 5.0 Wood at 20" Red/brown clay, very stiff wet @ 20" below floor	OH									
2	60/60			5.0 - 11.0 Red/brown very clay very stiff satuated										

I hereby certify that the information on this form is true and correct to the best of my knowledge.

Signature David J. Casper Firm Badger Laboratories and Engineering, Inc.

This form is authorized by Chapters 281, 283, 289, 291, 292, 293, 295, and 299, Wis. Stats. Completion of this form is mandatory. Failure to file this form may result in forfeiture of between \$10 and \$25,000, or imprisonment for up to one year, depending on the program and conduct involved. Personally identifiable information on this form is not intended to be used for any other purpose. NOTE: See instructions for more information, including where the completed form should be sent.

## Boring Abandonment Forms

Notice: Completion of this report is required by chs. 160, 281, 283, 289, 291-293, 295, and 299, Wis. Stats., and ch. NR 141, Wis. Adm. Code. In accordance with chs. 281, 289, 291-293, 295, and 299, Wis. Stats., failure to file this form may result in a forfeiture of between \$10-25,000, or imprisonment for up to one year, depending on the program and conduct involved. Personally identifiable information on this form is not intended to be used for any other purpose. Return form to the appropriate DNR office and bureau. See instructions on reverse for more information.

Verification Only of Fill and Seal

Route to:  
 Drinking Water       Watershed/Wastewater       Remediation/Redevelopment  
 Waste Management       Other: \_\_\_\_\_

1. Well Location Information				2. Facility / Owner Information			
County <b>OUTAGAMIE</b>	WI Unique Well # of Removed Well _____ GPI	Hicap #		Facility Name Appleton Wire-Former Albany In			
Latitude / Longitude (Degrees and Minutes) 44 . 16.155 ' N 88 . 23.71 ' W		Method Code (see instructions) GPS007		Facility ID (FID or PWS) 445035910			
1/4 SW    1/4 NW or Gov't Lot #		Section 25	Township 21 N	Range 17	<input checked="" type="checkbox"/> E <input type="checkbox"/> W		
Well Street Address 908 N. Lawe Street				Original Well Owner Albany International			
Well City, Village or Town Appleton				Present Well Owner Albany International			
Well ZIP Code 54911-				Mailing Address of Present Owner 3601 Electric City Blvd.			
Subdivision Name Harriman's Lawsburg Plat				City of Present Owner Kaukauna		State WI	ZIP Code 54130-
Lot # 11							

3. Well / Drillhole / Borehole Information		4. Pump, Liner, Screen, Casing & Sealing Material			
Reason For Removal From Service Sampling completed	WI Unique Well # of Replacement Well _____	Pump and piping removed? <input type="checkbox"/> Yes <input type="checkbox"/> No <input checked="" type="checkbox"/> N/A Liner(s) removed? <input type="checkbox"/> Yes <input type="checkbox"/> No <input checked="" type="checkbox"/> N/A Screen removed? <input checked="" type="checkbox"/> Yes <input type="checkbox"/> No <input type="checkbox"/> N/A Casing left in place? <input type="checkbox"/> Yes <input checked="" type="checkbox"/> No <input type="checkbox"/> N/A			
<input type="checkbox"/> Monitoring Well <input type="checkbox"/> Water Well <input checked="" type="checkbox"/> Borehole / Drillhole	Original Construction Date (mm/dd/yyyy) 5/13/2014	Was casing cut off below surface? <input type="checkbox"/> Yes <input type="checkbox"/> No <input checked="" type="checkbox"/> N/A Did sealing material rise to surface? <input checked="" type="checkbox"/> Yes <input type="checkbox"/> No <input type="checkbox"/> N/A Did material settle after 24 hours? If yes, was hole retopped? <input type="checkbox"/> Yes <input type="checkbox"/> No <input checked="" type="checkbox"/> N/A If bentonite chips were used, were they hydrated with water from a known safe source? <input checked="" type="checkbox"/> Yes <input type="checkbox"/> No <input type="checkbox"/> N/A			
Construction Type: <input type="checkbox"/> Drilled <input type="checkbox"/> Driven (Sandpoint) <input type="checkbox"/> Dug <input checked="" type="checkbox"/> Other (specify): Vibratory push sampler		Required Method of Placing Sealing Material <input type="checkbox"/> Conductor Pipe-Gravity <input type="checkbox"/> Conductor Pipe-Pumped <input checked="" type="checkbox"/> Screened & Poured (Bentonite Chips) <input type="checkbox"/> Other (Explain): _____			
Formation Type: <input checked="" type="checkbox"/> Unconsolidated Formation <input type="checkbox"/> Bedrock		Sealing Materials <input type="checkbox"/> Neat Cement Grout <input type="checkbox"/> Clay-Sand Slurry (11 lb./gal. wt.) <input type="checkbox"/> Sand-Cement (Concrete) Grout <input type="checkbox"/> Bentonite-Sand Slurry " " <input checked="" type="checkbox"/> Concrete <input type="checkbox"/> Bentonite Chips			

Total Well Depth From Ground Surface (ft.) 20	Casing Diameter (in.) 2	For Monitoring Wells and Monitoring Well Boreholes Only: <input type="checkbox"/> Bentonite Chips <input type="checkbox"/> Bentonite - Cement Grout <input checked="" type="checkbox"/> Granular Bentonite <input type="checkbox"/> Bentonite - Sand Slurry			
Lower Drillhole Diameter (in.) 2	Casing Depth (ft.)				
Was well annular space grouted? <input type="checkbox"/> Yes <input checked="" type="checkbox"/> No <input type="checkbox"/> Unknown	Depth to Water (feet) 5				

5. Material Used To Fill Well / Drillhole	From (ft.)	To (ft.)	Sacks Sealant
Concrete	Surface	0.5	
Granular bentonite	0.5	20	0.75

6. Comments  
Push probe soil sample boring and temp well abandonment

7. Supervision of Work				DNR Use Only	
Name of Person or Firm Doing Filling & Sealing David Casper-Badger Labs & Engineering Inc	License #	Date of Filling & Sealing (mm/dd/yyyy) 5/13/2014	Date Received	Noted By	
Street or Route 501 W. Bell Street		Telephone Number (920) 729-1100	Comments		
City Neenah	State WI	ZIP Code 54956-	Signature of Person Doing Work David J. Casper	Date Signed 7/5/2016	

Notice: Completion of this report is required by chs. 160, 281, 283, 289, 291-293, 295, and 299, Wis. Stats., and ch. NR 141, Wis. Adm. Code. In accordance with chs. 281, 289, 291-293, 295, and 299, Wis. Stats., failure to file this form may result in a forfeiture of between \$10-25,000, or imprisonment for up to one year, depending on the program and conduct involved. Personally identifiable information on this form is not intended to be used for any other purpose. Return form to the appropriate DNR office and bureau. See instructions on reverse for more information.

Verification Only of Fill and Seal

Route to:

Drinking Water       Watershed/Wastewater       Remediation/Redevelopment

Waste Management       Other: \_\_\_\_\_

**1. Well Location Information**

County: **OUTAGAMIE**

MI Unique Well # of Removed Well: \_\_\_\_\_ GP2 \_\_\_\_\_

Hicap #: \_\_\_\_\_

Latitude / Longitude (Degrees and Minutes):  
44 . 16.155 ' N  
88 . 23.71 ' W

Method Code (see instructions): **GPS007**

1/4 SW    1/4 NW    Section: 25    Township: 21 N    Range: 17     E     W

or Gov't Lot #: \_\_\_\_\_

Well Street Address: 908 N. Lawe Street

Well City, Village or Town: Appleton      Well ZIP Code: 54911-

Subdivision Name: Harriman's Lawsburg Plat      Lot #: 11

Reason For Removal From Service: Sampling completed      MI Unique Well # of Replacement Well: \_\_\_\_\_

**2. Facility / Owner Information**

Facility Name: **Appleton Wire-Former Albany In**

Facility ID (FID or PWS): **445035910**

License/Permit/Monitoring #: \_\_\_\_\_

Original Well Owner: **Albany International**

Present Well Owner: **Albany International**

Mailing Address of Present Owner: **3601 Electric City Blvd**

City of Present Owner: **Kaukauna**      State: **WI**      ZIP Code: **54130-**

**3. Well / Drillhole / Borehole Information**

Monitoring Well      Original Construction Date (mm/dd/yyyy): **5/13/2014**

Water Well

Borehole / Drillhole      If a Well Construction Report is available, please attach.

Construction Type:

Drilled       Driven (Sandpoint)       Dug

Other (specify): **Vibratory push sampler**

**4. Pump, Liner, Screen, Casing & Sealing Material**

Pump and piping removed?  Yes  No  N/A

Liner(s) removed?  Yes  No  N/A

Screen removed?  Yes  No  N/A

Casing left in place?  Yes  No  N/A

Was casing cut off below surface?  Yes  No  N/A

Did sealing material rise to surface?  Yes  No  N/A

Did material settle after 24 hours?  Yes  No  N/A

If yes, was hole retopped?  Yes  No  N/A

If bentonite chips were used, were they hydrated with water from a known safe source?  Yes  No  N/A

Formation Type:

Unconsolidated Formation       Bedrock

Total Well Depth From Ground Surface (ft.): **10**      Casing Diameter (in.): \_\_\_\_\_

Lower Drillhole Diameter (in.): **2**      Casing Depth (ft.): \_\_\_\_\_

Was well annular space grouted?  Yes  No  Unknown

If yes, to what depth (feet)? \_\_\_\_\_      Depth to Water (feet): \_\_\_\_\_

Required Method of Placing Sealing Material

Conductor Pipe-Gravity       Conductor Pipe-Pumped

Screened & Poured (Bentonite Chips)       Other (Explain): \_\_\_\_\_

Sealing Materials

Neat Cement Grout       Clay-Sand Slurry (11 lb/gal. wt.)

Sand-Cement (Concrete) Grout       Bentonite-Sand Slurry " "

Concrete       Bentonite Chips

For Monitoring Wells and Monitoring Well Boreholes Only:

Bentonite Chips       Bentonite - Cement Grout

Granular Bentonite       Bentonite - Sand Slurry

**5. Material Used To Fill Well / Drillhole**

	From (ft.)	To (ft.)	Sacks Sealant
Concrete	Surface	0.5	
Granular bentonite	0.5	10	0.33

From (ft.)	To (ft.)	Sacks Sealant
Surface	0.5	
0.5	10	0.33

**6. Comments**

Push probe soil sample boring abandonment

**7. Supervision of Work**

			DNR Use Only	
Name of Person or Firm Doing Filling & Sealing	License #	Date of Filling & Sealing (mm/dd/yyyy)	Date Received	Noted By
David Casper-Badger Labs & Engineering Inc		5/13/2014		
Street or Route: 501 W. Bell Street		Telephone Number: (920) 729-1100	Comments:	
City: Neenay	State: WI	ZIP Code: 54956-	Signature of Person Doing Work: <i>David J. Casper</i>	Date Signed: 7/5/2016

Notice: Completion of this report is required by chs. 160, 281, 283, 289, 291-293, 295, and 299, Wis. Stats., and ch. NR 141, Wis. Adm. Code. In accordance with chs. 281, 289, 291-293, 295, and 299, Wis. Stats., failure to file this form may result in a forfeiture of between \$10-25,000, or imprisonment for up to one year, depending on the program and conduct involved. Personally identifiable information on this form is not intended to be used for any other purpose. Return form to the appropriate DNR office and bureau. See instructions on reverse for more information.

**Verification Only of Fill and Seal**

Route to:  
 Drinking Water     Watershed/Wastewater     Remediation/Redevelopment  
 Waste Management     Other: \_\_\_\_\_

1. Well Location Information			2. Facility / Owner Information		
County <b>OUTAGAMIE</b>	WI Unique Well # of Removed Well ____ GP3 ____	Licap #	Facility Name <b>Appleton Wire-Former Albany In</b>		
Latitude / Longitude (Degrees and Minutes) 44 ° 16.155 ' N		Method Code (see instructions) GPS007	Facility ID (FID or PWS) <b>445350910</b>		
88 ° 23.7 ' W			License/Permit/Monitoring #		

1/4 SW	1/4 NW	Section <b>25</b>	Township <b>21 N</b>	Range <b>17</b>	[X] E <input type="checkbox"/> W	Original Well Owner <b>Albany International</b>
or Gov't Lot #						Present Well Owner <b>Albany International</b>
Well Street Address <b>908 N. Lawe Street</b>						Mailing Address of Present Owner <b>3601 Electric City Blvd.</b>
Well City, Village or Town <b>Appleton</b>			Well ZIP Code <b>54911-</b>			City of Present Owner <b>Kaukauna</b>
Subdivision Name <b>Harriman's Lawsbug Plat</b>			Lot # <b>11</b>			State <b>WI</b>
Reason For Removal From Service Sampling completed			WI Unique Well # of Replacement Well			ZIP Code <b>54130-</b>

3. Well / Drillhole / Borehole Information		4. Pump, Liner, Screen, Casing & Sealing Material	
<input type="checkbox"/> Monitoring Well	Original Construction Date (mm/dd/yyyy) <b>5/13/2014</b>	Pump and piping removed?	[ ] Yes [ ] No [X] N/A
<input type="checkbox"/> Water Well	If a Well Construction Report is available, please attach.	Liner(s) removed?	[ ] Yes [ ] No [X] N/A
<input checked="" type="checkbox"/> Borehole / Drillhole		Screen removed?	[ ] Yes [ ] No [X] N/A
Construction Type:		Casing left in place?	[ ] Yes [ ] No [X] N/A
<input type="checkbox"/> Drilled	<input type="checkbox"/> Driven (Sandpoint)	Was casing cut off below surface?	[ ] Yes [ ] No [X] N/A
<input checked="" type="checkbox"/> Other (specify): <b>Vibratory push sampler</b>	<input type="checkbox"/> Dug	Did sealing material rise to surface?	[X] Yes [ ] No [ ] N/A
Formation Type:		Did material settle after 24 hours?	[ ] Yes [ ] No [X] N/A
<input checked="" type="checkbox"/> Unconsolidated Formation	<input type="checkbox"/> Bedrock	If yes, was hole retopped?	[ ] Yes [ ] No [X] N/A
Total Well Depth From Ground Surface (ft.) <b>10</b>		If bentonite chips were used, were they hydrated with water from a known safe source?	
Casing Diameter (in.)		[X] Yes [ ] No [ ] N/A	
Lower Drillhole Diameter (in.) <b>2</b>		Required Method of Placing Sealing Material	
Casing Depth (ft.)		<input type="checkbox"/> Conductor Pipe-Gravity <input type="checkbox"/> Conductor Pipe-Pumped	
Was well annular space grouted? <input type="checkbox"/> Yes [X] No [ ] Unknown		[X] Screened & Poured (Bentonite Chips) <input type="checkbox"/> Other (Explain): _____	
If yes, to what depth (feet)?		Sealing Materials	
Depth to Water (feet)		<input type="checkbox"/> Neat Cement Grout <input type="checkbox"/> Clay-Sand Slurry (11 lb./gal. wt.)	
		<input type="checkbox"/> Sand-Cement (Concrete) Grout <input type="checkbox"/> Bentonite-Sand Slurry " "	
		[X] Concrete <input type="checkbox"/> Bentonite Chips	

5. Material Used To Fill Well / Drillhole		For Monitoring Wells and Monitoring Well Boreholes Only:	
Concrete	From (ft.) <b>Surface</b>	To (ft.) <b>0.5</b>	[ ] Bentonite Chips <input type="checkbox"/> Bentonite - Cement Grout
Granular bentonite	0.5	10	[X] Granular Bentonite <input type="checkbox"/> Bentonite - Sand Slurry
			Sacks Sealant <b>0.33</b>

6. Comments	
<b>Push probe soil sample boring abandonment</b>	

7. Supervision of Work			DNR Use Only	
Name of Person or Firm Doing Filling & Sealing <b>David Casper-Badger Labs &amp; Engineering Inc</b>	License #	Date of Filling & Sealing (mm/dd/yyyy) <b>5/13/2014</b>	Date Received	Noted By
Street or Route <b>501 W Bell Street</b>		Telephone Number <b>(920) 729-1100</b>	Comments	
City <b>Neenah</b>	State <b>WI</b>	ZIP Code <b>54956-</b>	Signature of Person Doing Work <i>David J. Casper</i>	Date Signed <b>7/5/2016</b>

Notice: Completion of this report is required by chs. 160, 281, 283, 289, 291-293, 295, and 299, Wis. Stats., and ch. NR 141, Wis. Adm. Code. In accordance with chs. 281, 289, 291-293, 295, and 299, Wis. Stats., failure to file this form may result in a forfeiture of between \$10-25,000, or imprisonment for up to one year, depending on the program and conduct involved. Personally identifiable information on this form is not intended to be used for any other purpose. Return form to the appropriate DNR office and bureau. See instructions on reverse for more information.

Verification Only of Fill and Seal

Route to:

Drinking Water       Watershed/Wastewater       Remediation/Redevelopment

Waste Management       Other: \_\_\_\_\_

**1. Well Location Information**

County: **OUTAGAMIE**

MI Unique Well # of Removed Well: \_\_\_\_\_ GP7 \_\_\_\_\_

Facap #: \_\_\_\_\_

Latitude / Longitude (Degrees and Minutes):  
44 ° 16.155 ' N  
88 ° 23.71 ' W

Method Code (see instructions): **GPS007**

1/4 SW 1/4 NW Section: 25 Township: 21 N Range: 17  E  W

or Gov't Lot #: \_\_\_\_\_

Well Street Address: 908 N. Lawe Street

Well City, Village or Town: Appleton Well ZIP Code: 54911-

Subdivision Name: Harriman's Lawsburg Plat Lot #: 11

Reason For Removal From Service: Sampling completed MI Unique Well # of Replacement Well: \_\_\_\_\_

**2. Facility / Owner Information**

Facility Name: Appleton Wire-Former Albany In

Facility ID (FID or PWS): 445035910

License/Permit/Monitoring #: \_\_\_\_\_

Original Well Owner: Albany International

Present Well Owner: Albany International

Mailing Address of Present Owner: 3601 Electric City Blvd.

City of Present Owner: Kaukauna State: WI ZIP Code: 54130-

**3. Well / Drillhole / Borehole Information**

Monitoring Well  
 Water Well  
 Borehole / Drillhole

Original Construction Date (mm/dd/yyyy): 5/12/2014

If a Well Construction Report is available, please attach.

Construction Type:  
 Drilled       Driven (Sandpoint)       Dug  
 Other (specify): Vibratory push sampler

**4. Pump, Liner, Screen, Casing & Sealing Material**

Pump and piping removed?  Yes  No  N/A

Liner(s) removed?  Yes  No  N/A

Screen removed?  Yes  No  N/A

Casing left in place?  Yes  No  N/A

Was casing cut off below surface?  Yes  No  N/A

Did sealing material rise to surface?  Yes  No  N/A

Did material settle after 24 hours?  Yes  No  N/A

If yes, was hole retopped?  Yes  No  N/A

If bentonite chips were used, were they hydrated with water from a known safe source?  Yes  No  N/A

Formation Type:  
 Unconsolidated Formation       Bedrock

Total Well Depth From Ground Surface (ft.): 20 Casing Diameter (in.): \_\_\_\_\_

Lower Drillhole Diameter (in.): 2 Casing Depth (ft.): \_\_\_\_\_

Was well annular space grouted?  Yes  No  Unknown

If yes, to what depth (feet)? \_\_\_\_\_ Depth to Water (feet): 4.06

Required Method of Placing Sealing Material:  
 Conductor Pipe-Gravity       Conductor Pipe-Pumped  
 Screened & Poured (Bentonite Chips)       Other (Explain): \_\_\_\_\_

Sealing Materials:  
 Neat Cement Grout       Clay-Sand Slurry (11 lb./gal. wt.)  
 Sand-Cement (Concrete) Grout       Bentonite-Sand Slurry " "  
 Concrete       Bentonite Chips

For Monitoring Wells and Monitoring Well Boreholes Only:  
 Bentonite Chips       Bentonite - Cement Grout  
 Granular Bentonite       Bentonite - Sand Slurry

**5. Material Used To Fill Well / Drillhole**

	From (ft.)	To (ft.)	Sacks Sealant
Concrete	Surface	0.7	
Granular bentonite	0.7	20	0.75

From (ft.)	To (ft.)	Sacks Sealant
Surface	0.7	
0.7	20	0.75

**6. Comments**

Push probe and temp well abandonment Temp well removed completely

**7. Supervision of Work**

				DNR Use Only	
Name of Person or Firm Doing Filling & Sealing	License #	Date of Filling & Sealing (mm/dd/yyyy)	Date Received	Noted By	
David Casper-Badger Labs & Engineering Inc		5/13/2014			
Street or Route: 501 W. Bell Street		Telephone Number: (920) 729-1100	Comments:		
City: Neenah	State: WI	ZIP Code: 54956-	Signature of Person Doing Work: David J. Casper	Date Signed: 7/5/2016	

Notice: Completion of this report is required by chs. 160, 281, 283, 289, 291-293, 295, and 299, Wis. Stats., and ch. NR 141, Wis. Adm. Code. In accordance with chs. 281, 289, 291-293, 295, and 299, Wis. Stats., failure to file this form may result in a forfeiture of between \$10-25,000, or imprisonment for up to one year, depending on the program and conduct involved. Personally identifiable information on this form is not intended to be used for any other purpose. Return form to the appropriate DNR office and bureau. See instructions on reverse for more information.

Verification Only of Fill and Seal

Route to:  
 Drinking Water       Watershed/Wastewater       Remediation/Redevelopment  
 Waste Management       Other: \_\_\_\_\_

<b>1. Well Location Information</b>			<b>2. Facility / Owner Information</b>		
County <b>OUTAGAMIE</b>	WI Unique Well # of Removed Well ____ GP8 ____	Ficap #	Facility Name <b>Appleton Wire-Former Albany In</b>		
Latitude / Longitude (Degrees and Minutes) <b>44 ° 16.155 ' N</b> <b>88 ° 23.71 ' W</b>		Method Code (see instructions) <b>GPS007</b>	Facility ID (FID or PWS) <b>445035910</b>		
1/4 SW    1/4 NW	Section <b>25</b>	Township <b>21 N</b>	Range <b>17</b>	License/Permit/Monitoring #	
or Gov't Lot #				<b>445035910</b>	
Well Street Address <b>908 N. Lawe Street</b>			Original Well Owner <b>Albany International</b>		
Well City, Village or Town <b>Appleton</b>			Present Well Owner <b>Albany International</b>		
Well ZIP Code <b>54911-</b>			Mailing Address of Present Owner <b>3601 Electric City Blvd.</b>		
Subdivision Name <b>Harriman's Lawsburg Plat</b>			City of Present Owner <b>Kaukauna</b>		
Lot # <b>11</b>			State <b>WI</b>		
Reason For Removal From Service <b>Sampling completed</b>			ZIP Code <b>54130-</b>		
WI Unique Well # of Replacement Well			<b>4. Pump, Liner, Screen, Casing &amp; Sealing Material</b>		

<b>3. Well / Drillhole / Borehole Information</b>		Original Construction Date (mm/dd/yyyy) <b>5/12/2014</b>	
<input type="checkbox"/> Monitoring Well	If a Well Construction Report is available, please attach.		
<input type="checkbox"/> Water Well			
<input checked="" type="checkbox"/> Borehole / Drillhole			
Construction Type:			
<input type="checkbox"/> Drilled	<input type="checkbox"/> Driven (Sandpoint)	<input type="checkbox"/> Dug	
<input checked="" type="checkbox"/> Other (specify): <b>Vibratory push sampler</b>			
Formation Type:			
<input checked="" type="checkbox"/> Unconsolidated Formation		<input type="checkbox"/> Bedrock	
Total Well Depth From Ground Surface (ft.) <b>15</b>	Casing Diameter (in.)		
Lower Drillhole Diameter (in.) <b>2</b>	Casing Depth (ft.)		
Was well annular space grouted? <input type="checkbox"/> Yes <input checked="" type="checkbox"/> No <input type="checkbox"/> Unknown			
If yes, to what depth (feet)?	Depth to Water (feet)		

<b>5. Material Used To Fill Well / Drillhole</b>			
	From (ft.)	To (ft.)	Sacks Sealant
Concrete	Surface	0.5	
Granular Bentonite	0.5	15	0.5

**6. Comments**  
Push probe soil sample boring abandonment

<b>7. Supervision of Work</b>			<b>DNR Use Only</b>	
Name of Person or Firm Doing Filling & Sealing <b>David Casper-Badger Labs &amp; Engineering Inc</b>	License #	Date of Filling & Sealing (mm/dd/yyyy) <b>5/12/2014</b>	Date Received	Noted By
Street or Route <b>501 W. Bell Street</b>		Telephone Number <b>(920) 729-1100</b>	Comments	
City <b>Neenah</b>	State <b>WI</b>	ZIP Code <b>54956-</b>	Signature of Person Doing Work <i>David J. Casper</i>	Date Signed <b>7/5/2016</b>

Notice: Completion of this report is required by chs. 160, 281, 283, 289, 291-293, 295, and 299, Wis. Stats., and ch. NR 141, Wis. Adm. Code. In accordance with chs. 281, 289, 291-293, 295, and 299, Wis. Stats., failure to file this form may result in a forfeiture of between \$10-25,000, or imprisonment for up to one year, depending on the program and conduct involved. Personally identifiable information on this form is not intended to be used for any other purpose. Return form to the appropriate DNR office and bureau. See instructions on reverse for more information.

**Verification Only of Fill and Seal**

Route to:

Drinking Water       Watershed/Wastewater       Remediation/Redevelopment

Waste Management       Other: \_\_\_\_\_

<b>1. Well Location Information</b>			<b>2. Facility / Owner Information</b>		
County <b>OUTAGAMIE</b>	WI Unique Well # of Removed Well _____ GP9	Facap #	Facility Name <b>Appleton Wire-Former Albany In</b>		
Latitude / Longitude (Degrees and Minutes) 44 . 16.155 ' N		Method Code (see instructions) GPS007	Facility ID (FID or PWS) <b>445035910</b>		
88 . 23.71 ' W			License/Permit/Monitoring #		
Original Well Owner <b>Albany International</b>			Present Well Owner <b>Albany International</b>		

1/4 SW	1/4 NW	Section <b>25</b>	Township <b>21 N</b>	Range <b>17</b>	<input checked="" type="checkbox"/> E <input type="checkbox"/> W
Well Street Address <b>908 N. Lawe Street</b>					
Well City, Village or Town <b>Appleton</b>			Well ZIP Code <b>54911-</b>		
Subdivision Name <b>Harriman's Lawsburg Plat</b>			Lot # <b>11</b>		
Reason For Removal From Service Sampling completed		WI Unique Well # of Replacement Well			

<b>3. Well / Drillhole / Borehole Information</b>			<b>4. Pump, Liner, Screen, Casing &amp; Sealing Material</b>		
<input type="checkbox"/> Monitoring Well	Original Construction Date (mm/dd/yyyy) <b>5/12/2014</b>		Pump and piping removed? <input type="checkbox"/> Yes <input type="checkbox"/> No <input checked="" type="checkbox"/> N/A		
<input type="checkbox"/> Water Well	If a Well Construction Report is available, please attach.		Liner(s) removed? <input type="checkbox"/> Yes <input type="checkbox"/> No <input checked="" type="checkbox"/> N/A		
<input checked="" type="checkbox"/> Borehole / Drillhole			Screen removed? <input type="checkbox"/> Yes <input type="checkbox"/> No <input checked="" type="checkbox"/> N/A		
Construction Type:			Casing left in place? <input type="checkbox"/> Yes <input type="checkbox"/> No <input checked="" type="checkbox"/> N/A		
<input type="checkbox"/> Drilled	<input type="checkbox"/> Driven (Sandpoint)	<input type="checkbox"/> Dug	Was casing cut off below surface? <input type="checkbox"/> Yes <input type="checkbox"/> No <input checked="" type="checkbox"/> N/A		
<input checked="" type="checkbox"/> Other (specify): <b>Vibratory push sampler</b>			Did sealing material rise to surface? <input type="checkbox"/> Yes <input type="checkbox"/> No <input checked="" type="checkbox"/> N/A		
Formation Type:			Did material settle after 24 hours? <input type="checkbox"/> Yes <input type="checkbox"/> No <input checked="" type="checkbox"/> N/A		
<input checked="" type="checkbox"/> Unconsolidated Formation	<input type="checkbox"/> Bedrock		If yes, was hole retopped? <input type="checkbox"/> Yes <input type="checkbox"/> No <input checked="" type="checkbox"/> N/A		
Total Well Depth From Ground Surface (ft.) <b>20</b>			If bentonite chips were used, were they hydrated with water from a known safe source? <input checked="" type="checkbox"/> Yes <input type="checkbox"/> No <input type="checkbox"/> N/A		
Lower Drillhole Diameter (in.) <b>2</b>			Required Method of Placing Sealing Material		
Casing Diameter (in.)			<input type="checkbox"/> Conductor Pipe-Gravity <input type="checkbox"/> Conductor Pipe-Pumped		
Casing Depth (ft.)			<input checked="" type="checkbox"/> Screened & Poured (Bentonite Chips) <input type="checkbox"/> Other (Explain): _____		
Was well annular space grouted? <input type="checkbox"/> Yes <input checked="" type="checkbox"/> No <input type="checkbox"/> Unknown			Sealing Materials		
If yes, to what depth (feet)?			<input type="checkbox"/> Neat Cement Grout <input type="checkbox"/> Clay-Sand Slurry (11 lb/gal. wt.)		
Depth to Water (feet)			<input type="checkbox"/> Sand-Cement (Concrete) Grout <input type="checkbox"/> Bentonite-Sand Slurry " "		
			<input checked="" type="checkbox"/> Concrete <input type="checkbox"/> Bentonite Chips		

<b>5. Material Used To Fill Well / Drillhole</b>			From (ft.)	To (ft.)	Sacks Sealant
Concrete			Surface	0.5	
Granular Bentonite			0.5	20	0.75

**6. Comments**

Push probe soil sample boring abandonment

<b>7. Supervision of Work</b>				<b>DNR Use Only</b>	
Name of Person or Firm Doing Filling & Sealing <b>Da</b>	License #	Date of Filling & Sealing (mm/dd/yyyy) <b>5/12/2014</b>	Date Received	Noted By	
Street or Route <b>501 W. Bell Street</b>			Telephone Number <b>(920) 729-1100</b>	Comments	
City <b>Neenah</b>	State <b>WI</b>	ZIP Code <b>54956-</b>	Signature of Person Doing Work <i>David J. Casper</i>	Date Signed <b>7/5/2016</b>	



Notice: Completion of this report is required by chs. 160, 281, 283, 289, 291-293, 295, and 299, Wis. Stats., and ch. NR 141, Wis. Adm. Code. In accordance with chs. 281, 289, 291-293, 295, and 299, Wis. Stats., failure to file this form may result in a forfeiture of between \$10-25,000, or imprisonment for up to one year, depending on the program and conduct involved. Personally identifiable information on this form is not intended to be used for any other purpose. Return form to the appropriate DNR office and bureau. See instructions on reverse for more information.

Verification Only of Fill and Seal

Route to:

Drinking Water       Watershed/Wastewater       Remediation/Redevelopment

Waste Management       Other: \_\_\_\_\_

<b>1. Well Location Information</b>			<b>2. Facility / Owner Information</b>		
County <b>OUTAGAMIE</b>	WI Unique Well # of Removed Well ____ GP8 ____	Facap #	Facility Name <b>Appleton Wire-Former Albany In</b>		
Latitude / Longitude (Degrees and Minutes) <b>44</b> ° <b>16.155</b> ' N		Method Code (see instructions) <b>GPS007</b>	Facility ID (FID or PWS) <b>445035910</b>		
<b>88</b> ° <b>23.71</b> ' W			License/Permit/Monitoring #		

1/4 SW	1/4 NW	Section <b>25</b>	Township <b>21 N</b>	Range <b>17</b>	<input checked="" type="checkbox"/> E <input type="checkbox"/> W	Original Well Owner <b>Albany International</b>
or Gov't Lot #						Present Well Owner <b>Albany International</b>
Well Street Address <b>908 N. Lawe Street</b>						Mailing Address of Present Owner <b>3601 Electric City Blvd.</b>
Well City, Village or Town <b>Appleton</b>			Well ZIP Code <b>54911-</b>			City of Present Owner <b>Kaukauna</b>
Subdivision Name <b>Harriman's Lawsburg Plat</b>			Lot # <b>11</b>			State <b>WI</b>
Reason For Removal From Service <b>Sampling completed</b>			WI Unique Well # of Replacement Well			ZIP Code <b>54130-</b>

**4. Pump, Liner, Screen, Casing & Sealing Material**

Pump and piping removed?  Yes  No  N/A

Liner(s) removed?  Yes  No  N/A

Screen removed?  Yes  No  N/A

Casing left in place?  Yes  No  N/A

Was casing cut off below surface?  Yes  No  N/A

Did sealing material rise to surface?  Yes  No  N/A

Did material settle after 24 hours?  Yes  No  N/A

If yes, was hole retopped?  Yes  No  N/A

If bentonite chips were used, were they hydrated with water from a known safe source?  Yes  No  N/A

**3. Well / Drillhole / Borehole Information**

Monitoring Well      Original Construction Date (mm/dd/yyyy)  
**5/12/2014**

Water Well

Borehole / Drillhole      If a Well Construction Report is available, please attach.

Construction Type:

Drilled       Driven (Sandpoint)       Dug

Other (specify): **Vibratory push sampler**

Formation Type:

Unconsolidated Formation       Bedrock

Total Well Depth From Ground Surface (ft.) **15**      Casing Diameter (in.)

Lower Drillhole Diameter (in.) **2**      Casing Depth (ft.)

Was well annular space grouted?  Yes  No  Unknown

If yes, to what depth (feet)?      Depth to Water (feet)

**5. Material Used To Fill Well / Drillhole**

	From (ft.)	To (ft.)	Sacks Sealant
Concrete	Surface	0.5	
Granular Bentonite	0.5	15	0.5

**6. Comments**

Push probe soil sample boring abandonment

<b>7. Supervision of Work</b>				<b>DNR Use Only</b>	
Name of Person or Firm Doing Filling & Sealing <b>David Casper-Badger Labs &amp; Engineering Inc</b>	License #	Date of Filling & Sealing (mm/dd/yyyy) <b>5/12/2014</b>	Date Received	Noted By	
Street or Route <b>501 W. Bell Street</b>		Telephone Number <b>(920) 729-1100</b>	Comments		
City <b>Neenah</b>	State <b>WI</b>	ZIP Code <b>54956-</b>	Signature of Person Doing Work <i>David J. Casper</i>	Date Signed <b>7/5/2016</b>	

Notice: Completion of this report is required by chs. 160, 281, 283, 289, 291-293, 295, and 299, Wis. Stats., and ch. NR 141, Wis. Adm. Code. In accordance with chs. 281, 289, 291-293, 295, and 299, Wis. Stats., failure to file this form may result in a forfeiture of between \$10-25,000, or imprisonment for up to one year, depending on the program and conduct involved. Personally identifiable information on this form is not intended to be used for any other purpose. Return form to the appropriate DNR office and bureau. See instructions on reverse for more information.

**Verification Only of Fill and Seal**

Route to:

Drinking Water       Watershed/Wastewater       Remediation/Redevelopment

Waste Management       Other: \_\_\_\_\_

<b>1. Well Location Information</b>			<b>2. Facility / Owner Information</b>		
County <b>OUTAGAMIE</b>	WI Unique Well # of Removed Well ____ GP8 ____	Facap #	Facility Name <b>Appleton Wire-Former Albany In</b>		
Latitude / Longitude (Degrees and Minutes) <b>44</b> ° <b>16.155</b> ' N		Method Code (see instructions) <b>GPS007</b>	Facility ID (FID or PWS) <b>445035910</b>		
<b>88</b> ° <b>23.71</b> ' W			License/Permit/Monitoring #		
1/4 SW    1/4 NW	Section <b>25</b>	Township <b>21 N</b>	Range <b>17</b>	Original Well Owner <b>Albany International</b>	
or Gov't Lot #			<input checked="" type="checkbox"/> E <input type="checkbox"/> W	Present Well Owner <b>Albany International</b>	
Well Street Address <b>908 N. Lawe Street</b>			Mailing Address of Present Owner <b>3601 Electric City Blvd.</b>		
Well City, Village or Town <b>Appleton</b>		Well ZIP Code <b>54911-</b>		City of Present Owner <b>Kaukauna</b>	
Subdivision Name <b>Harriman's Lawsburg Plat</b>		Lot # <b>11</b>		State <b>WI</b>	ZIP Code <b>54130-</b>
Reason For Removal From Service <b>Sampling completed</b>		WI Unique Well # of Replacement Well		<b>4. Pump, Liner, Screen, Casing &amp; Sealing Material</b>	

<b>3. Well / Drillhole / Borehole Information</b>		Original Construction Date (mm/dd/yyyy) <b>5/12/2014</b>	
<input type="checkbox"/> Monitoring Well	If a Well Construction Report is available, please attach.		
<input type="checkbox"/> Water Well			
<input checked="" type="checkbox"/> Borehole / Drillhole			
Construction Type:			
<input type="checkbox"/> Drilled	<input type="checkbox"/> Driven (Sandpoint)	<input type="checkbox"/> Dug	
<input checked="" type="checkbox"/> Other (specify): <b>Vibratory push sampler</b>			
Formation Type:			
<input checked="" type="checkbox"/> Unconsolidated Formation		<input type="checkbox"/> Bedrock	
Total Well Depth From Ground Surface (ft.) <b>15</b>	Casing Diameter (in.)		
Lower Drillhole Diameter (in.) <b>2</b>	Casing Depth (ft.)		
Was well annular space grouted? <input type="checkbox"/> Yes <input checked="" type="checkbox"/> No <input type="checkbox"/> Unknown			
If yes, to what depth (feet)?	Depth to Water (feet)		

<b>5. Material Used To Fill Well / Drillhole</b>			
	From (ft.)	To (ft.)	Sacks Sealant
Concrete	Surface	0.5	
Granular Bentonite	0.5	15	0.5

**6. Comments**

Push probe soil sample boring abandonment

<b>7. Supervision of Work</b>			<b>DNR Use Only</b>	
Name of Person or Firm Doing Filling & Sealing <b>David Casper-Badger Labs &amp; Engineering Inc</b>	License #	Date of Filling & Sealing (mm/dd/yyyy) <b>5/12/2014</b>	Date Received	Noted By
Street or Route <b>501 W. Bell Street</b>		Telephone Number <b>(920) 729-1100</b>	Comments	
City <b>Neenah</b>	State <b>WI</b>	ZIP Code <b>54956-</b>	Signature of Person Doing Work <i>David J. Casper</i>	Date Signed <b>7/5/2016</b>

Notice: Completion of this report is required by chs. 160, 281, 283, 289, 291-293, 295, and 299, Wis. Stats., and ch. NR 141, Wis. Adm. Code. In accordance with chs. 281, 289, 291-293, 295, and 299, Wis. Stats., failure to file this form may result in a forfeiture of between \$10-25,000, or imprisonment for up to one year, depending on the program and conduct involved. Personally identifiable information on this form is not intended to be used for any other purpose. Return form to the appropriate DNR office and bureau. See instructions on reverse for more information.

Verification Only of Fill and Seal

Route to:  
 Drinking Water     Watershed/Wastewater     Remediation/Redevelopment  
 Waste Management     Other: \_\_\_\_\_

<b>1. Well Location Information</b>			<b>2. Facility / Owner Information</b>		
County <b>OUTAGAMIE</b>	WI Unique Well # of Removed Well _____ GP9	Facap #	Facility Name Appleton Wire-Former Albany In		
Latitude / Longitude (Degrees and Minutes) 44 ° 16.155 ' N		Method Code (see instructions) GPS007	Facility ID (FID or PWS) 445035910		
88 ° 23.71 ' W			License/Permit/Monitoring #		
1/4 SW	1/4 NW	Section 25	Township 21 N	Range 17	<input checked="" type="checkbox"/> E <input type="checkbox"/> W
Well Street Address 908 N. Lawe Street			Original Well Owner Albany International		
Well City, Village or Town Appleton			Present Well Owner Albany International		
Well ZIP Code 54911-			Mailing Address of Present Owner 3601 Electric City Blvd.		
Subdivision Name Harriman's Lawsburg Plat			City of Present Owner Kaukauna	State WI	ZIP Code 54130-
Reason For Removal From Service Sampling completed			<b>4. Pump, Liner, Screen, Casing &amp; Sealing Material</b>		
WI Unique Well # of Replacement Well			Pump and piping removed? <input type="checkbox"/> Yes <input type="checkbox"/> No <input checked="" type="checkbox"/> N/A		
			Liner(s) removed? <input type="checkbox"/> Yes <input type="checkbox"/> No <input checked="" type="checkbox"/> N/A		
			Screen removed? <input type="checkbox"/> Yes <input type="checkbox"/> No <input checked="" type="checkbox"/> N/A		
			Casing left in place? <input type="checkbox"/> Yes <input type="checkbox"/> No <input checked="" type="checkbox"/> N/A		
			Was casing cut off below surface? <input type="checkbox"/> Yes <input type="checkbox"/> No <input checked="" type="checkbox"/> N/A		
			Did sealing material rise to surface? <input type="checkbox"/> Yes <input type="checkbox"/> No <input checked="" type="checkbox"/> N/A		
			Did material settle after 24 hours? <input type="checkbox"/> Yes <input type="checkbox"/> No <input checked="" type="checkbox"/> N/A		
			If yes, was hole retopped? <input type="checkbox"/> Yes <input type="checkbox"/> No <input checked="" type="checkbox"/> N/A		
			If bentonite chips were used, were they hydrated with water from a known safe source? <input checked="" type="checkbox"/> Yes <input type="checkbox"/> No <input type="checkbox"/> N/A		

<b>3. Well / Drillhole / Borehole Information</b>		
<input type="checkbox"/> Monitoring Well	Original Construction Date (mm/dd/yyyy) 5/12/2014	
<input type="checkbox"/> Water Well	If a Well Construction Report is available, please attach.	
<input checked="" type="checkbox"/> Borehole / Drillhole		
Construction Type: <input type="checkbox"/> Drilled <input type="checkbox"/> Driven (Sandpoint) <input type="checkbox"/> Dug <input checked="" type="checkbox"/> Other (specify): Vibratory push sampler		
Formation Type: <input checked="" type="checkbox"/> Unconsolidated Formation <input type="checkbox"/> Bedrock		
Total Well Depth From Ground Surface (ft.) 20	Casing Diameter (in.)	
Lower Drillhole Diameter (in.) 2	Casing Depth (ft.)	
Was well annular space grouted? <input type="checkbox"/> Yes <input checked="" type="checkbox"/> No <input type="checkbox"/> Unknown		
If yes, to what depth (feet)?	Depth to Water (feet)	

<b>5. Material Used To Fill Well / Drillhole</b>			
Concrete	From (ft.) Surface	To (ft.) 0.5	Sacks Sealant
Granular Bentonite	0.5	20	0.75
<b>6. Comments</b> Push probe soil sample boring abandonment			

<b>Required Method of Placing Sealing Material</b>		
<input type="checkbox"/> Conductor Pipe-Gravity	<input type="checkbox"/> Conductor Pipe-Pumped	
<input checked="" type="checkbox"/> Screened & Poured (Bentonite Chips)	<input type="checkbox"/> Other (Explain): _____	
<b>Sealing Materials</b>		
<input type="checkbox"/> Neat Cement Grout	<input type="checkbox"/> Clay-Sand Slurry (11 lb/gal. wt.)	
<input type="checkbox"/> Sand-Cement (Concrete) Grout	<input type="checkbox"/> Bentonite-Sand Slurry " "	
<input checked="" type="checkbox"/> Concrete	<input type="checkbox"/> Bentonite Chips	
<b>For Monitoring Wells and Monitoring Well Boreholes Only:</b>		
<input type="checkbox"/> Bentonite Chips	<input type="checkbox"/> Bentonite - Cement Grout	
<input checked="" type="checkbox"/> Granular Bentonite	<input type="checkbox"/> Bentonite - Sand Slurry	

**7. Supervision of Work**

Name of Person or Firm Doing Filling & Sealing Da	License #	Date of Filling & Sealing (mm/dd/yyyy) 5/12/2014	<b>DNR Use Only</b>	
Street or Route 501 W. Bell Street			Date Received	Noted By
City Neenah			Telephone Number (920) 729-1100	Comments
State WI	ZIP Code 54956-	Signature of Person Doing Work David J. Casper	Date Signed 7/5/2016	

Notice: Completion of this report is required by chs. 160, 281, 283, 289, 291-293, 295, and 299, Wis. Stats., and ch. NR 141, Wis. Adm. Code. In accordance with chs. 281, 289, 291-293, 295, and 299, Wis. Stats., failure to file this form may result in a forfeiture of between \$10-25,000, or imprisonment for up to one year, depending on the program and conduct involved. Personally identifiable information on this form is not intended to be used for any other purpose. Return form to the appropriate DNR office and bureau. See instructions on reverse for more information.

**Verification Only of Fill and Seal**

Route to:

Drinking Water       Watershed/Wastewater       Remediation/Redevelopment

Waste Management       Other: \_\_\_\_\_

1. Well Location Information			2. Facility / Owner Information		
County <b>OUTAGAMIE</b>	WI Unique Well # of Removed Well ____ GP10	Licap #	Facility Name <b>Appleton Wire-Former Alban Int</b>		
Latitude / Longitude (Degrees and Minutes) <b>44 - 16.155</b> 'N		Facility ID (FID or PWS) <b>445035910</b>			
<b>88 - 23.71</b> 'W		Method Code (see instructions) <b>GPS007</b>			

¼ / ¼ SW	¼ NW	Section <b>25</b>	Township <b>21 N</b>	Range <b>17</b>	[X] E <input type="checkbox"/> W	Original Well Owner <b>Albany International</b>	
Well Street Address <b>908 N. Lawe Street</b>						Present Well Owner <b>Albany International</b>	
Well City, Village or Town <b>Appleton</b>				Well ZIP Code <b>54911-</b>			
Subdivision Name <b>Harriman's Lawsburg Plat</b>				Lot # <b>11</b>			
Reason For Removal From Service <b>Sampling completed</b>		WI Unique Well # of Replacement Well _____					

**4. Pump, Liner, Screen, Casing & Sealing Material**

Pump and piping removed?	<input type="checkbox"/> Yes	<input type="checkbox"/> No	<input checked="" type="checkbox"/> N/A
Liner(s) removed?	<input type="checkbox"/> Yes	<input type="checkbox"/> No	<input checked="" type="checkbox"/> N/A
Screen removed?	<input type="checkbox"/> Yes	<input type="checkbox"/> No	<input checked="" type="checkbox"/> N/A
Casing left in place?	<input type="checkbox"/> Yes	<input type="checkbox"/> No	<input checked="" type="checkbox"/> N/A
Was casing cut off below surface?	<input type="checkbox"/> Yes	<input type="checkbox"/> No	<input checked="" type="checkbox"/> N/A
Did sealing material rise to surface?	<input type="checkbox"/> Yes	<input type="checkbox"/> No	<input checked="" type="checkbox"/> N/A
Did material settle after 24 hours?	<input type="checkbox"/> Yes	<input type="checkbox"/> No	<input checked="" type="checkbox"/> N/A
if yes, was hole retopped?	<input type="checkbox"/> Yes	<input type="checkbox"/> No	<input checked="" type="checkbox"/> N/A
If bentonite chips were used, were they hydrated with water from a known safe source?	<input checked="" type="checkbox"/> Yes	<input type="checkbox"/> No	<input type="checkbox"/> N/A

**3. Well / Drillhole / Borehole Information**

<input type="checkbox"/> Monitoring Well	Original Construction Date (mm/dd/yyyy) <b>5/12/2014</b>
<input type="checkbox"/> Water Well	
<input checked="" type="checkbox"/> Borehole / Drillhole	If a Well Construction Report is available, please attach.

Construction Type:

Drilled       Driven (Sandpoint)       Dug

Other (specify): **Vibratory push sampler**

Formation Type: <input checked="" type="checkbox"/> Unconsolidated Formation <input type="checkbox"/> Bedrock		Required Method of Placing Sealing Material	
Total Well Depth From Ground Surface (ft.) <b>15</b>	Casing Diameter (in.)	<input type="checkbox"/> Conductor Pipe-Gravity	<input type="checkbox"/> Conductor Pipe-Pumped
Lower Drillhole Diameter (in.) <b>2</b>	Casing Depth (ft.)	<input checked="" type="checkbox"/> Screened & Poured (Bentonite Chips)	<input type="checkbox"/> Other (Explain): _____
Was well annular space grouted? <input type="checkbox"/> Yes <input checked="" type="checkbox"/> No <input type="checkbox"/> Unknown	Depth to Water (feet)	Sealing Materials	
If yes, to what depth (feet)?		<input type="checkbox"/> Neat Cement Grout	<input type="checkbox"/> Clay-Sand Slurry (11 lb/gal. wt.)
		<input type="checkbox"/> Sand-Cement (Concrete) Grout	<input type="checkbox"/> Bentonite-Sand Slurry " "
		<input checked="" type="checkbox"/> Concrete	<input checked="" type="checkbox"/> Bentonite Chips
		For Monitoring Wells and Monitoring Well Boreholes Only:	
		<input type="checkbox"/> Bentonite Chips	<input type="checkbox"/> Bentonite - Cement Grout
		<input checked="" type="checkbox"/> Granular Bentonite	<input type="checkbox"/> Bentonite - Sand Slurry

5. Material Used To Fill Well / Drillhole		From (ft.)	To (ft.)	Sacks Sealant
Concrete		Surface	0.5	
Bentonite granules		0.5	15	0.5

**6. Comments**

Push probe soil sample boring abandonment

7. Supervision of Work				DNR Use Only	
Name of Person or Firm Doing Filling & Sealing <b>David Casper-Badger Labs &amp; Engineering Inc.</b>		License #	Date of Filling & Sealing (mm/dd/yyyy) <b>5/12/2014</b>	Date Received	Noted By
Street or Route <b>501 W. Bell Street</b>			Telephone Number <b>(920) 729-1100</b>	Comments	
City <b>Neenah</b>	State <b>WI</b>	ZIP Code <b>54956-</b>	Signature of Person Doing Work <i>David J. Casper</i>	Date Signed <b>7/5/2016</b>	

Notice: Completion of this report is required by chs. 160, 281, 283, 289, 291-293, 295, and 299, Wis. Stats., and ch. NR 141, Wis. Adm. Code. In accordance with chs. 281, 289, 291-293, 295, and 299, Wis. Stats., failure to file this form may result in a forfeiture of between \$10-25,000, or imprisonment for up to one year, depending on the program and conduct involved. Personally identifiable information on this form is not intended to be used for any other purpose. Return form to the appropriate DNR office and bureau. See instructions on reverse for more information.

**Verification Only of Fill and Seal**

Route to:

Drinking Water       Watershed/Wastewater       Remediation/Redevelopment

Waste Management       Other: \_\_\_\_\_

<b>1. Well Location Information</b>			<b>2. Facility / Owner Information</b>		
County <b>OUTAGAMIE</b>	WI Unique Well # of Removed Well ____ GP9 ____	Facap #	Facility Name <b>Appleton Wire-Former Albany In</b>		
Latitude / Longitude (Degrees and Minutes) <b>44 ° 16.155 ' N</b>		Method Code (see instructions) <b>GPS007</b>	Facility ID (FID or PWS) <b>445035910</b>		
<b>88 ° 23.71 ' W</b>			License/Permit/Monitoring #		
Original Well Owner <b>Albany International</b>					

1/4 SW	1/4 NW	Section <b>25</b>	Township <b>21 N</b>	Range <b>17</b>	<input checked="" type="checkbox"/> E <input type="checkbox"/> W
Well Street Address <b>908 N. Lawe Street</b>					
Well City, Village or Town <b>Appleton</b>			Well ZIP Code <b>54911-</b>		
Subdivision Name <b>Harriman's Lawsburg Plat</b>			Lot # <b>11</b>		
Reason For Removal From Service <b>Sampling completed</b>		WI Unique Well # of Replacement Well			

**4. Pump, Liner, Screen, Casing & Sealing Material**

Pump and piping removed?  Yes  No  N/A

Liner(s) removed?  Yes  No  N/A

Screen removed?  Yes  No  N/A

Casing left in place?  Yes  No  N/A

Was casing cut off below surface?  Yes  No  N/A

Did sealing material rise to surface?  Yes  No  N/A

Did material settle after 24 hours?  Yes  No  N/A

If yes, was hole retopped?  Yes  No  N/A

If bentonite chips were used, were they hydrated with water from a known safe source?  Yes  No  N/A

**3. Well / Drillhole / Borehole Information**

Monitoring Well       Water Well       Borehole / Drillhole

Original Construction Date (mm/dd/yyyy)  
**5/12/2014**

If a Well Construction Report is available, please attach.

Construction Type:

Drilled       Driven (Sandpoint)       Dug

Other (specify): **Vibratory push sampler**

Formation Type:

Unconsolidated Formation       Bedrock

Total Well Depth From Ground Surface (ft.) **20**      Casing Diameter (in.)

Lower Drillhole Diameter (in.) **2**      Casing Depth (ft.)

Was well annular space grouted?  Yes  No  Unknown

If yes, to what depth (feet)?      Depth to Water (feet)

Required Method of Placing Sealing Material

Conductor Pipe-Gravity       Conductor Pipe-Pumped

Screened & Poured (Bentonite Chips)       Other (Explain): \_\_\_\_\_

Sealing Materials

Neat Cement Grout       Clay-Sand Slurry (11 lb/gal. wt.)

Sand-Cement (Concrete) Grout       Bentonite-Sand Slurry " "

Concrete       Bentonite Chips

For Monitoring Wells and Monitoring Well Boreholes Only:

Bentonite Chips       Bentonite - Cement Grout

Granular Bentonite       Bentonite - Sand Slurry

<b>5. Material Used To Fill Well / Drillhole</b>			
Material	From (ft.)	To (ft.)	Sacks Sealant
Concrete	Surface	0.5	
Granular Bentonite	0.5	20	0.75

**6. Comments**

Push probe soil sample boring abandonment

<b>7. Supervision of Work</b>			<b>DNR Use Only</b>	
Name of Person or Firm Doing Filling & Sealing <b>Da</b>	License #	Date of Filling & Sealing (mm/dd/yyyy) <b>5/12/2014</b>	Date Received	Noted By
Street or Route <b>501 W. Bell Street</b>		Telephone Number <b>(920) 729-1100</b>	Comments	
City <b>Neenah</b>	State <b>WI</b>	ZIP Code <b>54956-</b>	Signature of Person Doing Work <i>David J. Casper</i>	Date Signed <b>7/5/2016</b>

Notice: Completion of this report is required by chs. 160, 281, 283, 289, 291-293, 295, and 299, Wis. Stats., and ch. NR 141, Wis. Adm. Code. In accordance with chs. 281, 289, 291-293, 295, and 299, Wis. Stats., failure to file this form may result in a forfeiture of between \$10-25,000, or imprisonment for up to one year, depending on the program and conduct involved. Personally identifiable information on this form is not intended to be used for any other purpose. Return form to the appropriate DNR office and bureau. See instructions on reverse for more information.

**Verification Only of Fill and Seal**

Route to:

Drinking Water       Watershed/Wastewater       Remediation/Redevelopment

Waste Management       Other: \_\_\_\_\_

1. Well Location Information			2. Facility / Owner Information		
County <b>OUTAGAMIE</b>	WI Unique Well # of Removed Well ____ GP10	Licap #	Facility Name <b>Appleton Wire-Former Alban Int</b>		
Latitude / Longitude (Degrees and Minutes) <b>44 - 16.155</b> 'N		Facility ID (FID or PWS) <b>445035910</b>			
<b>88 - 23.71</b> 'W		Method Code (see instructions) <b>GPS007</b>			

¼ / ¼ SW	¼ NW	Section <b>25</b>	Township <b>21 N</b>	Range <b>17</b>	[X] E <input type="checkbox"/> W	Original Well Owner <b>Albany International</b>	
Well Street Address <b>908 N. Lawe Street</b>						Present Well Owner <b>Albany International</b>	
Well City, Village or Town <b>Appleton</b>				Well ZIP Code <b>54911-</b>			
Subdivision Name <b>Harriman's Lawsburg Plat</b>				Lot # <b>11</b>			
Reason For Removal From Service <b>Sampling completed</b>		WI Unique Well # of Replacement Well _____					

**4. Pump, Liner, Screen, Casing & Sealing Material**

Pump and piping removed?	<input type="checkbox"/> Yes	<input type="checkbox"/> No	<input checked="" type="checkbox"/> N/A
Liner(s) removed?	<input type="checkbox"/> Yes	<input type="checkbox"/> No	<input checked="" type="checkbox"/> N/A
Screen removed?	<input type="checkbox"/> Yes	<input type="checkbox"/> No	<input checked="" type="checkbox"/> N/A
Casing left in place?	<input type="checkbox"/> Yes	<input type="checkbox"/> No	<input checked="" type="checkbox"/> N/A
Was casing cut off below surface?	<input type="checkbox"/> Yes	<input type="checkbox"/> No	<input checked="" type="checkbox"/> N/A
Did sealing material rise to surface?	<input type="checkbox"/> Yes	<input type="checkbox"/> No	<input checked="" type="checkbox"/> N/A
Did material settle after 24 hours?	<input type="checkbox"/> Yes	<input type="checkbox"/> No	<input checked="" type="checkbox"/> N/A
if yes, was hole retopped?	<input type="checkbox"/> Yes	<input type="checkbox"/> No	<input checked="" type="checkbox"/> N/A
If bentonite chips were used, were they hydrated with water from a known safe source?	<input checked="" type="checkbox"/> Yes	<input type="checkbox"/> No	<input type="checkbox"/> N/A

**3. Well / Drillhole / Borehole Information**

<input type="checkbox"/> Monitoring Well	Original Construction Date (mm/dd/yyyy) <b>5/12/2014</b>
<input type="checkbox"/> Water Well	
<input checked="" type="checkbox"/> Borehole / Drillhole	If a Well Construction Report is available, please attach.

Construction Type:

Drilled       Driven (Sandpoint)       Dug

Other (specify): **Vibratory push sampler**

Formation Type: <input checked="" type="checkbox"/> Unconsolidated Formation <input type="checkbox"/> Bedrock		Required Method of Placing Sealing Material	
Total Well Depth From Ground Surface (ft.) <b>15</b>	Casing Diameter (in.)	<input type="checkbox"/> Conductor Pipe-Gravity	<input type="checkbox"/> Conductor Pipe-Pumped
Lower Drillhole Diameter (in.) <b>2</b>	Casing Depth (ft.)	<input checked="" type="checkbox"/> Screened & Poured (Bentonite Chips)	<input type="checkbox"/> Other (Explain): _____
Was well annular space grouted? <input type="checkbox"/> Yes <input checked="" type="checkbox"/> No <input type="checkbox"/> Unknown	Depth to Water (feet)	Sealing Materials	
		<input type="checkbox"/> Neat Cement Grout	<input type="checkbox"/> Clay-Sand Slurry (11 lb/gal. wt.)
		<input type="checkbox"/> Sand-Cement (Concrete) Grout	<input type="checkbox"/> Bentonite-Sand Slurry " "
		<input checked="" type="checkbox"/> Concrete	<input checked="" type="checkbox"/> Bentonite Chips
		For Monitoring Wells and Monitoring Well Boreholes Only:	
		<input type="checkbox"/> Bentonite Chips	<input type="checkbox"/> Bentonite - Cement Grout
		<input checked="" type="checkbox"/> Granular Bentonite	<input type="checkbox"/> Bentonite - Sand Slurry

5. Material Used To Fill Well / Drillhole	From (ft.)	To (ft.)	Sacks Sealant	
Concrete	Surface	0.5		
Bentonite granules	0.5	15	0.5	

**6. Comments**

Push probe soil sample boring abandonment

7. Supervision of Work				DNR Use Only	
Name of Person or Firm Doing Filling & Sealing <b>David Casper-Badger Labs &amp; Engineering Inc.</b>	License #	Date of Filling & Sealing (mm/dd/yyyy) <b>5/12/2014</b>	Date Received	Noted By	
Street or Route <b>501 W. Bell Street</b>		Telephone Number <b>(920) 729-1100</b>	Comments		
City <b>Neenah</b>	State <b>WI</b>	ZIP Code <b>54956-</b>	Signature of Person Doing Work <i>David J. Casper</i>	Date Signed <b>7/5/2016</b>	

Notice: Completion of this report is required by chs. 160, 281, 283, 289, 291-293, 295, and 299, Wis. Stats., and ch. NR 141, Wis. Adm. Code. In accordance with chs. 281, 289, 291-293, 295, and 299, Wis. Stats., failure to file this form may result in a forfeiture of between \$10-25,000, or imprisonment for up to one year, depending on the program and conduct involved. Personally identifiable information on this form is not intended to be used for any other purpose. Return form to the appropriate DNR office and bureau. See instructions on reverse for more information.

**Verification Only of Fill and Seal**

Route to:

Drinking Water       Watershed/Wastewater       Remediation/Redevelopment

Waste Management       Other: \_\_\_\_\_

1. Well Location Information			2. Facility / Owner Information		
County <b>OUTAGAMIE</b>	WI Unique Well # of Removed Well ____ GP10	Parcel #	Facility Name Appleton Wire-Former Alban Int	Facility ID (FID or PWS) 445035910	
Latitude / Longitude (Degrees and Minutes) 44 - 16.155 'N	Method Code (see instructions) GPS007		License/Permit/Monitoring #		
88 - 23.71 'W			Original Well Owner Albany International		

1/4 SW	1/4 NW	Section 25	Township 21 N	Range 17 E	<input checked="" type="checkbox"/> E <input type="checkbox"/> W
Well Street Address 908 N. Lawe Street					
Well City, Village or Town Appleton			Well ZIP Code 54911-		
Subdivision Name Harriman's Lawsburg Plat			Lot # 11		
Reason For Removal From Service Sampling completed		WI Unique Well # of Replacement Well			

**4. Pump, Liner, Screen, Casing & Sealing Material**

Pump and piping removed?  Yes  No  N/A

Liner(s) removed?  Yes  No  N/A

Screen removed?  Yes  No  N/A

Casing left in place?  Yes  No  N/A

Was casing cut off below surface?  Yes  No  N/A

Did sealing material rise to surface?  Yes  No  N/A

Did material settle after 24 hours?  Yes  No  N/A

If yes, was hole retopped?  Yes  No  N/A

If bentonite chips were used, were they hydrated with water from a known safe source?  Yes  No  N/A

**3. Well / Drillhole / Borehole Information**

Monitoring Well  
 Water Well  
 Borehole / Drillhole

Original Construction Date (mm/dd/yyyy)  
5/12/2014

If a Well Construction Report is available, please attach.

Construction Type:  
 Drilled       Driven (Sandpoint)       Dug  
 Other (specify): Vibratory push sampler

Formation Type:  
 Unconsolidated Formation       Bedrock

Total Well Depth From Ground Surface (ft.)  
15

Casing Diameter (in.)

Lower Drillhole Diameter (in.)  
2

Casing Depth (ft.)

Was well annular space grouted?  Yes  No  Unknown

If yes, to what depth (feet)?

Depth to Water (feet)

Required Method of Placing Sealing Material:  
 Conductor Pipe-Gravity       Conductor Pipe-Pumped  
 Screened & Poured (Bentonite Chips)       Other (Explain):

Sealing Materials:  
 Neat Cement Grout       Clay-Sand Slurry (11 lb/gal. wt.)  
 Sand-Cement (Concrete) Grout       Bentonite-Sand Slurry  
 Concrete       Bentonite Chips

For Monitoring Wells and Monitoring Well Boreholes Only:  
 Bentonite Chips       Bentonite - Cement Grout  
 Granular Bentonite       Bentonite - Sand Slurry

5. Material Used To Fill Well / Drillhole	From (ft.)	To (ft.)	Sacks Sealant
Concrete	Surface	0.5	
Bentonite granules	0.5	15	0.5

**6. Comments**

Push probe soil sample boring abandonment

7. Supervision of Work			DNR Use Only	
Name of Person or Firm Doing Filling & Sealing David Casper-Badger Labs & Engineering Inc.	License #	Date of Filling & Sealing (mm/dd/yyyy) 5/12/2014	Date Received	Noted By
Street or Route 501 W. Bell Street		Telephone Number (920) 729-1100	Comments	
City Neenah	State WI	ZIP Code 54956-	Signature of Person Doing Work David J. Casper	Date Signed 7/5/2016

Notice: Completion of this report is required by chs. 160, 281, 283, 289, 291-293, 295, and 299, Wis. Stats., and ch. NR 141, Wis. Adm. Code. In accordance with chs. 281, 289, 291-293, 295, and 299, Wis. Stats., failure to file this form may result in a forfeiture of between \$10-25,000, or imprisonment for up to one year, depending on the program and conduct involved. Personally identifiable information on this form is not intended to be used for any other purpose. Return form to the appropriate DNR office and bureau. See instructions on reverse for more information.

Verification Only of Fill and Seal

Route to:

Drinking Water  
 Waste Management

Watershed/Wastewater  
 Other: \_\_\_\_\_

Remediation/Redevelopment

**1. Well Location Information** **2. Facility / Owner Information**

County: **Outagamie** WI Unique Well # of Removed Well: **GP11** Licap #: \_\_\_\_\_

Latitude / Longitude (Degrees and Minutes): **44** ° **16.155** ' N  
**88** ° **23.71** ' W Method Code (see instructions): **GPS007**

1/4 SW 1/4 NW Section: **25** Township: **21 N** Range: **17**  E  W  
or Gov't Lot # \_\_\_\_\_

Well Street Address: **908 N. Lawe Street**

Well City, Village or Town: **Appleton** Well ZIP Code: **54113-**

Subdivision Name: **Harriman's Lawsburg Plat** Lot #: **11**

Reason For Removal From Service: **Sampling Completed** WI Unique Well # of Replacement Well: \_\_\_\_\_

Facility Name: **Appleton Wire-Former Albany In**

Facility ID (FID or PWS): **445035910**

License/Permit/Monitoring #: \_\_\_\_\_

Original Well Owner: **Albany International**

Present Well Owner: **Albany International**

Mailing Address of Present Owner: **3601 Electric City Blvd.**

City of Present Owner: **Kaukauna** State: **WI** ZIP Code: **54130-**

**3. Well / Drillhole / Borehole Information**

Monitoring Well  Water Well  Borehole / Drillhole

Original Construction Date (mm/dd/yyyy): **5/12/2014**

If a Well Construction Report is available, please attach. \_\_\_\_\_

Construction Type:  
 Drilled  Driven (Sandpoint)  Dug  
 Other (specify): **Vibratory push sampler**

Formation Type:  
 Unconsolidated Formation  Bedrock

Total Well Depth From Ground Surface (ft.): **20** Casing Diameter (in.): \_\_\_\_\_

Lower Drillhole Diameter (in.): **2** Casing Depth (ft.): \_\_\_\_\_

Was well annular space grouted?  Yes  No  Unknown

If yes, to what depth (feet)? \_\_\_\_\_ Depth to Water (feet): \_\_\_\_\_

**4. Pump, Liner, Screen, Casing & Sealing Material**

Pump and piping removed?  Yes  No  N/A

Liner(s) removed?  Yes  No  N/A

Screen removed?  Yes  No  N/A

Casing left in place?  Yes  No  N/A

Was casing cut off below surface?  Yes  No  N/A

Did sealing material rise to surface?  Yes  No  N/A

Did material settle after 24 hours?  Yes  No  N/A  
if yes, was hole retopped?  Yes  No  N/A

If bentonite chips were used, were they hydrated with water from a known safe source?  Yes  No  N/A

Required Method of Placing Sealing Material:  
 Conductor Pipe-Gravity  Conductor Pipe-Pumped  
 Screened & Poured (Bentonite Chips)  Other (Explain): \_\_\_\_\_

Sealing Materials:  
 Neat Cement Grout  Clay-Sand Slurry (11 lb/gal. wt.)  
 Sand-Cement (Concrete) Grout  Bentonite-Sand Slurry " "  
 Concrete  Bentonite Chips

For Monitoring Wells and Monitoring Well Boreholes Only:  
 Bentonite Chips  Bentonite - Cement Grout  
 Granular Bentonite  Bentonite - Sand Slurry

**5. Material Used To Fill Well / Drillhole**

	From (ft.)	To (ft.)	Sacks Sealant
Concrete	Surface	0.5	
Bentonite granules	0.5	20	0.75

From (ft.)	To (ft.)	Sacks Sealant
Surface	0.5	
0.5	20	0.75

**6. Comments**

Push probe soil sample boring abandonment

**7. Supervision of Work**

Supervision of Work				DNR Use Only	
Name of Person or Firm Doing Filling & Sealing	License #	Date of Filling & Sealing (mm/dd/yyyy)	Date Received	Noted By	
David Casper, Badger Labs & Engineering Inc.		5/12/2014			
Street or Route	Telephone Number	Comments			
501 W. Bell Street	(920) 729-1100				
City	State	ZIP Code	Signature of Person Doing Work	Date Signed	
Neenah	WI	54956-	David J. Casper <i>David J. Casper</i>	7/5/2016	



Notice: Completion of this report is required by chs. 160, 281, 283, 289, 291-293, 295, and 299, Wis. Stats., and ch. NR 141, Wis. Adm. Code. In accordance with chs. 281, 289, 291-293, 295, and 299, Wis. Stats., failure to file this form may result in a forfeiture of between \$10-25,000, or imprisonment for up to one year, depending on the program and conduct involved. Personally identifiable information on this form is not intended to be used for any other purpose. Return form to the appropriate DNR office and bureau. See instructions on reverse for more information.

Verification Only of Fill and Seal

Route to:  
 Drinking Water       Watershed/Wastewater       Remediation/Redevelopment  
 Waste Management       Other: \_\_\_\_\_

1. Well Location Information			2. Facility / Owner Information		
County <b>Outagamie</b>	WI Unique Well # of Removed Well <b>GP12</b>	Locap #	Facility Name <b>Appleton Wire- Former Albany I</b>		
Latitude / Longitude (Degrees and Minutes) <b>45 . 16.155</b> 'N		Method Code (see instructions) <b>GPS007</b>	Facility ID (FID or PWS) <b>445035910</b>		
<b>88 . 23.71</b> 'W			License/Permit/Monitoring #		

$\frac{1}{4}$ SW	$\frac{1}{4}$ NW	Section <b>25</b>	Township <b>21 N</b>	Range <b>17</b>	<input checked="" type="checkbox"/> E <input type="checkbox"/> W	Original Well Owner <b>Albany International</b>
or Gov't Lot #						Present Well Owner <b>Albany International</b>
Well Street Address <b>908 N. Lawe Street</b>						Mailing Address of Present Owner <b>3601 Electric City Blvd.</b>
Well City, Village or Town <b>Appleton WI</b>			Well ZIP Code <b>54911-</b>			City of Present Owner <b>Kaukauna</b>
Subdivision Name <b>Harriman's Lawsburg Plat</b>			Lot # <b>11</b>			State <b>WI</b>
Reason For Removal From Service <b>Sampling completed</b>			WI Unique Well # of Replacement Well			ZIP Code <b>54130-</b>

3. Well / Drillhole / Borehole Information		4. Pump, Liner, Screen, Casing & Sealing Material			
<input type="checkbox"/> Monitoring Well	Original Construction Date (mm/dd/yyyy) <b>5/12/2014</b>	Pump and piping removed?	<input type="checkbox"/> Yes	<input type="checkbox"/> No	<input checked="" type="checkbox"/> N/A
<input type="checkbox"/> Water Well	If a Well Construction Report is available, please attach.	Liner(s) removed?	<input type="checkbox"/> Yes	<input type="checkbox"/> No	<input checked="" type="checkbox"/> N/A
<input checked="" type="checkbox"/> Borehole / Drillhole		Screen removed?	<input type="checkbox"/> Yes	<input type="checkbox"/> No	<input checked="" type="checkbox"/> N/A
Construction Type:		Casing left in place?	<input type="checkbox"/> Yes	<input type="checkbox"/> No	<input checked="" type="checkbox"/> N/A
<input type="checkbox"/> Drilled	<input type="checkbox"/> Driven (Sandpoint)	<input type="checkbox"/> Dug	Was casing cut off below surface?		
<input checked="" type="checkbox"/> Other (specify): <b>Vibratory Push Sampler</b>		Did sealing material rise to surface?			
Formation Type:		Did material settle after 24 hours?			
<input checked="" type="checkbox"/> Unconsolidated Formation	<input type="checkbox"/> Bedrock	If yes, was hole retopped?			
Total Well Depth From Ground Surface (ft.) <b>10</b>		Casing Diameter (in.)			
Lower Drillhole Diameter (in.) <b>2</b>		Casing Depth (ft.)			
Was well annular space grouted?		If bentonite chips were used, were they hydrated with water from a known safe source?			
<input type="checkbox"/> Yes	<input checked="" type="checkbox"/> No	<input checked="" type="checkbox"/> Yes <input type="checkbox"/> No <input type="checkbox"/> N/A			
If yes, to what depth (feet)?		Required Method of Placing Sealing Material			
Depth to Water (feet)		<input type="checkbox"/> Conductor Pipe-Gravity <input type="checkbox"/> Conductor Pipe-Pumped			
		<input checked="" type="checkbox"/> Screened & Poured (Bentonite Chips) <input type="checkbox"/> Other (Explain): _____			

5. Material Used To Fill Well / Drillhole		From (ft.)	To (ft.)	Sacks Sealant
Concrete		Surface	0.5	
Bentonite granules		0.5	10	0.33

**6. Comments**  
Push probe soil sample boring abandonment

7. Supervision of Work				DNR Use Only	
Name of Person or Firm Doing Filling & Sealing <b>David Casper Badger Labs &amp; Engineering Inc.</b>	License #	Date of Filling & Sealing (mm/dd/yyyy) <b>5/12/2014</b>	Date Received	Noted By	
Street or Route <b>501 W. Bell Street</b>		Telephone Number <b>(920) 729-1100</b>	Comments		
City <b>Neenah</b>	State <b>WI</b>	ZIP Code <b>54956-</b>	Signature of Person Doing Work <i>David J. Casper</i>	Date Signed <b>7/5/2016</b>	

Notice: Completion of this report is required by chs. 160, 281, 283, 289, 291-293, 295, and 299, Wis. Stats., and ch. NR 141, Wis. Adm. Code. In accordance with chs. 281, 289, 291-293, 295, and 299, Wis. Stats., failure to file this form may result in a forfeiture of between \$10-25,000, or imprisonment for up to one year, depending on the program and conduct involved. Personally identifiable information on this form is not intended to be used for any other purpose. Return form to the appropriate DNR office and bureau. See instructions on reverse for more information.

Verification Only of Fill and Seal

Route to:  
 Drinking Water       Watershed/Wastewater       Remediation/Redevelopment  
 Waste Management       Other: \_\_\_\_\_

**1. Well Location Information**      **2. Facility / Owner Information**

County: **OUTAGAMIE**      WI Unique Well # of Removed Well: **GP13**      Hicap #

Latitude / Longitude (Degrees and Minutes):  
**44** ° **16.155** ' N  
**88** ° **23.71** ' W      Method Code (see instructions): **GPS007**

1/4 SW    1/4 NW    Section: **25**    Township: **21 N**    Range: **17**     E     W  
 or Gov't Lot #

Well Street Address: **908 N. Lawe Street**

Well City, Village or Town: **Appleton Wisconsin**      Well ZIP Code: **54911-**

Subdivision Name: **Harriman's Lawsburg Plat**      Lot #: **11**

Reason For Removal From Service: **Sampling completed**      WI Unique Well # of Replacement Well

Facility Name: **Appleton Wire-Former Albany In**

Facility ID (FID or PWS): **445035910**

License/Permit/Monitoring #

Original Well Owner: **Albany International**

Present Well Owner: **Albany International**

Mailing Address of Present Owner: **3601 Electric City Blvd.**

City of Present Owner: **Kaukauna**      State: **Wi**      ZIP Code: **54130-**

**3. Well / Drillhole / Borehole Information**

Monitoring Well      Original Construction Date (mm/dd/yyyy): **5/12/2014**

Water Well

Borehole / Drillhole      If a Well Construction Report is available, please attach.

Construction Type:  
 Drilled     Driven (Sandpoint)     Dug  
 Other (specify): **Vibratory push sampler**

Formation Type:  
 Unconsolidated Formation     Bedrock

Total Well Depth From Ground Surface (ft.): **11**      Casing Diameter (in.)

Lower Drillhole Diameter (in.): **2**      Casing Depth (ft.)

Was well annular space grouted?     Yes     No     Unknown

If yes, to what depth (feet)?      Depth to Water (feet): **6**

**4. Pump, Liner, Screen, Casing & Sealing Material**

Pump and piping removed?     Yes     No     N/A

Liner(s) removed?     Yes     No     N/A

Screen removed?     Yes     No     N/A

Casing left in place?     Yes     No     N/A

Was casing cut off below surface?     Yes     No     N/A

Did sealing material rise to surface?     Yes     No     N/A

Did material settle after 24 hours?     Yes     No     N/A

If yes, was hole retopped?     Yes     No     N/A

If bentonite chips were used, were they hydrated with water from a known safe source?     Yes     No     N/A

Required Method of Placing Sealing Material:  
 Conductor Pipe-Gravity     Conductor Pipe-Pumped  
 Screened & Poured (Bentonite Chips)     Other (Explain): \_\_\_\_\_

Sealing Materials:  
 Neat Cement Grout     Clay-Sand Slurry (11 lb/gal. wt.)  
 Sand-Cement (Concrete) Grout     Bentonite-Sand Slurry " "     Concrete     Bentonite Chips

For Monitoring Wells and Monitoring Well Boreholes Only:  
 Bentonite Chips     Bentonite - Cement Grout  
 Granular Bentonite     Bentonite - Sand Slurry

5. Material Used To Fill Well / Drillhole		From (ft.)	To (ft.)	Sacks Sealant
New concrete		Surface	0.5	
Bentonite granules		0.5	11	0.33

**6. Comments**  
 Push probe soil boring abandonment and temp well removal

**7. Supervision of Work**      **DNR Use Only**

Name of Person or Firm Doing Filling & Sealing <b>David Casper, Badger Laboratories &amp; Eng. Inc</b>	License #	Date of Filling & Sealing (mm/dd/yyyy) <b>5/13/2014</b>	Date Received	Noted By
Street or Route <b>501 W Bell Street</b>	Telephone Number <b>(920) 729-1100</b>	Comments		
City <b>Neenah</b>	State <b>WI</b>	ZIP Code <b>54956-</b>	Signature of Person Doing Work <i>David J. Casper</i>	Date Signed <b>7/5/2016</b>

Project Photos



Looking west on south side of warehouse at overhead door to manufacturing area. Chemical storage room on left. MW-21 & 21A installed just to lift of green machinery in background



Looking north along west wall of warehouse from overhead door at the north wall of the warehouse. Wall on left separates warehouse area from manufacturing



Looking west at wall that separates manufacturing area from warehouse. Wall at right is the south wall of chemical storage room. Door at left opens onto the parking lot area on the south of the warehouse



Looking east on south side of warehouse. Basement area fence is in background.



Looking east on north side of warehouse.



Geoprobe rig positioned on groundfloor above basement



Basement floor penetrations were performed from above by passing push sampler through the opening in the floor

## Property Ownership Documentation




Lot D. 2.73 + A.


CHICAGO & NORTH WESTERN RAILWAY



1890 Plat Map of the area

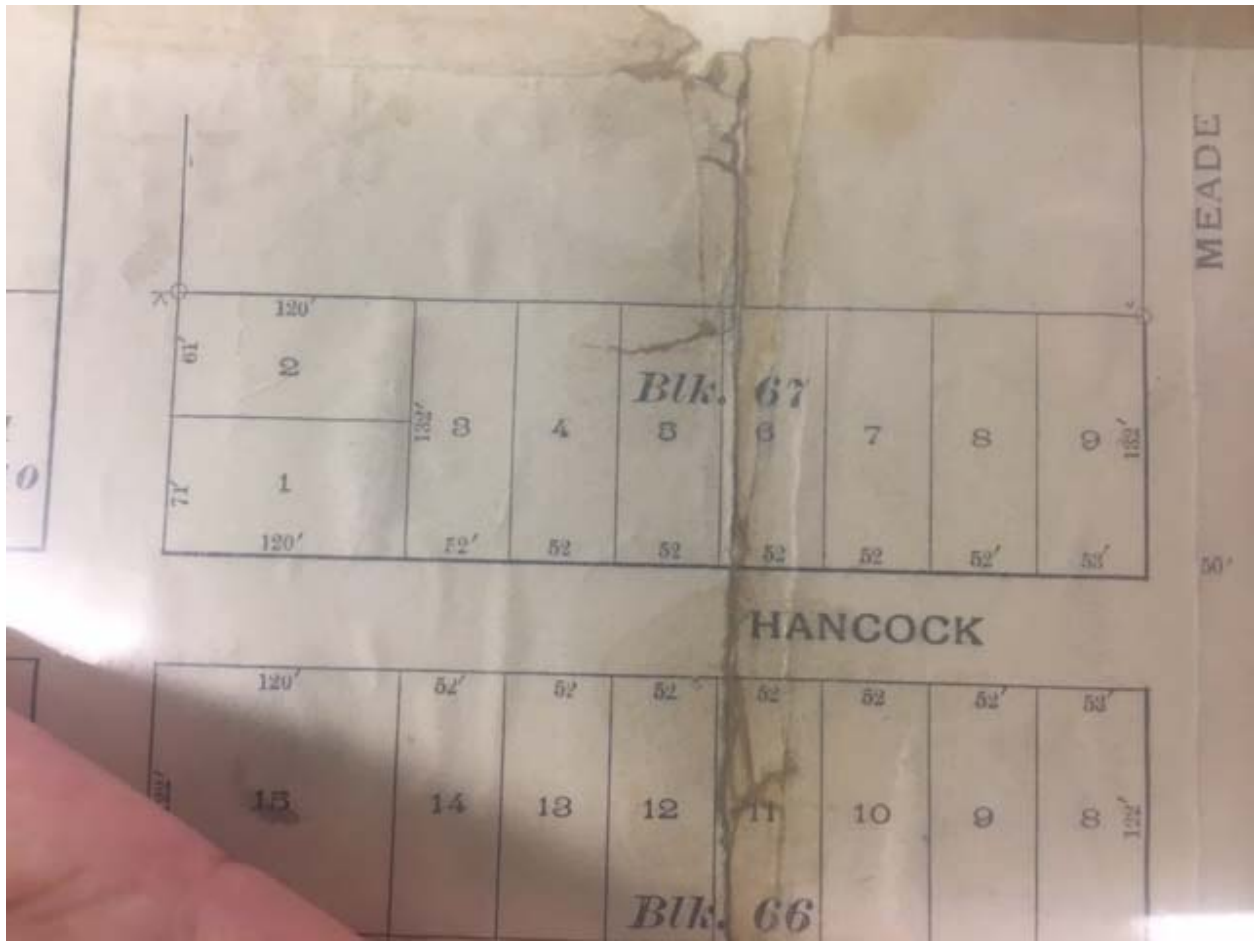

C1890 Plat Map of Lots comprising the site

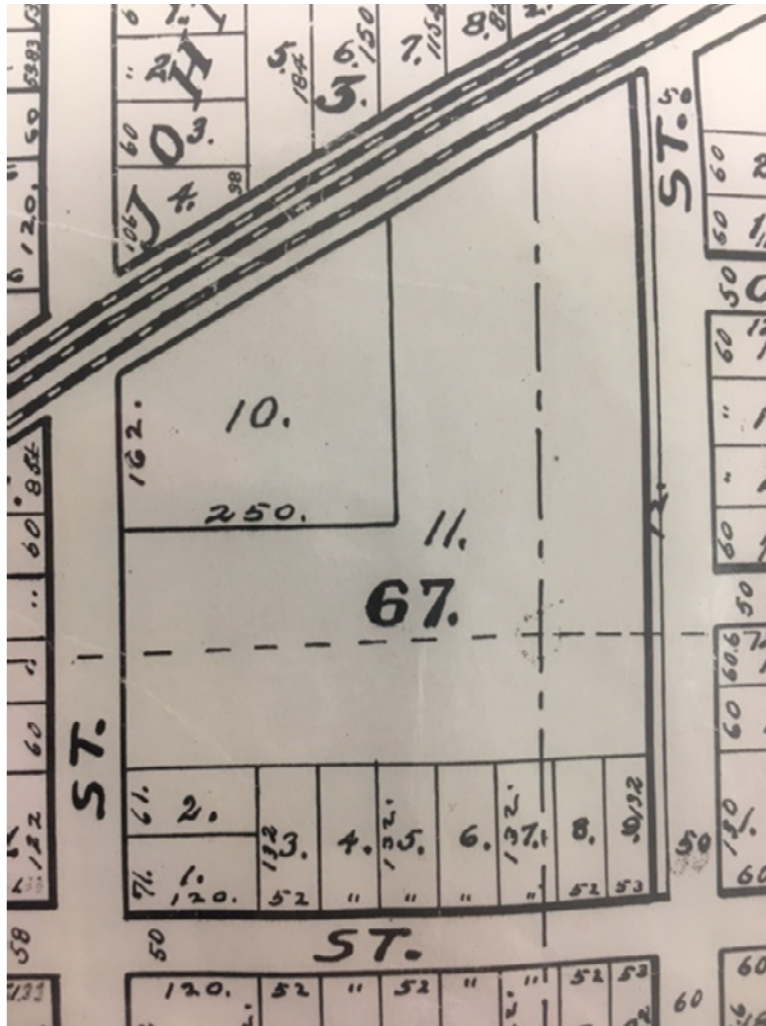

1907 Survey Map

858279

WARRANTY DEED  
J 5184 I 12

REGISTER'S OFFICE  
OUTAGAMIE COUNTY, WI.  
RECEIVED AND RECORDED ON

JAN 31 1985

AT 8:45 O'CLOCK A.M.  
IN JACKET 5184 IMAGE 13  
Grace Berk of  
REGISTER OF DEEDS

This Deed, made between Albany International Corp., a New York Corporation and Appleton Papers Inc., a Delaware Corporation, Grantor,

Grantee,  
Witnesseth, That the said Grantor, for a valuable consideration of \$1.00 and other good and valuable consideration conveys to Grantee the following described real estate in Outagamie County, State of Wisconsin:

RETURN TO:  
E. F. Bush, Jr.  
P.O. Box 359  
Appleton, WI 54912

Tax Parcel No: .....

See back side for legal description.

TRANSFER  
\$ 1800.00  
FEE

6.00  
1800.00

This is not homestead property.  
(is) (is not)

Together with all and singular the hereditaments and appurtenances thereunto belonging; And Albany International Corp. warrants that the title is good, indefeasible in fee simple and free and clear of encumbrances except for easements, covenants, restrictions and other matters of record, as well as municipal and zoning ordinances

and will warrant and defend the same.

Dated this 4th day of January, 1985.

ALBANY INTERNATIONAL CORP.  
By: Francis L. McKone (SEAL) President  
By: John K. Gschwind (SEAL) Vice President

AUTHENTICATION

Signature(s) .....

authenticated this ..... day of ....., 19.....

TITLE: MEMBER STATE BAR OF WISCONSIN  
(If not, authorized by § 706.06, Wis. Stats.)

THIS INSTRUMENT WAS DRAFTED BY  
Attorney Richard B. Schoenbohm  
Appleton, Wisconsin  
(Signatures may be authenticated or acknowledged. Both are not necessary.)

ACKNOWLEDGMENT

STATE OF WISCONSIN NEW YORK

Albany County, ss.

Personally came before me this 4th day of January, 1985, the above named Francis L. McKone, President of Albany International Corp.; and John K. Gschwind, Vice President of Albany International Corp.

to me known to be the person(s) who executed the foregoing instrument and acknowledge the same.

Notary Public ..... County, Wis.  
My Commission is permanent. (If not, state expiration date: ..... 19.....)  
DANIE C. WILLIAMS  
Notary Public, State of New York  
Residing in Albany County

# J 5184 I 13

## PARCEL 1

All that part of Lots Three (3), Four (4), Five (5), Six (6), Seven (7) and Eight (8), all of Lot Nine (9), Block Sixty-seven (67), HARRIMAN'S LAWSBURG PLAT, City of Appleton, according to the recorded Assessor's Map of said City, Outagamie County, Wisconsin, more fully described as follows: Commencing at the Southwest corner of Lot 1, of Block 67; thence S 89°21'40" E, along the South line of said Lot and Block 120.26 feet to the Southeast corner of Lot 1 and point of beginning; thence continuing S 89°21'40" E along the South line of said Block 67, 365.82 feet to the Southeast corner of Lot 9; thence N 00°48'05" E, along the East line of said Lot 9, 132.00 feet to the Northeast corner of said lot; thence N 89°21'40" W, along the North line of lots 9 and 8, 96.40 feet; thence S 00°48'05" W, 9.30 feet; thence N 89°21'40" W, 16.00 feet; thence S 00°48'05" W, 21.50 feet; thence N 89°21'40" W, 253.49 feet to a point on the east line of Lot 2; thence S 00°45'46" W, along the east line of Lots 2 and 1, 101.20 feet to the point of beginning.

Also the North  $\frac{1}{4}$  of Lot 15, Block 66, of Harriman's Lawsburg Plat, in the City of Appleton, Outagamie County, Wisconsin, according to the recorded Assessor's Map.

## PARCEL 2

The East  $\frac{1}{4}$  of Lot One (1) of Block Sixty-seven (67) of HARRIMAN'S LAWSBURG PLAT, City of Appleton, Outagamie County, Wisconsin, according to the recorded Assessor's Map of said City, more fully described as follows: Commencing at the Southwest corner of Lot 1, Block 67; thence S 89°21'40" E, along the South line of said Lot and Block 60.13 feet to the point of beginning; thence N 00°45'17" E, 71.00 feet to a point on the North line of said Lot 1; thence S 89°21'40" E, along the said North line, 60.14 feet to the Northeast corner of said Lot 1; thence S 00°45'46" W, along the East line of said Lot 71.00 feet to the Southeast corner of said lot; thence N 89°21'40" W, along the South line of said Lot 1, 60.13 feet to the point of beginning.

858277

QUIT CLAIM DEED

AND  
RELEASE OF RIGHTS AND REMEDIES

REGISTER'S OFFICE  
OUTAGAMIE COUNTY, WI.  
RECEIVED AND RECORDED ON

JAN 31 1985

AT 8:45 O'CLOCK A.M.  
IN JACKET 5184 IMAGE 8-9  
Grace Hunt  
REGISTER OF DEEDS

RETURN TO:  
E. F. Bush, Jr.  
P.O. Box 359  
Appleton, WI 54912

11378

Albany International Corp., a New York Corporation, releases, and  
quit claims to, Valleycast, Inc., a Wisconsin corporation, and its  
successors and assigns, any rights, remedies or interest it may have  
as a result of an Adjacent Property Owners Agreement, dated December 30, 1983, and recorded April 23, 1984, in the office  
of the Register of Deeds for Outagamie County, in Jacket 4559 at  
Image 5-23 as Document No. 843142, including any interest in  
the following described real estate in Outagamie County,  
State of Wisconsin:

Tax Parcel No: .....

See reverse side for the Legal Description.

Separate easements have been executed and recorded pursuant to said Adjacent  
Property Owners Agreement; and all of the duties and obligations of the Grantee  
herein have been performed or otherwise discharged and satisfied. Therefore,  
this Quit Claim Deed is made to release any rights, remedies or interest of Grantor  
herein, its successors and assigns, may have as a result of said Adjacent Property  
Owners Agreement.

FEE  
# 3  
EXEMPT

6.00/E  
form

This is not homestead property.  
(is) (is not)

Dated this 18th day of January, 1985

ALBANY INTERNATIONAL CORP.

(SEAL)

By: Manfred F. Kincaid, Vice, President (SEAL)

(SEAL)

By: David F. McConaughy, Vice, President (SEAL)

AUTHENTICATION

Signature(s) .....

authenticated this ..... day of ....., 19.....

TITLE: MEMBER STATE BAR OF WISCONSIN

(If not, authorized by § 706.06, Wis. Stats.)

THIS INSTRUMENT WAS DRAFTED BY

Attorney Richard B. Schoenbohm  
Appleton, Wisconsin

(Signatures may be authenticated or acknowledged. Both  
are not necessary.)

ACKNOWLEDGMENT

STATE OF WISCONSIN NEW YORK

Albany County, ss.

Personally came before me this 18th day of  
January, 1985 the above named  
Manfred F. Kincaid, Vice President, and  
David F. McConaughy, Vice President,  
of Albany International Corp.

to me known to be the person who executed the  
foregoing instrument and acknowledge the same.

David S. Williams  
Notary Public Albany Co., New York  
My Commission is permanent. (If not, state expiration  
date: March 30, 1986)

4

All that part of Lots Two (2), Three (3), Four (4), Five (5), Six (6), Seven (7), Eight (8), Ten (10) and Eleven (11), Block Sixty-seven (67), HARRIMAN'S LAWSBURG PLAT, City of Appleton, Outagamie County, Wisconsin, according to the recorded Assessors Map of said City more fully described as follows: Commencing at the Southwest corner of Lot 1 and Block 67; thence  $N00^{\circ}44'43''E$ , along the west line of Lot 1 and Block 67, 11.00 feet to the Southwest corner of Lot 2, and the point of beginning; thence continuing  $N00^{\circ}44'43''E$ , along the west line of Lots 2, 11, and 10 of said Block 67, 418.87 feet to the point of intersection of the west line of Lot 10 and the Southerly right-of-way line of the Chicago and Northwestern Railway Company; thence  $N61^{\circ}14'50''E$ , along the southerly line of said railroad, 201.06 feet to a point that lies 175.00 feet east of the west line of Lot 10, measured at right angles to the said west line; thence  $S00^{\circ}44'43''W$ , parallel with the said west line of Lot 10, 161.00 feet; thence  $S89^{\circ}15'17''E$ , 84.48 feet; thence  $S00^{\circ}48'05''W$ , 121.00 ft.; thence  $S89^{\circ}15'17''E$ , 227.00 feet to a point on the east line of Lot 11, Block 67; thence  $S00^{\circ}48'05''W$ , along the said east line, 173.97 feet to the southeast corner of said Lot 11; thence  $N89^{\circ}21'40''W$ , along the south line of said Lot 11, 96.40 feet; thence  $S00^{\circ}48'05''W$ , 9.30 feet; thence  $N89^{\circ}21'40''W$ , 16.00 feet; thence  $S00^{\circ}48'05''W$ , 21.50 feet; thence  $N89^{\circ}21'40''W$ , 253.49 feet to a point on the east line of Lot 2; thence  $S00^{\circ}45'46''W$ , along the east line of Lot 2, 10.20 feet to the southeast corner of Lot 2; thence  $N89^{\circ}21'40''W$ , along the south line of Lot 2, 120.28 feet to the point of beginning.

Parcel# 311 114500

Municipality CITY OF APPLETON

Owners Name....: LUVATA APPLETON LLC

Mail to Name...: LUVATA APPLETON LLC

Line 2.....: PO BOX 1714

Line 3.....:

Line 4.....:

Line 5.....:

City.....: APPLETON

State/Zip.....: WI / 54912 - 1714

Property Street: 908 N LAWE ST

Property Muni...: CITY OF APPLETON

Prop State/Zip.: WI / 54912 - 1714

Sort/Search Address:

Street.....: LAWE ST

Dir/No.....: N 908

Dir/No.....:

Fire Sign.....:

Personal/Real...: R

Label Code: Addr:

Legal:

Acre: .00 Land:

Imp:

Document #...:

S/T/R.....:

History.....:

Alt. Key.....:

Assessed With:

Legal Description  
HARRIMANS LAWSBURG PLA  
T 1WD LESS E75FT OF  
107D541 OF LOT 10 LOT  
11 LESS E227FT M/L OF  
N456FT M/L AS MEASURED  
ON E/L BLK 67 LOT 2  
N30.8FT OF LOTS 3-6  
N30.8FT OF W44.6FT OF  
LOT 7 N9.30FT OF  
E7.40FT LOT 7 N9.30FT

F3=Exit F4=Tax Info F6=Legal F7=Land Val F9=District F10=Notes  
F15=Owners F16=Addresses F17=Streets F18=History F19=User Fields Rollup/Down



1273734

DOCUMENT NUMBER

**WARRANTY DEED**

Jewish Orthodox Beth Israel Congregation, formerly known as the Hebrew Orthodox Congregation of Appleton, Wisconsin, conveys and warrants to **Appleton Papers Inc.**, a Delaware corporation, the following described real estate in Outagamie County, Wisconsin:

The West Sixty (60) feet of Lot One (1), Block Sixty-seven (67), Harriman's Lawsburg Plat, City of Appleton, Outagamie County, Wisconsin, according to the recorded Assessors Plat of said City.

**THIS IS NOT HOMESTEAD PROPERTY**

TRANSFER  
\$ 75.00  
FEE

OUTAGAMIE COUNTY  
RECEIVED FOR RECORD

MAY 29 1998

AT 2 O'CLOCK A.M. P.M.  
USAGE HERE  
REGISTER OF DEEDS

THIS SPACE RESERVED FOR RECORDING DATA

NAME AND RETURN ADDRESS  
Edwin F. Bush, II, Attorney at Law,  
330 West College Ave., Third Floor  
Appleton, WI 54911

31-1-1137-00-0  
PARCEL IDENTIFICATION NUMBER

**EXCEPTIONS TO WARRANTIES:** Municipal and zoning ordinances and agreements entered under them, recorded easements for the distribution of utility and municipal services, recorded building and use restrictions and covenants, and general taxes levied in the year of closing..

Dated this 28 day of May, A.D., 1998

Jewish Orthodox Beth Israel Congregation

By: Sydney S. Jacobson (SEAL)  
Sydney S. Jacobson

By: \_\_\_\_\_ (SEAL)

**AUTHENTICATION**

Signature of Sydney S. Jacobson and  
\_\_\_\_\_ authenticated this 28th day of  
May, 1998

Edwin F. Bush, II  
Edwin F. Bush, II, Member State Bar of Wisconsin

**ACKNOWLEDGMENT**

State of Wisconsin, )  
) ss.  
Outagamie County, )

Personally came before me this \_\_\_\_ day of \_\_\_\_\_, 1998, the  
above named \_\_\_\_\_ and  
\_\_\_\_\_ to me known to be the  
person(s) who executed the foregoing instrument and acknowledged  
the same.

This instrument was drafted by:  
Edwin F. Bush, II, Attorney at Law (No. 01012991)  
330 West College Avenue  
Appleton, Wisconsin 54911  
920-993-0760/Fax: 920-993-0761

Notary Public, \_\_\_\_\_ County, Wis.

My commission \_\_\_\_\_

Warranty Deed Property Transfer

Appleton Papers Inc. Property



City of Appleton Utilities Drawing Files

For Hancock and Meade Streets

Includes



Sanitary Sewer, Storm Sewer, and Water

PERMIT  
BY  
DATE  
REVISIONS

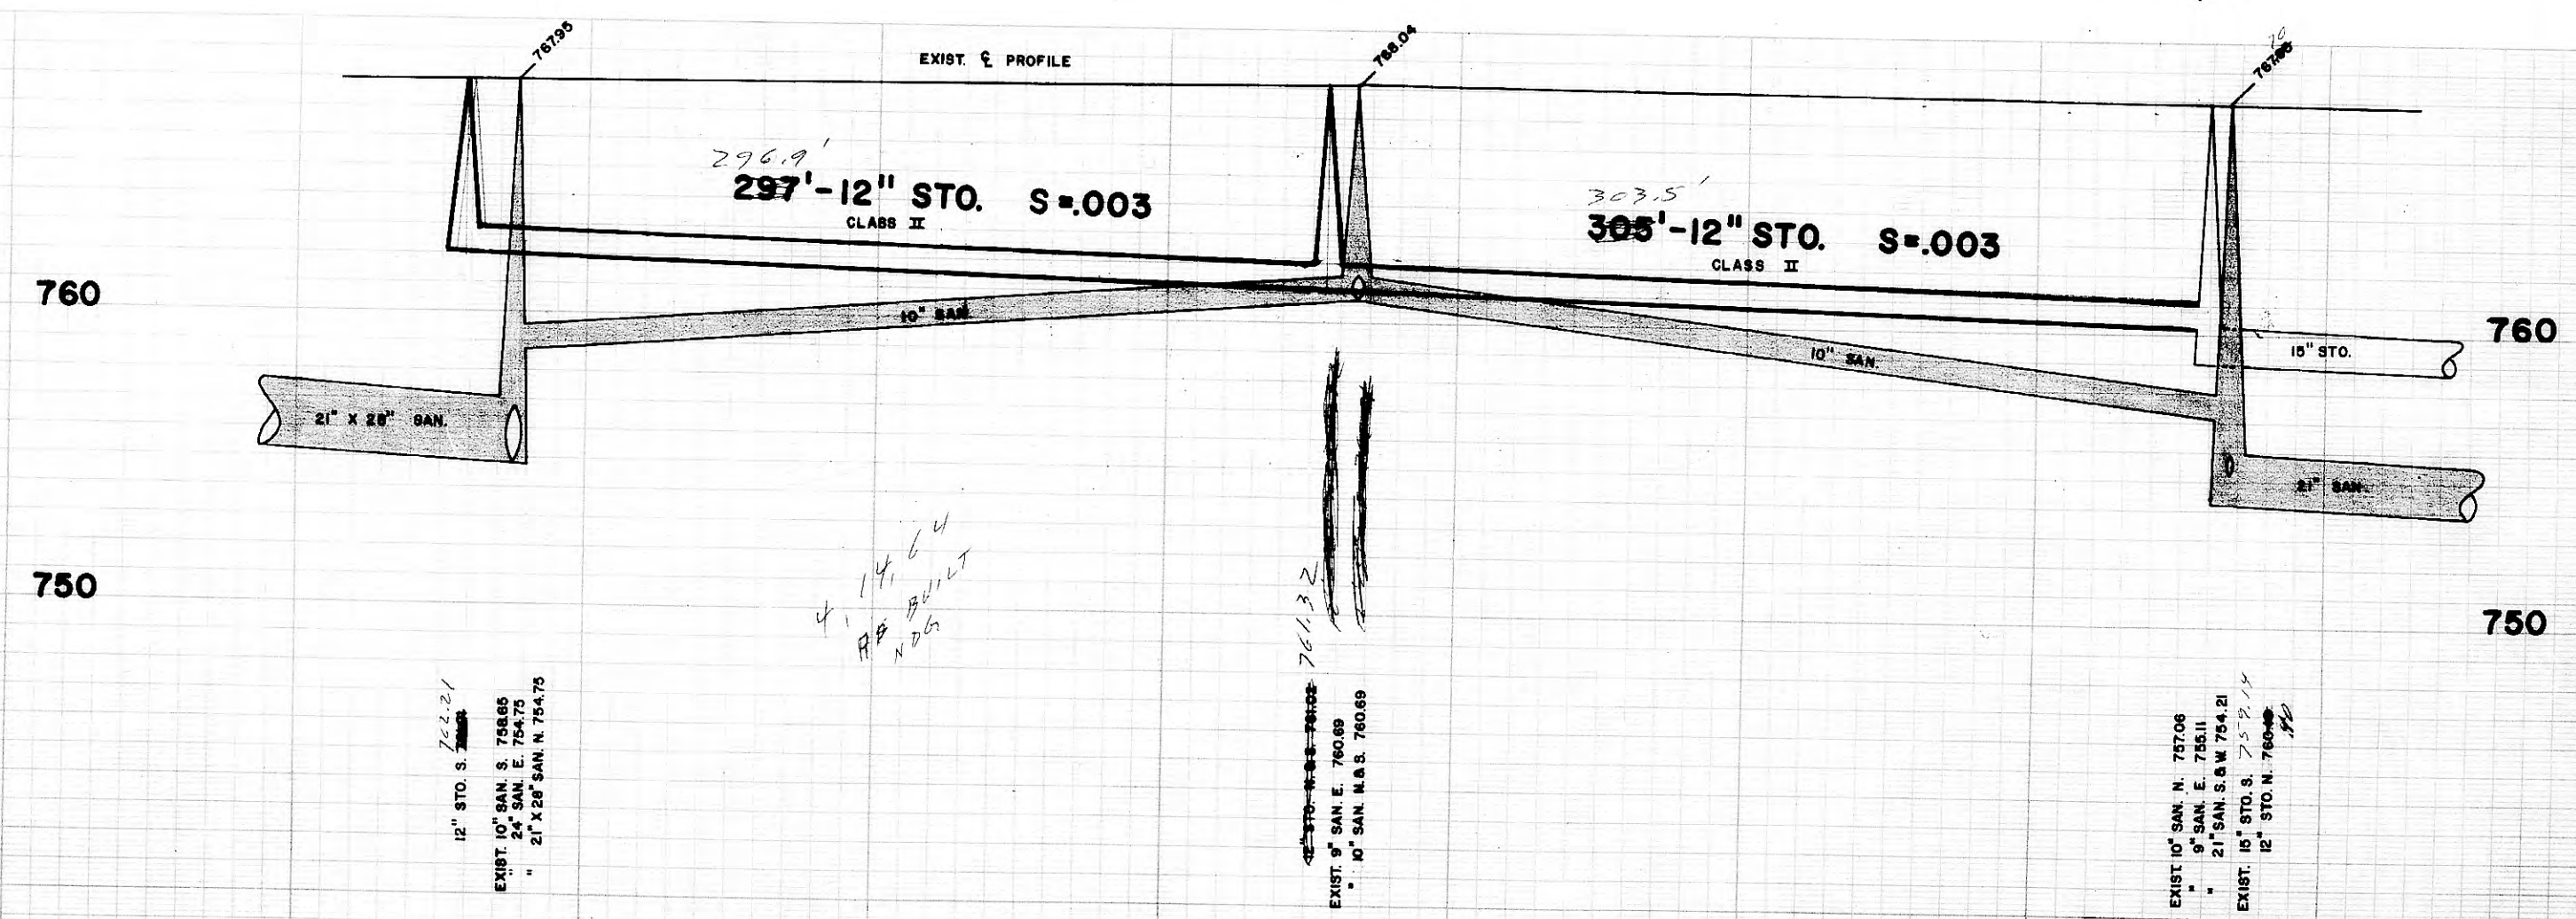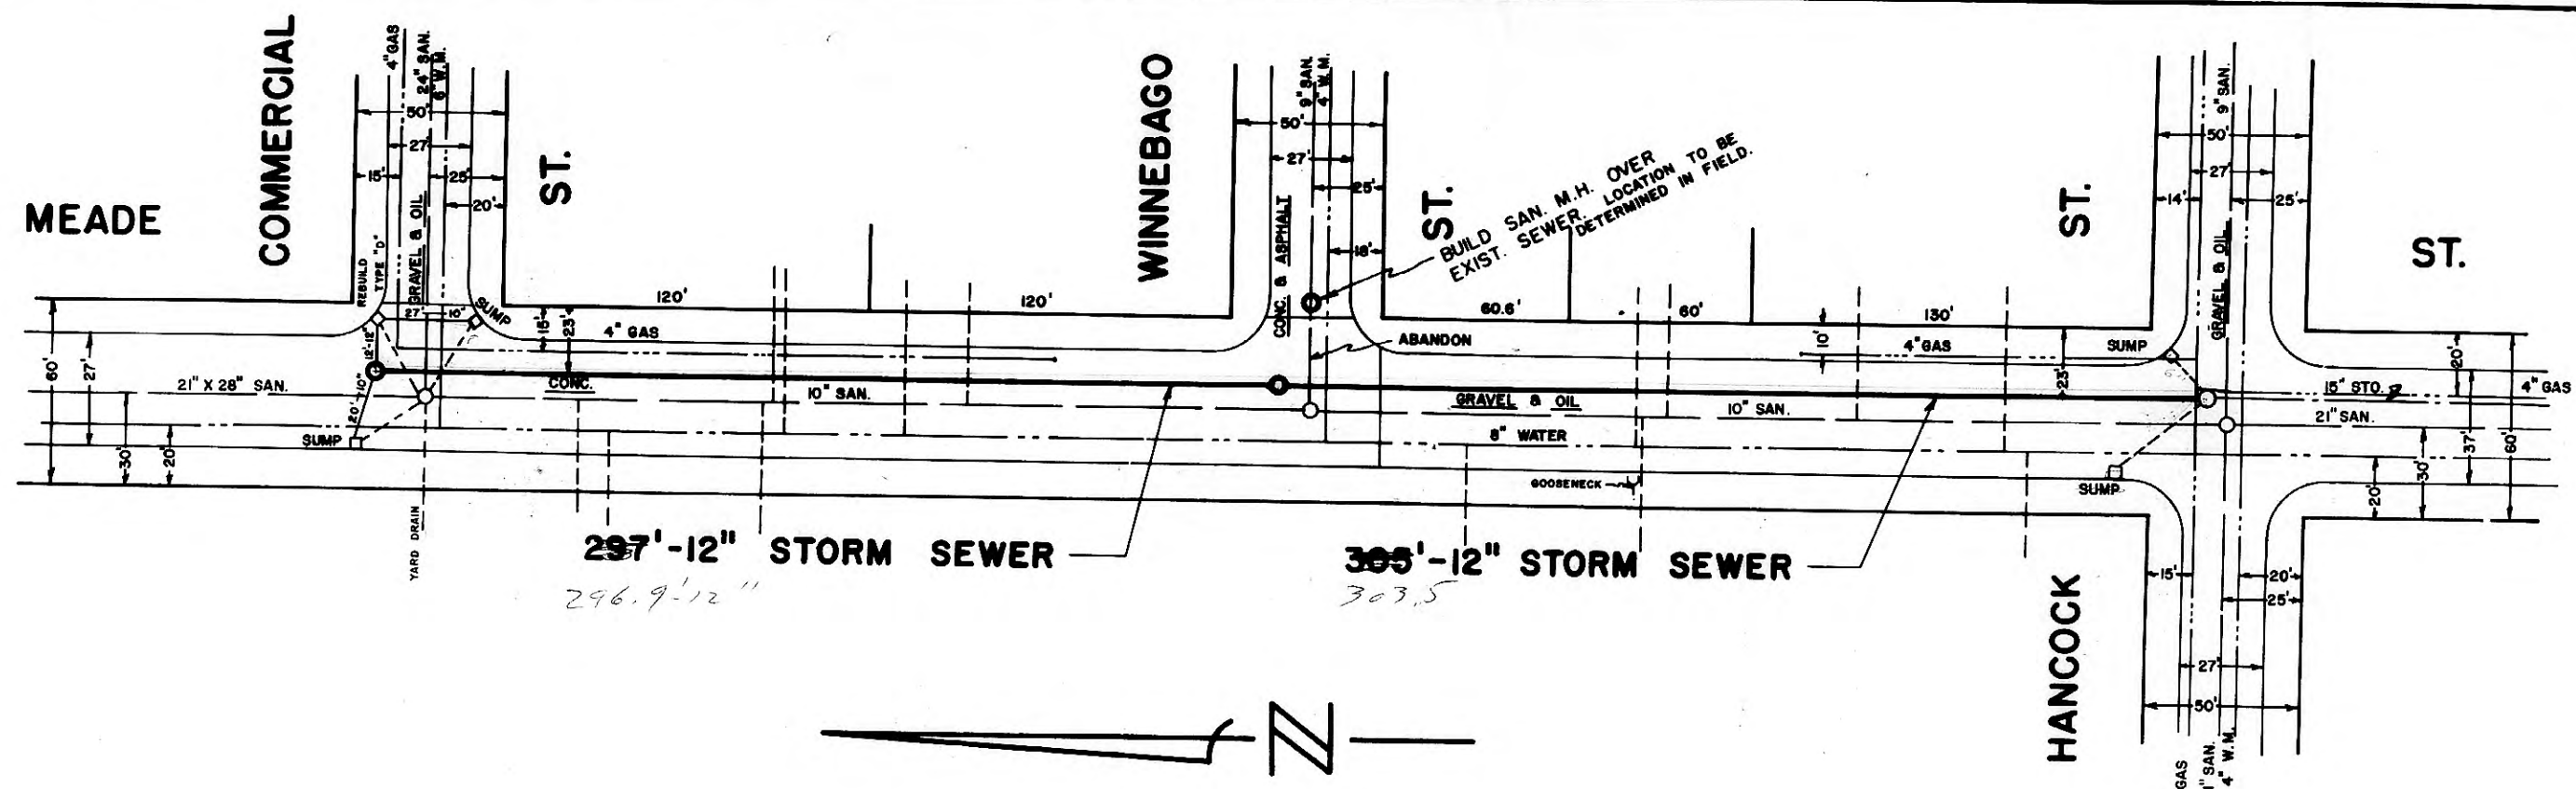

EST. QUANTITIES		CITY OF APPLETON, WISCONSIN	
602'-12" CONC. PIPE		ENGINEERING DIVISION	
3M.H. - 20 VER. FT.		<b>STORM SEWER</b>	
1 - TYPE "D" INLET		IN	
47'-10" INLET LEAD		<b>MEADE STREET</b>	
12'-12" INLET LEAD		HANCOCK ST. TO COMMERCIAL ST.	
		DWN. M.V.D. CWD P.H.K.	DWG NO.
		DATE 8/65 APP'D R.W.BUES	<b>234-521</b>
		SCALE: 1" = 40' HOR., 1" = 4' VERT.	

Checked 1/29/65 S.A.C.

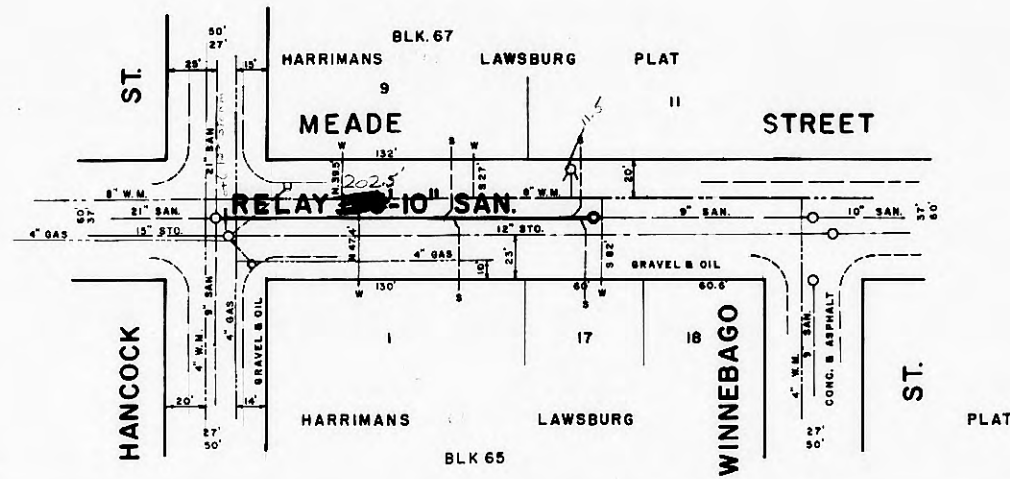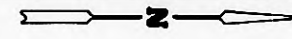


770

760

770

760

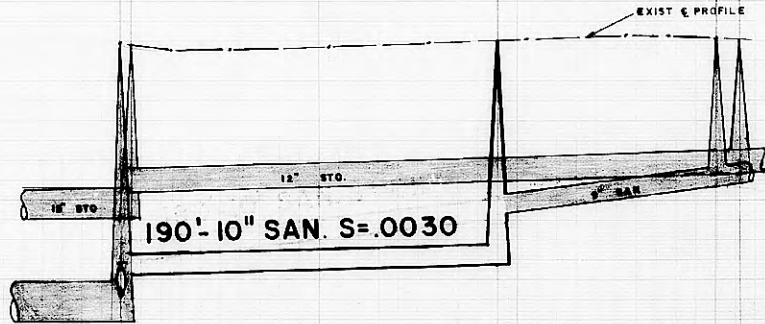

**NOTE:**

1. GRANULAR BACKFILL REQUIRED THROUGHOUT
2. TOP 6" OF TRENCH SHALL BE BACKFILLED WITH CRUSHER RUN STONE
3. VITRIFIED CLAY EXTRA STRENGTH PIPE REQUIRED THROUGHOUT INCLUDING 10X6 WYE CONNECTIONS WHERE NECESSARY, ALL PIPE SHALL BE FURNISHED BY CONTRACTOR. COST OF PIPE AND LAYING SHALL BE INCLUDED IN THE BID PRICE PER LINEAL FOOT OF PIPE LAID.
4. EXISTING WYE LOCATIONS ARE APPROXIMATE ONLY. EXACT LOCATIONS WILL BE DETERMINED UPON EXCAVATION
5. WATER SERVICES ARE LOCATED FROM WRITTEN RECORDS AS SHOWN ON PLAN. TO BE VERIFIED IN FIELD. ALSO CHECK WITH WATER DEPT
6. SEE SPECIAL PROVISIONS

*AS BUILT  
1-12-70  
D.W. at 1/4" = 1'-0" PRINT*

15" STG. S. 758.14  
12" STG. N. 760.40  
21" SAN. S. 753.82  
9" SAN. E. 755.11  
10" SAN. N. 756.80  
756.80

10" SAN. S. 756.81  
9" SAN. N. 755.28

9" SAN. S. 760.73  
12" STG. N. 8761.32

EST. QUANTITIES	REVISIONS	UTILITIES
190'-10" VITRIFIED CLAY EXTRA STRENGTH PIPE ALSO WYE PIPE 1 I.M. 11.5 VERT. FT.		SAN.
		STORM
		WATER
		GAS
		LAT.
		TEL.
		ELCT.
		LNHES

UNIT 3-69

**CITY OF APPLETON, WISCONSIN**  
ENGINEERING DIVISION  
**SANITARY SEWER**  
**RELAY**  
FROM MEADE STREET  
TO HANCOCK STREET

**234-687**

DATE: 8-31-69  
SCALE: 1" = 40' HOR. 1" = 4' VERT.  
1/4" SEC. 180

F. EMMER  
 12, 13, 14, 99, 100

LAWE

ST.

ST.

C. & N.W. RY.

HANCOCK



770

770

760

760

EXIST. 18" X 24" SAN. N.S.S. 789.47  
 12" STG. S. 789.20

EXIST. 18" X 24" SAN. N.S.S. 790.24

18" STG. N.S.S. 792.74

12" STG. N.S.S. 799.00  
 EX. 12" STG. 798.20  
 EX. 12" STG. S. 798.2  
 EX. 12" SAN. E. 798.74  
 EX. 12" X 18" SAN. W. 797.89  
 EX. 12" SAN. S. 799.20  
 EX. 18" X 24" SAN. N. 798.74


297'  
 182'-12" STO. CLASS II S=.003

70'-12" ST. S=.003  
 CLASS II


24'-12" STO. S=.003  
 CLASS II

EST. QUANTITIES	CITY OF APPLETON, WISCONSIN ENGINEERING DIVISION STORM SEWER LAWE IN STREET HANCOCK ST. TO R.R. TRACKS	
400'-18" CONC. PIPE S.M.A. - 12 YER. FT. 1-TYPE "D" INLET 1-TYPE "C" INLET 90'-18" INLET LEAD	DWG. NO. 236-20 DATE 6/25 SCALE 1" = 20' HOR.; 1" = 4' VERT.	DWG. NO. 236-20 APP'D. R.S. 6/25

CHECKED 2/14/25 J.A.C.

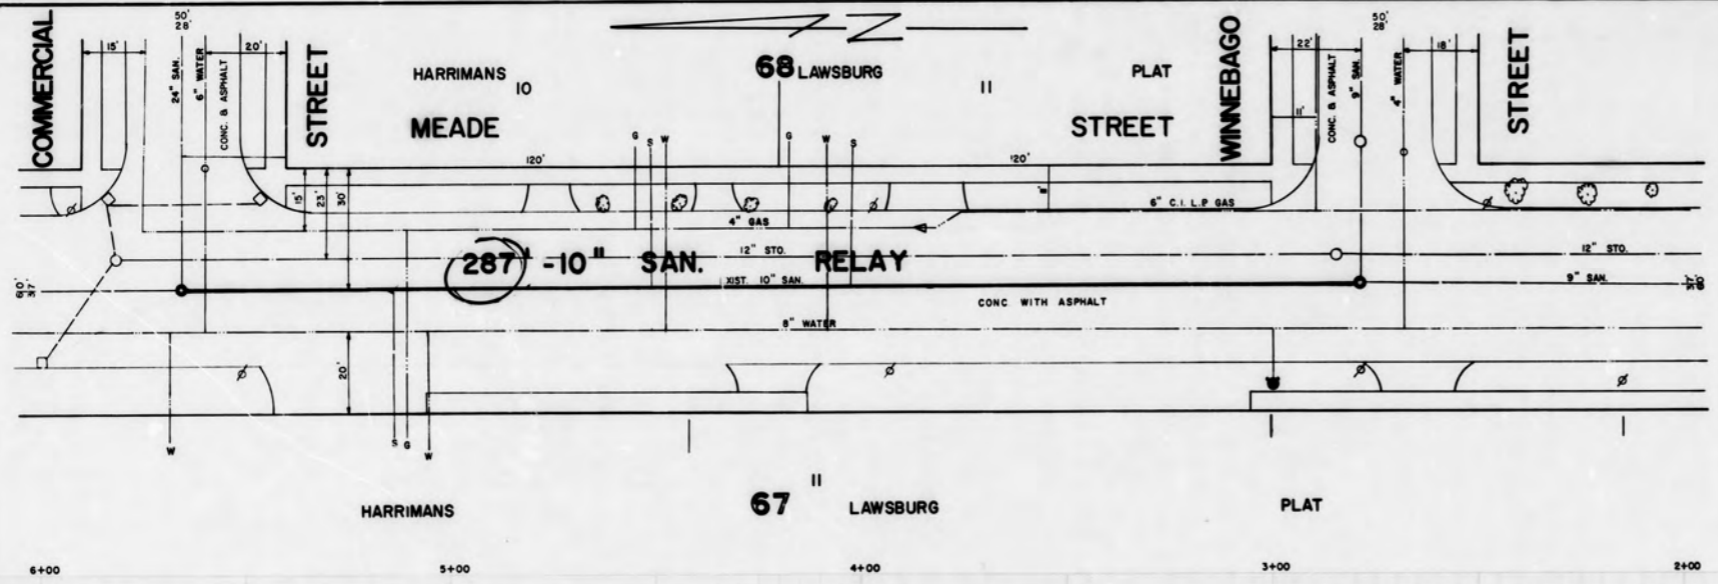

As Built  
1-2-73  
g.H.

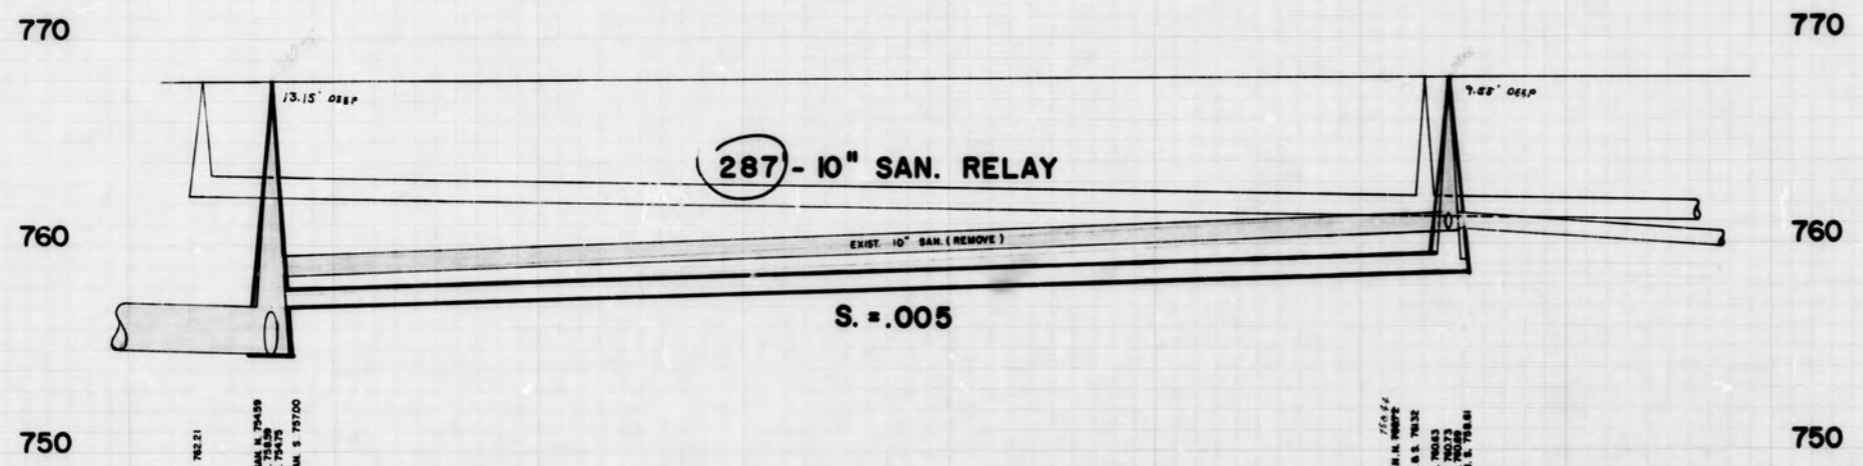


EXIST. 12" STC S. 762.21  
EXIST. 24" STC SAN. N. 764.59  
EXIST. 10" SAN. S. 761.89  
EXIST. 24" SAN. E. 754.75  
PROP. 10" SAN. S. 757.00

EXIST. 10" SAN. N. 762.24  
EXIST. 12" STC. N. S. 761.32  
EXIST. 10" SAN. N. 760.83  
EXIST. 10" SAN. S. 760.73  
EXIST. 10" SAN. E. 754.81  
PROP. 10" SAN. N. 758.81

UNIT  
K-22

EST. QUANTITIES	REVISIONS	UTILITIES	CITY OF APPLETON, WISCONSIN ENGINEERING DIVISION	
287' - 10" SAN.		SAN.	<b>SANITARY (RELAY) SEWER</b> <b>MEADE STREET</b> FROM WINNEBAGO STREET TO COMMERCIAL STREET	
RECONNECT 3 LATERALS		STORM		
15' LATERAL RELAY		WATER		
2 M.H. 23 VERT FEET		GAS		
		L.A.I.		
		TEL.	DWN. JMK    CRD.    DWG. NO. <b>SA-22</b> DATE: 1-4-78    APPD.    SCALE: 1" = 20'    HOR. 1" = 4'    VERT. 1/4" = 10' SEC. 151	

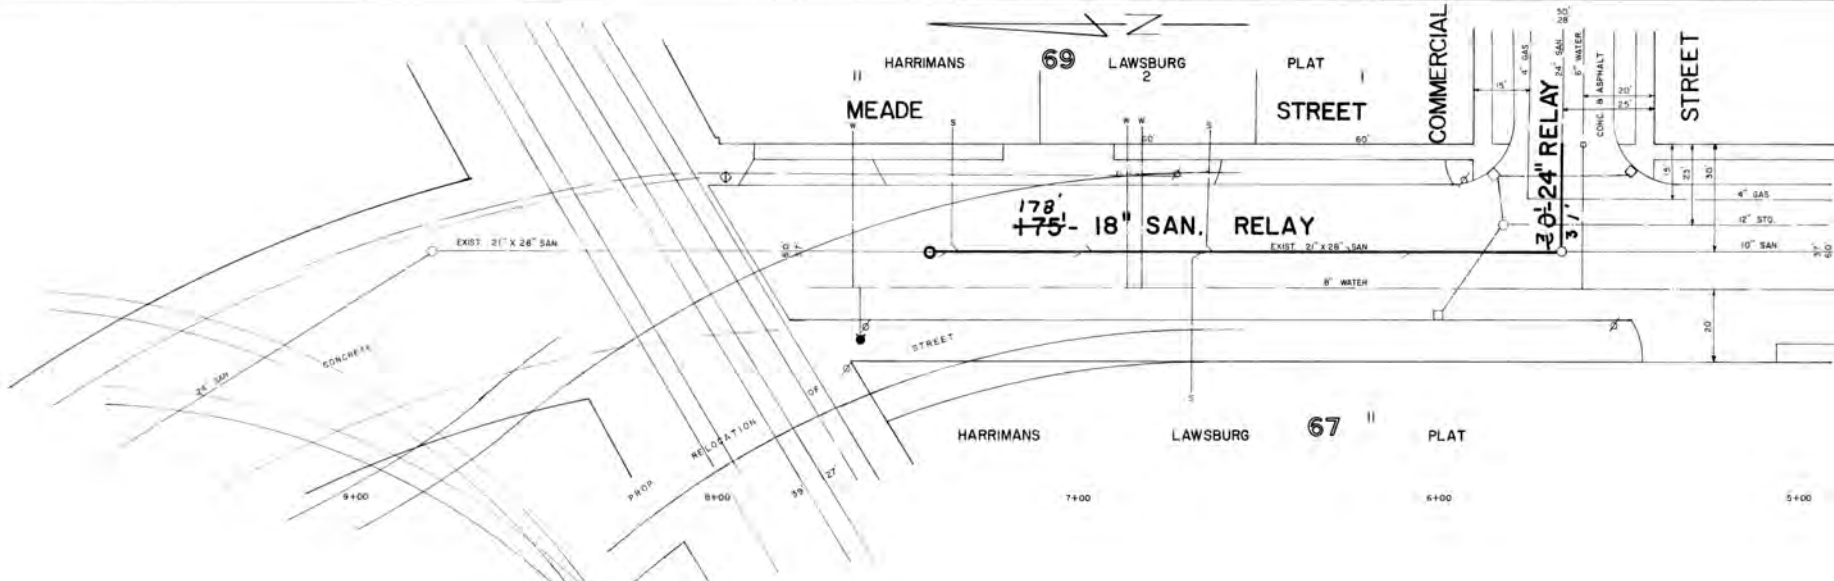

AS BUILT  
1-2-23  
S.H.

770


770

760

760

750

750

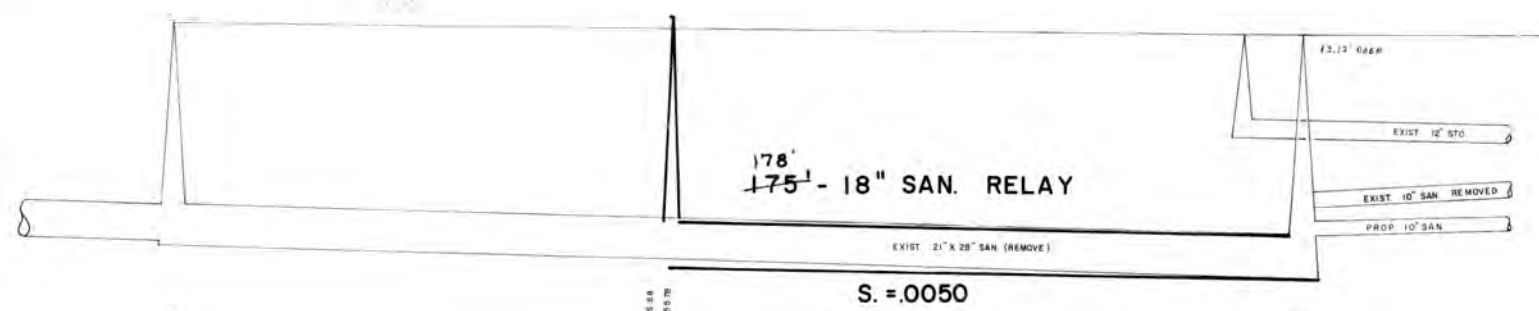

EXIST 24" SAN N/W 75648  
EXIST 31" X 28" SAN S 75640

PROP 18" SAN N/W 75658  
PROP 10" SAN S 75678

PROP 12" SAN N 75490  
EXIST 12" STG S 75472



EXIST 24" SAN E 75472  
EXIST 10" SAN S 75472  
EXIST 10" SAN S 75472  
PROP 10" SAN S 75700

175'-18" SAN 30'-24" SAN RECONNECT & LATERALS 15" LATERALS RELAY 1" H 14 VERT FEET	CITY OF APPLETON, WISCONSIN ENGINEERING DIVISION <b>SANITARY (RELAY) SEWER</b> <b>MEADE STREET</b> FROM COMMERCIAL STREET TO RAILROAD TRACKS	<b>SA-23</b> 1-4-72 20' - 4' 1/4 SEC. 151
--	--	--

As Built  
1-12-77  
Field  
UNIT 6 70

NOTE: 1. ALL LATS. ARE Y CONNECTIONS  
2. EXISTING STORM LINE 2 1/2" THICK BLACK IS APP. 1/8" FALL OF DEGREE  
3. PIPE IN 4 DKT IS 10" DIA. TO BE RESET TO GIVE CLEARANCE TO SANITARY

MH @ HANCOCK & RANKIN 0+05  
BM - HYD - HANCOCK & MEADE 769.66  
- HYD - HANCOCK & LAWE 769.69

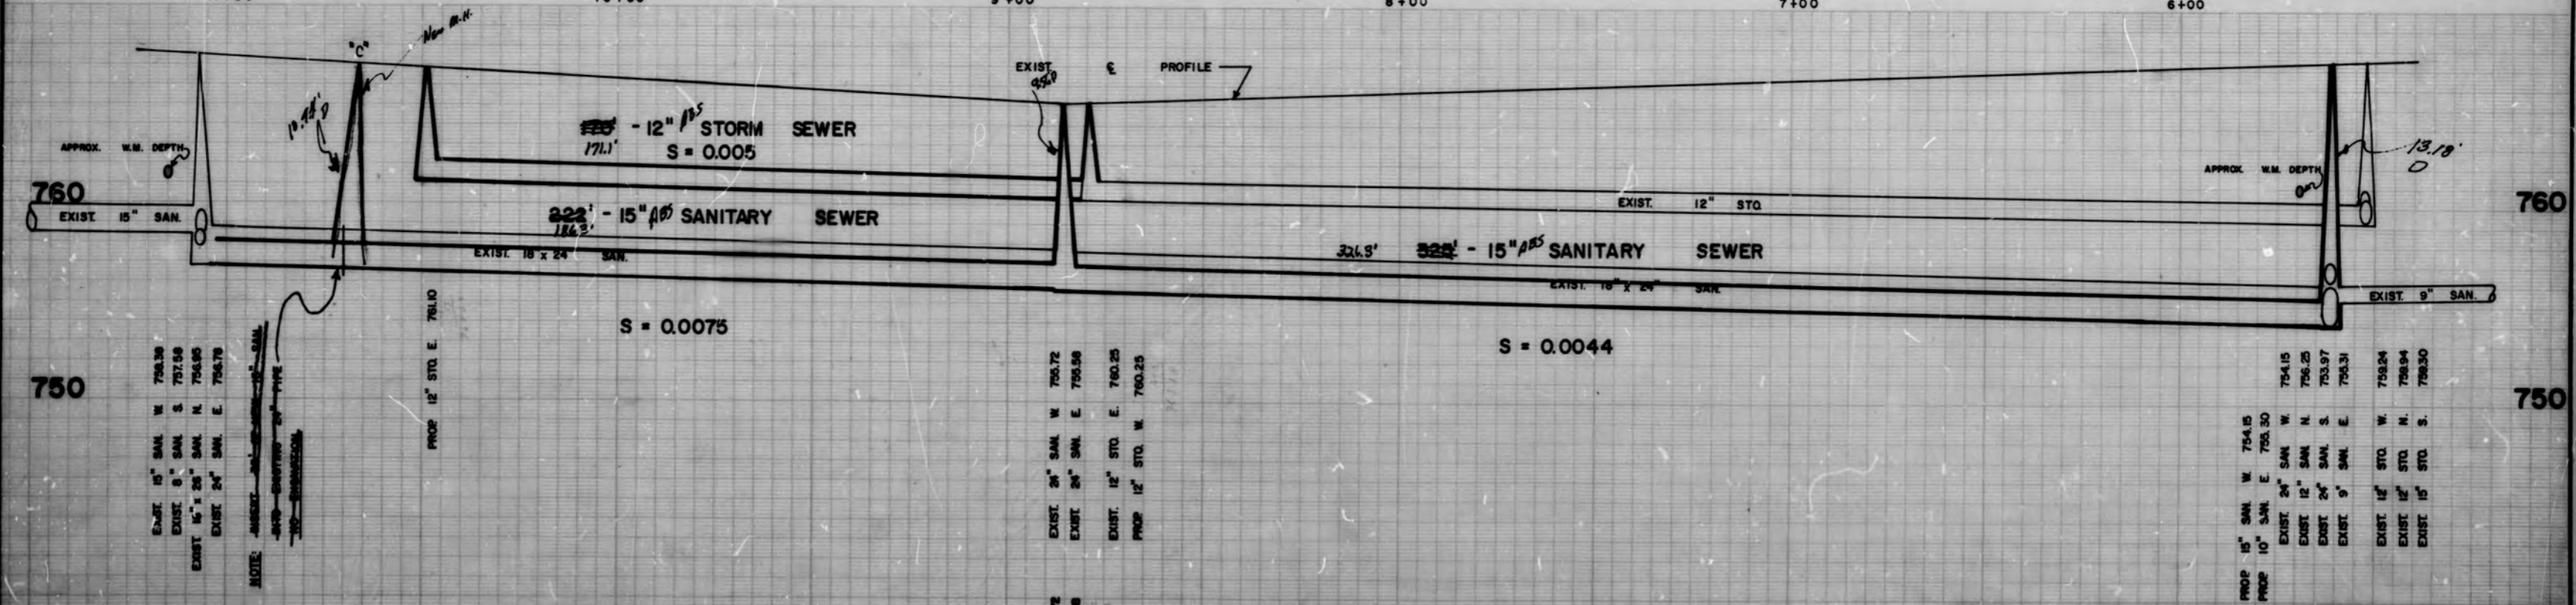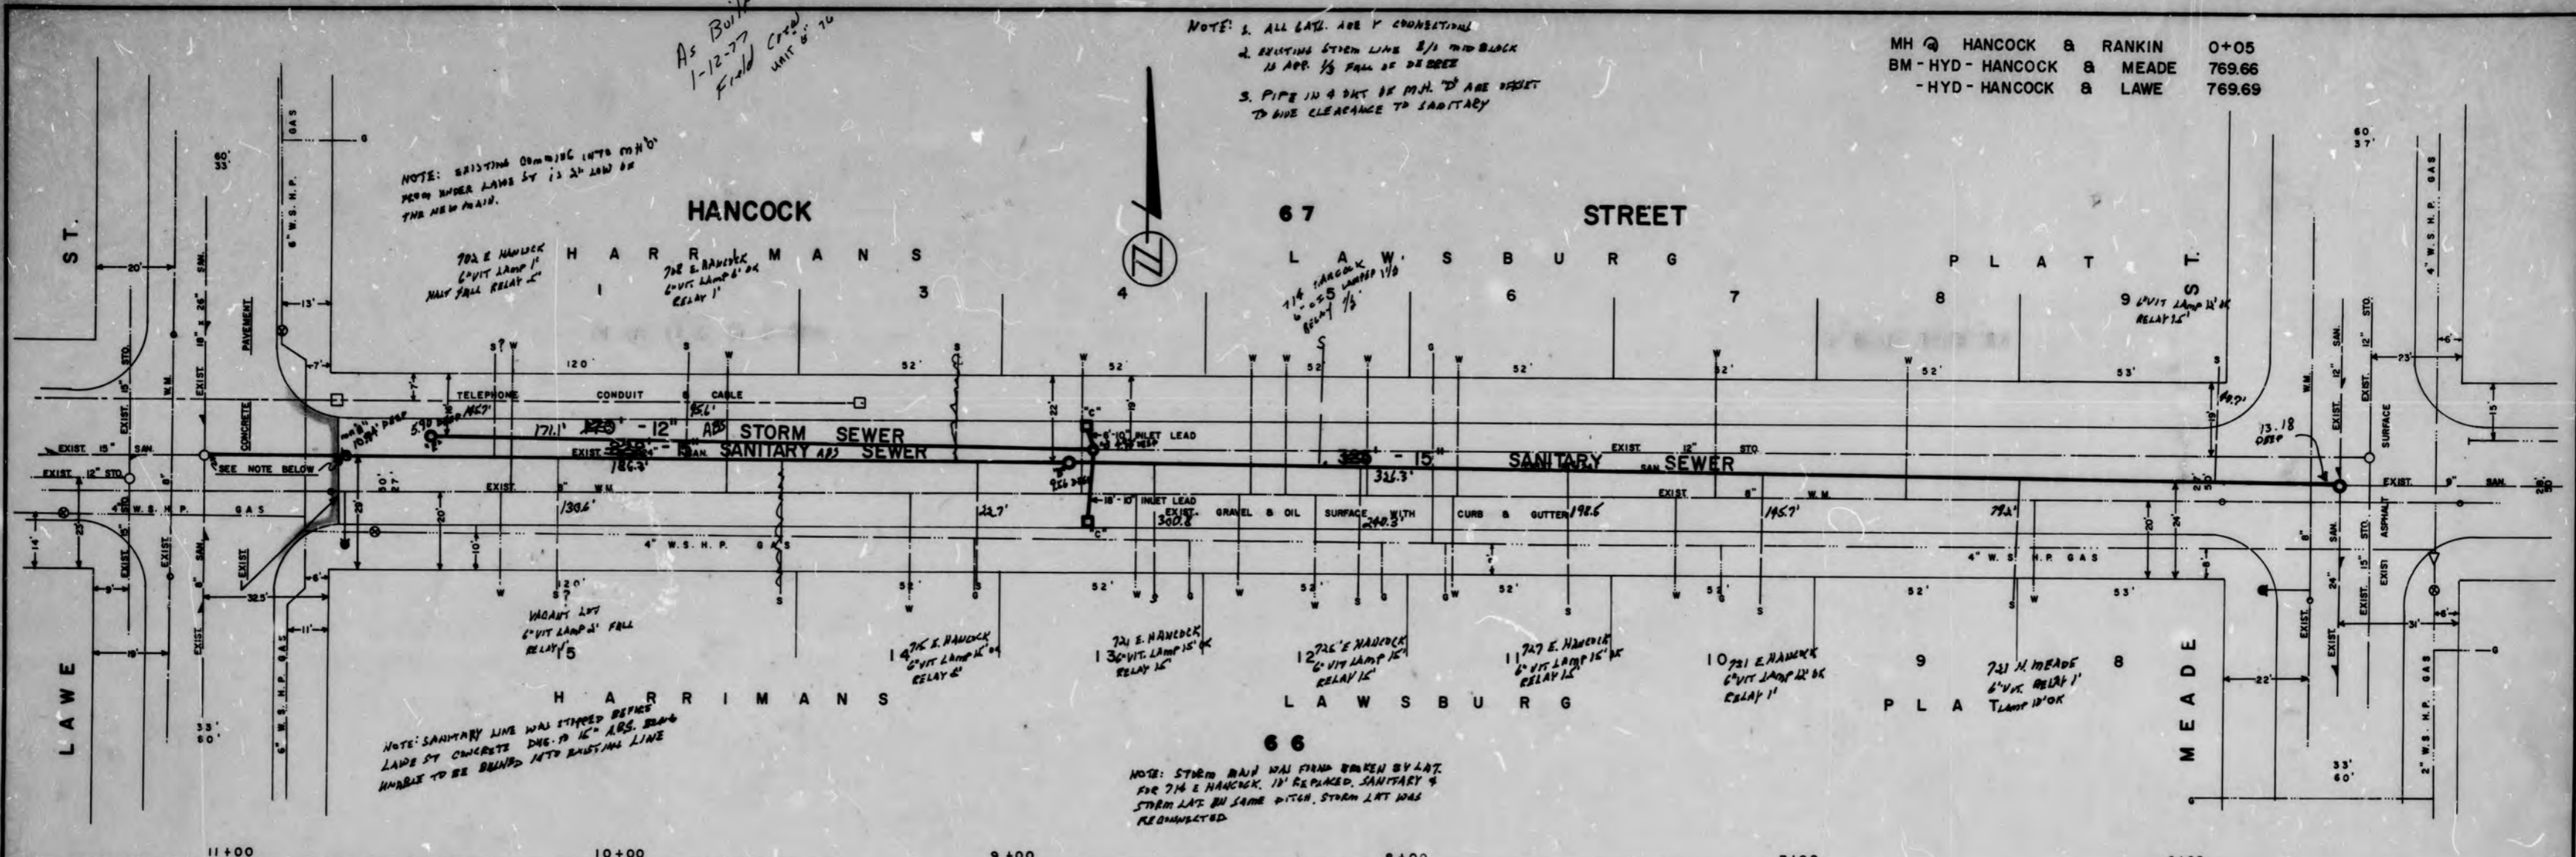


ESTIMATE QUANTITIES		REVISIONS
547' - 15" SAN. RECONNECT 12 LATERALS		
RELAY 10' LATERAL		
23 VERT. FT. STD. M.H.		
INSTALL 2 CASTINGS		
170' - 12" STG.		
24' - 10" INLET LEAD		
2" - C" INLETS		
11 VERT. FT. STD. M.H.		
INSTALL 4 CASTINGS		

CITY OF APPLETON, WISCONSIN ENGINEERING DIVISION <b>SANITARY &amp; STORM SEWER</b> <b>HANCOCK STREET</b> MEADE ST TO LAWE ST.	
DWN: J.H. GLIM CRD:	DWS: SA-248
DATE: 3-18-78	APPD:
SCALE: 1" = 20' HOR. 1" = 4' VERT.	1/4 SEC. 181




# HANCOCK ST.

STA 14+00.00 E/L LAWE STREET  
 BENCHMARKS:  
 HYDRANT S/E COR. LAWE ST. .... 788.69  
 HYDRANT S/S HANCOCK FRONT HOUSE #725 ..... 788.03

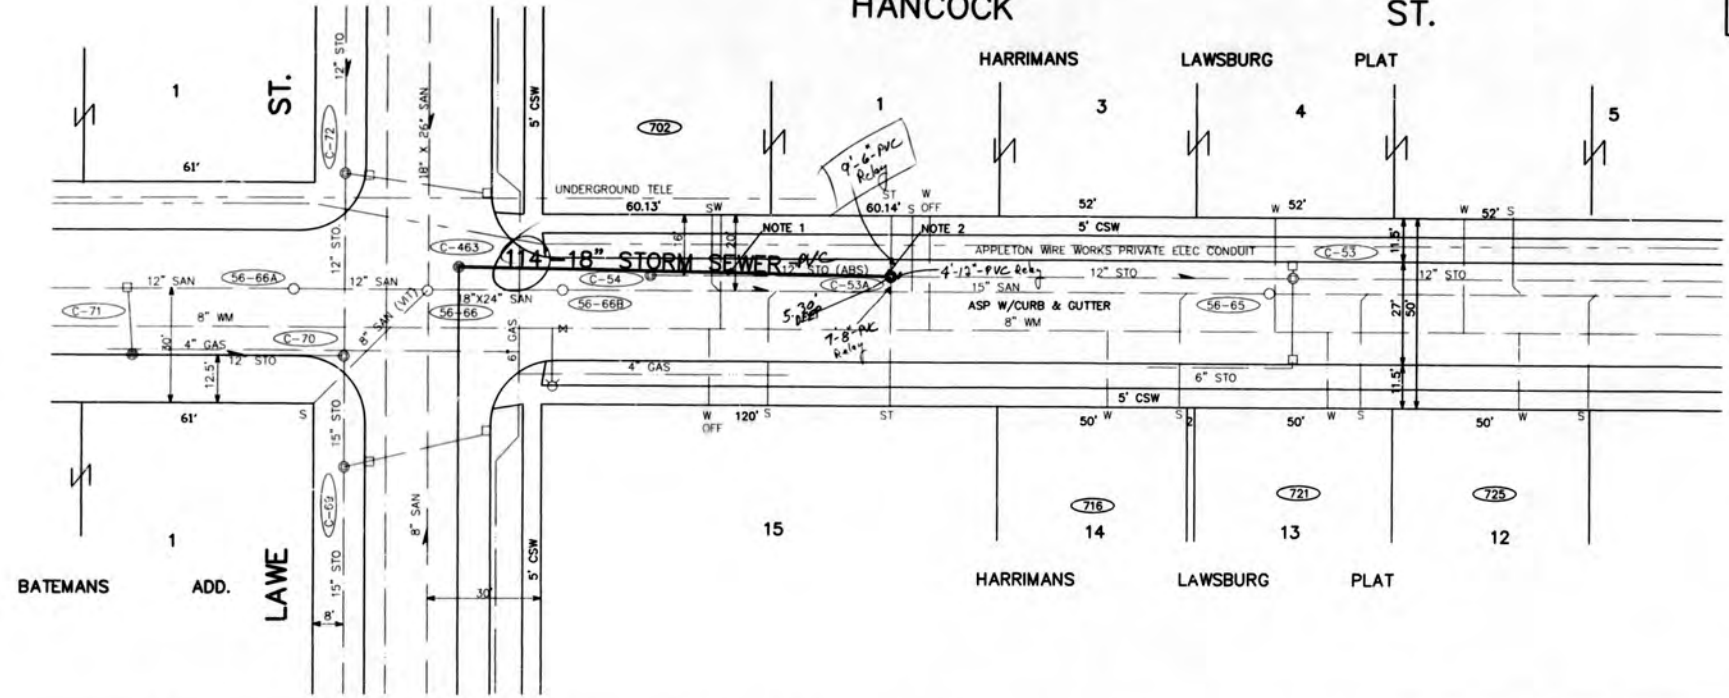

- NOTES:**
- 1.) COST OF REMOVAL OF EXISTING 12" STORM SEWER AND MANHOLE SHALL BE INCLUDED IN COST OF NEW PIPE.
  - 2.) VERIFY INVERT ELEVATION AT MANHOLE C-53A PRIOR TO BEGINNING WORK. ADJUST GRADES ACCORDINGLY TO ENSURE THAT NEW 18" STORM IS AT OR BELOW INVERT OF 12" STORM TO THE EAST.


BEFORE CONSTRUCTION THE CONTRACTOR SHALL HAVE THE UTILITIES AND LATERALS LOCATED BY THE UTILITY COMPANIES.

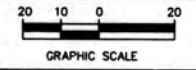

*As Built  
 TT-02 Van Straten  
 11-14-02 gH  
 / 500 12-5-02*

**ESTIMATE OF QUANTITIES**

- 114 LF - F&I 18" STORM SEWER
- 7 VF - F&I STORM MANHOLE
- 1 EA - F&I STORM MANHOLE CASTING

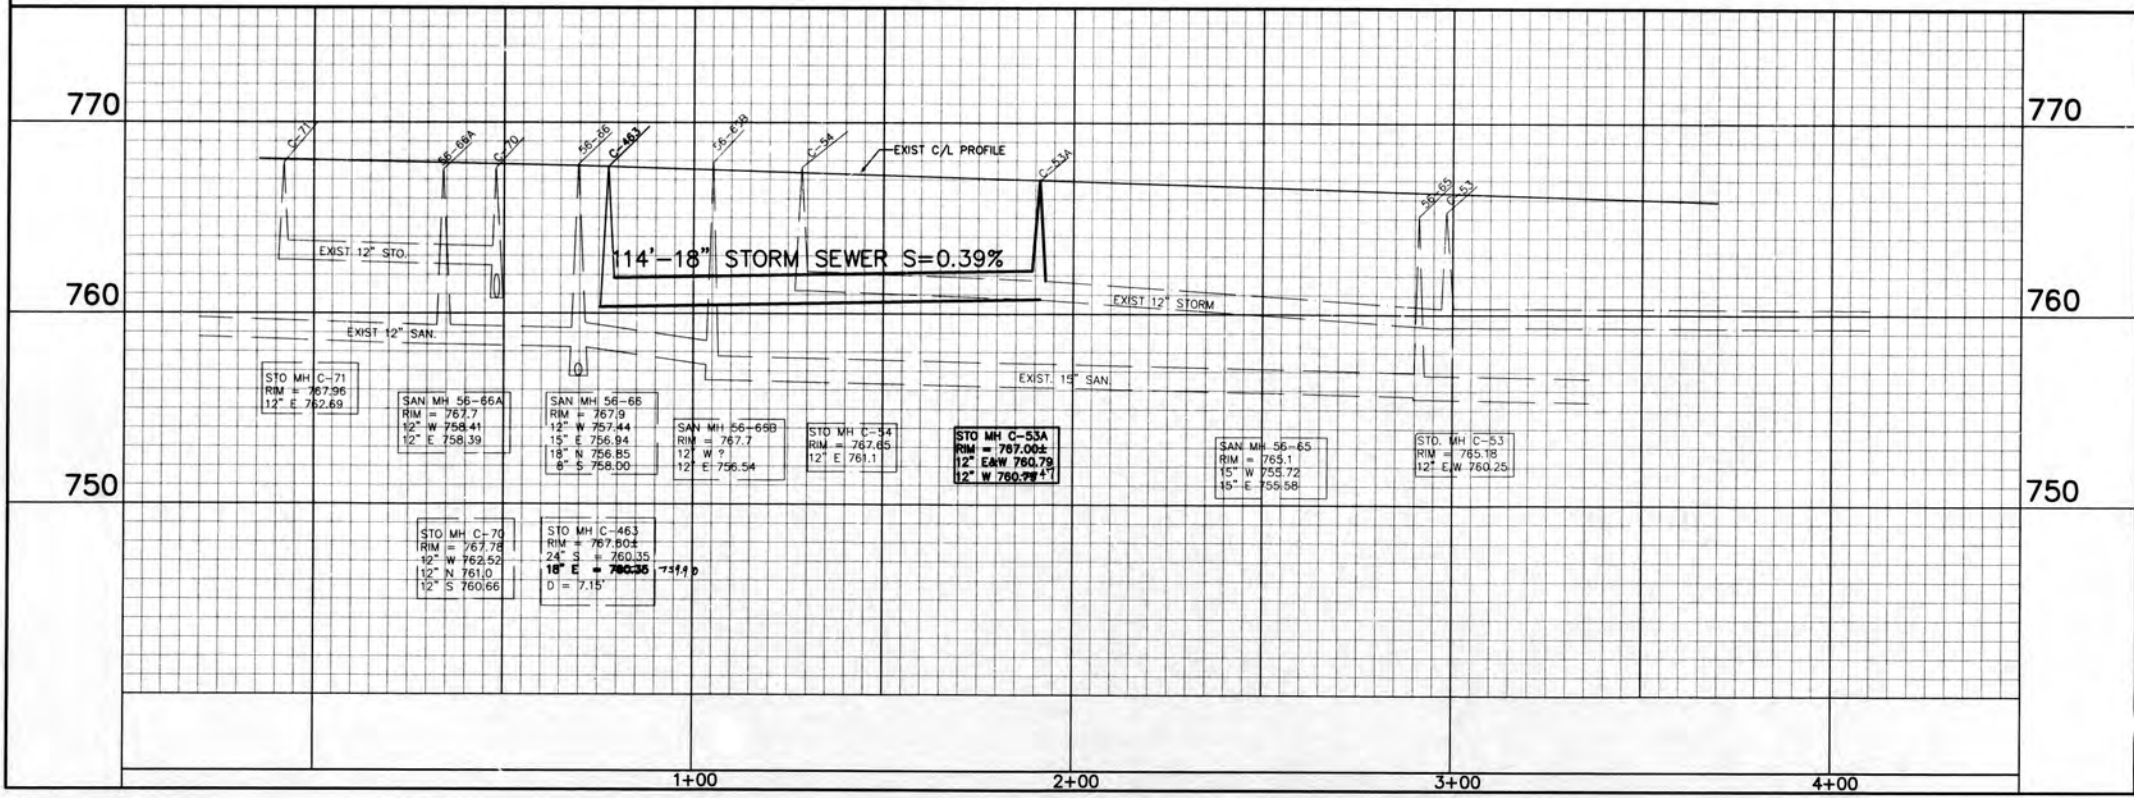


CITY OF APPLETON, WIS.  
 ENGINEERING DIVISION

**STORM SEWER  
 IN  
 HANCOCK STREET**  
 LAWE ST. TO 500' EAST OF LAWE

DWN: AAE CKD:  
 DATE: 12/11/01 APP'D:

S. NO. 1/4 SEC. R 50 PAGE NO.  
**ST-932 16**

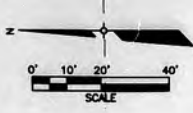



NOTE: EXISTING UTILITIES SHOWN IN PLAN ARE INDICATED IN ACCORDANCE WITH AVAILABLE RECORDS. THE CONTRACTOR SHALL BE RESPONSIBLE FOR OBTAINING EXACT LOCATIONS AND ELEVATIONS OF ALL UTILITIES, INCLUDING SEWER AND WATER FROM THE OWNERS OF THE RESPECTIVE UTILITIES. ALL UTILITY OWNERS SHALL BE NOTIFIED BY THE CONTRACTOR 72 HOURS PRIOR TO EXCAVATION.

TEMPORARY STORM AND SANITARY FLUMING, INLET DISCONNECTS, ABANDONMENT OR REMOVAL OF SEWERS, REMOVAL OF INLETS, AND RESTORATION OF SEWERS TO EXISTING CONDITIONS ARE INCIDENTAL TO THE COST OF INSTALLING SHAFT.

CONTRACTOR SHALL, WITHIN 5 DAYS OF COMPLETION OF WORK WITHIN SHAFT, BACKFILL SHAFT WITH SPECIFIED BACKFILL MATERIAL AND BE RESPONSIBLE FOR SURFACE RESTORATION AS FOLLOWS:

PACIFIC STREET: PAVEMENTS, SIDEWALKS, APRONS, ETC SHALL BE CAPPED WITH 3 INCHES OF HOT MIXED ASPHALT MATERIAL ON TOP OF 6 INCHES OF 3/4 INCH ROAD STONE OR TO THE EXTENSION OF THE EXISTING PAVEMENT SUBGRADE, WHICHEVER IS GREATER. IF HOT MIX IS NOT AVAILABLE IN THE WINTER MONTHS, COLD MIX MAY BE USED.

GRASSED AREAS: COMPLY WITH SPECIAL PROVISIONS.

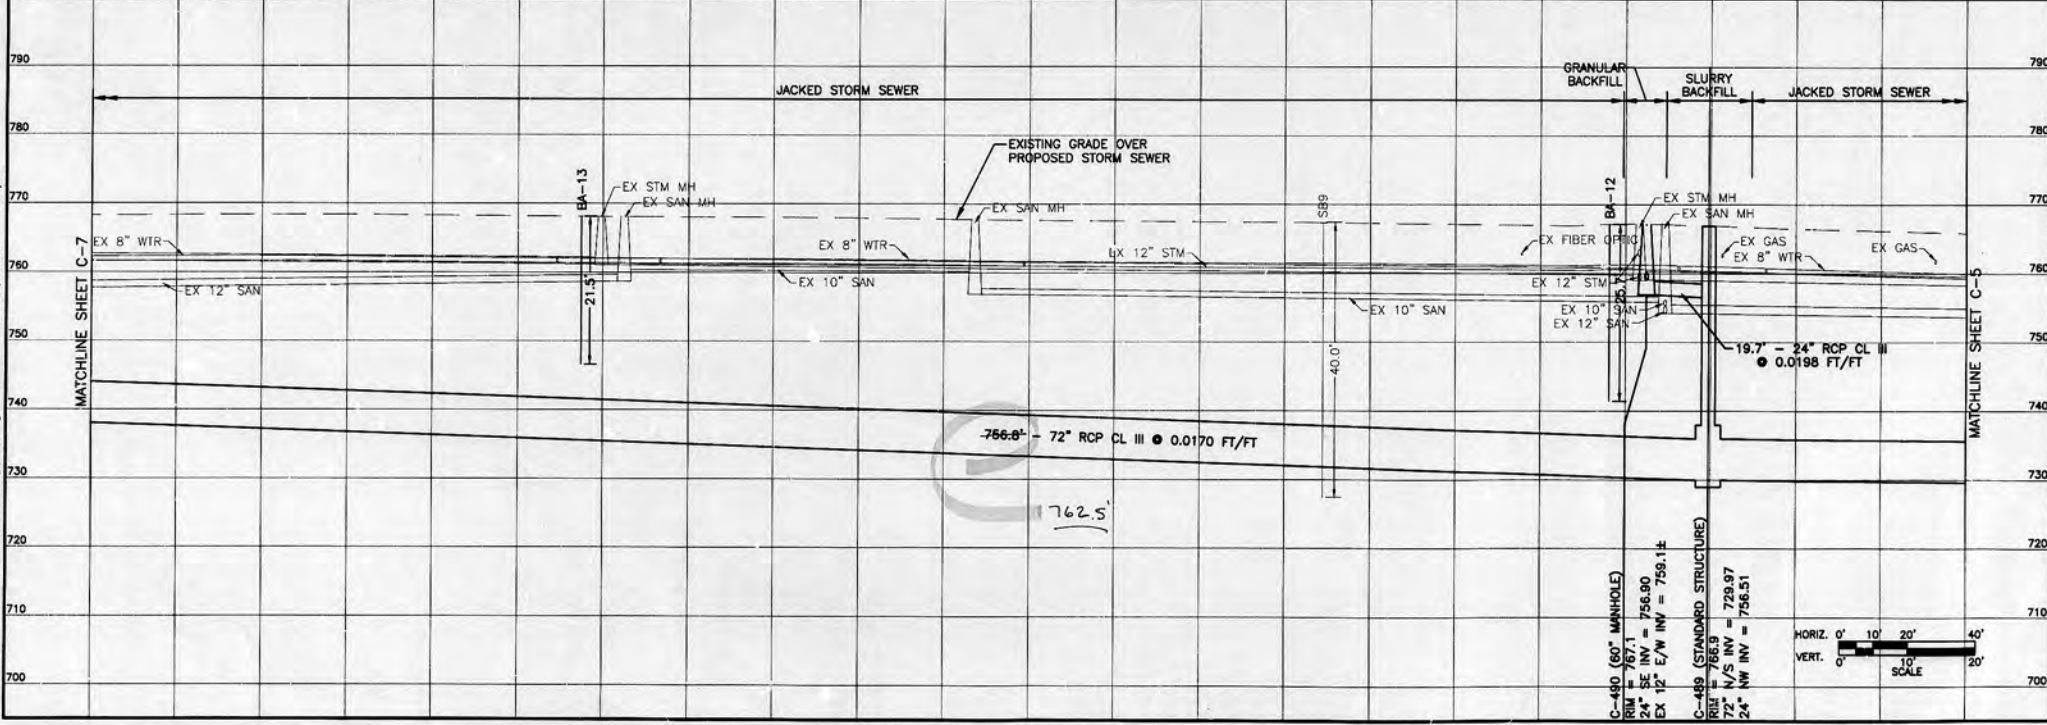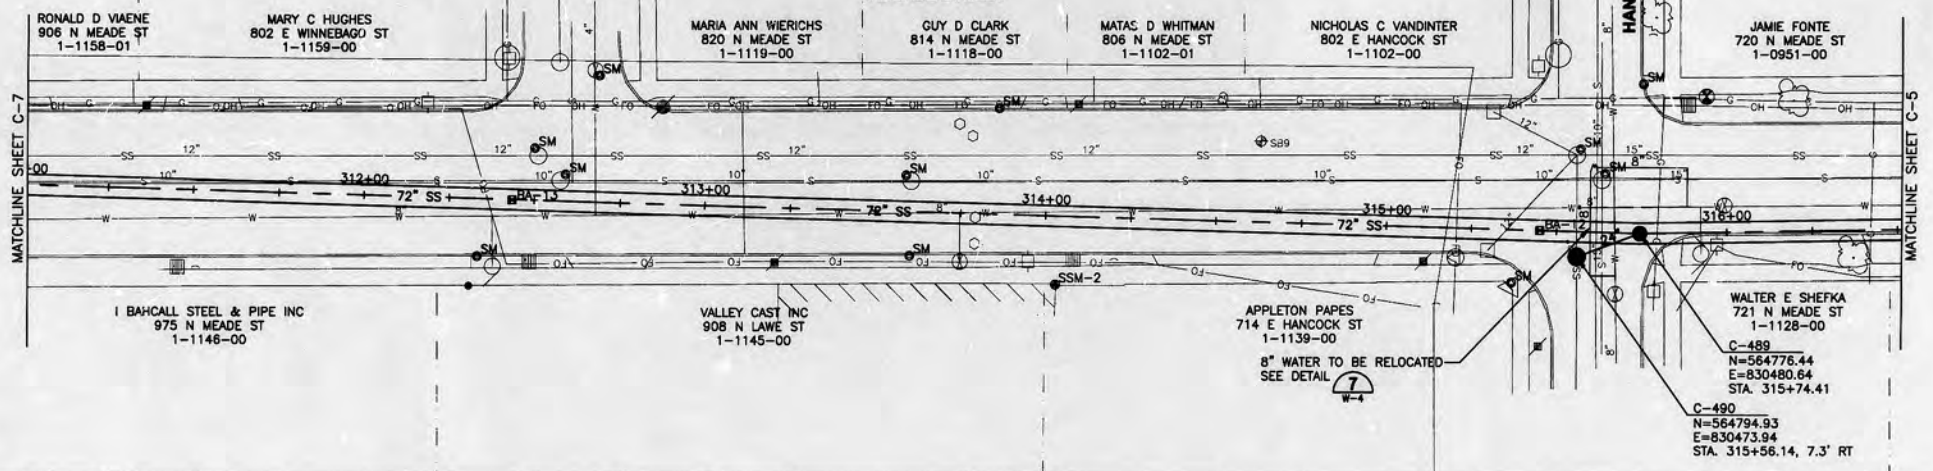

DATE	NOVEMBER 2005
PROJECT NO	81436
FILENAME	pp06.dwg
SHEET NO	
DRAWING NO	C-6

100% DESIGN	11/2005
DESIGN	11/2005
CHECK	11/2005
APP-1/02	11/2005


  

EarthTech  
A Tyco International Ltd. Company

CITY OF APPLETON, WISCONSIN  
MEADE AND PACIFIC STREETS  
APPLETON, WISCONSIN

MEADE STREET  
STORM SEWER PLAN AND PROFILE

File: L:\work\81436\Cadd\Plan Set\pp06.dwg Time: Nov 03, 2005 - 3:33pm

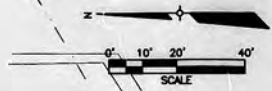

APPLETON (PAPERS) INC  
825 E WISCONSIN AVE  
RON KRUMRAJ  
(920) 991-8844  
1-1179-00


JAMES J SMITS  
920 N MEADE ST  
1-1157-00

DENNIS G CAPTAIN  
912 N MEADE ST  
1-1158-00

C-492  
N=565687.92  
E=830434.20  
STA. 306+48.47

C-491  
N=565540.86  
E=830504.82  
STA. 308+09.60

I BAHCALL STEEL & PIPE INC  
975 N MEADE ST  
1-1146-00

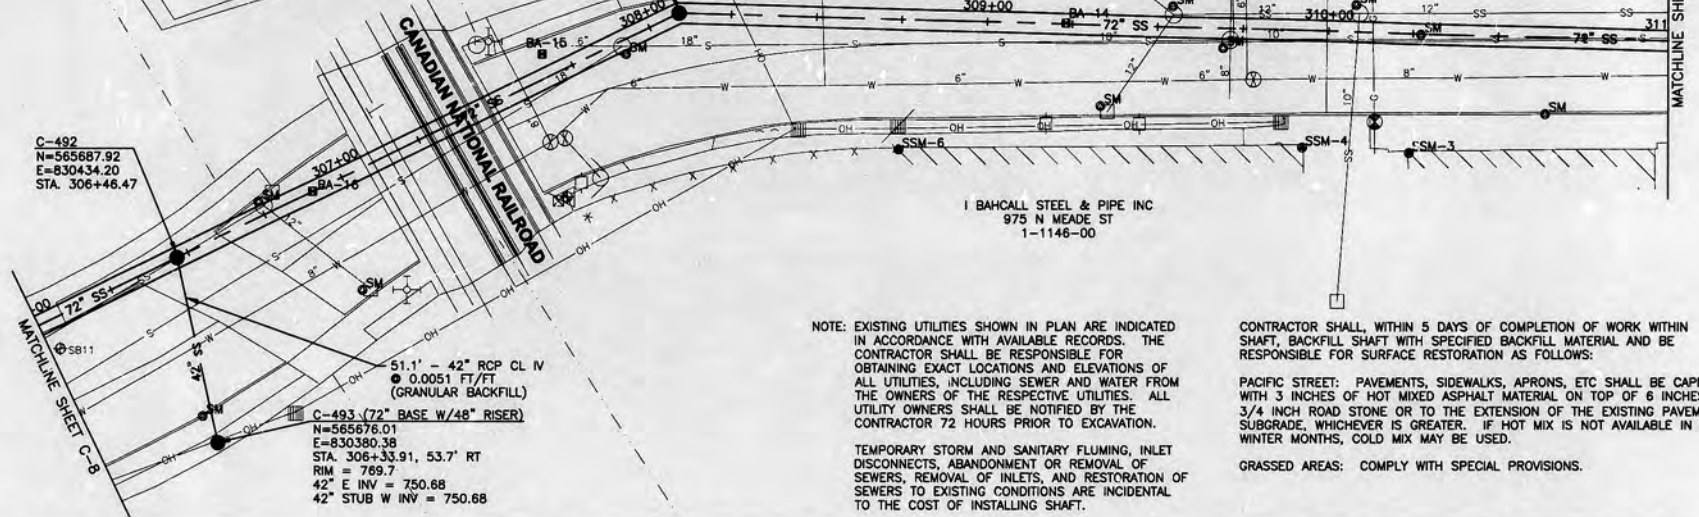

NOTE: EXISTING UTILITIES SHOWN IN PLAN ARE INDICATED IN ACCORDANCE WITH AVAILABLE RECORDS. THE CONTRACTOR SHALL BE RESPONSIBLE FOR OBTAINING EXACT LOCATIONS AND ELEVATIONS OF ALL UTILITIES, INCLUDING SEWER AND WATER FROM THE OWNERS OF THE RESPECTIVE UTILITIES. ALL UTILITY OWNERS SHALL BE NOTIFIED BY THE CONTRACTOR 72 HOURS PRIOR TO EXCAVATION.


CONTRACTOR SHALL, WITHIN 5 DAYS OF COMPLETION OF WORK WITHIN BACKFILL, BACKFILL SHAFT WITH SPECIFIED BACKFILL MATERIAL AND BE RESPONSIBLE FOR SURFACE RESTORATION AS FOLLOWS:

PACIFIC STREET: PAVEMENTS, SIDEWALKS, APRONS, ETC SHALL BE CAPPED WITH 3 INCHES OF HOT MIXED ASPHALT MATERIAL ON TOP OF 6 INCHES OF 3/4 INCH ROAD STONE OR TO THE EXTENSION OF THE EXISTING PAVEMENT SUBGRADE, WHICHEVER IS GREATER. IF HOT MIX IS NOT AVAILABLE IN THE WINTER MONTHS, COLD MIX MAY BE USED.

GRASSED AREAS: COMPLY WITH SPECIAL PROVISIONS.

TEMPORARY STORM AND SANITARY FLUMING, INLET DISCONNECTS, ABANDONMENT OR REMOVAL OF SEWERS, REMOVAL OF INLETS, AND RESTORATION OF SEWERS TO EXISTING CONDITIONS ARE INCIDENTAL TO THE COST OF INSTALLING SHAFT.

File: L:\work\B1436\Cadd\Plan\_Ser\pp07.dwg Time: Nov 03, 2005 - 3:35pm

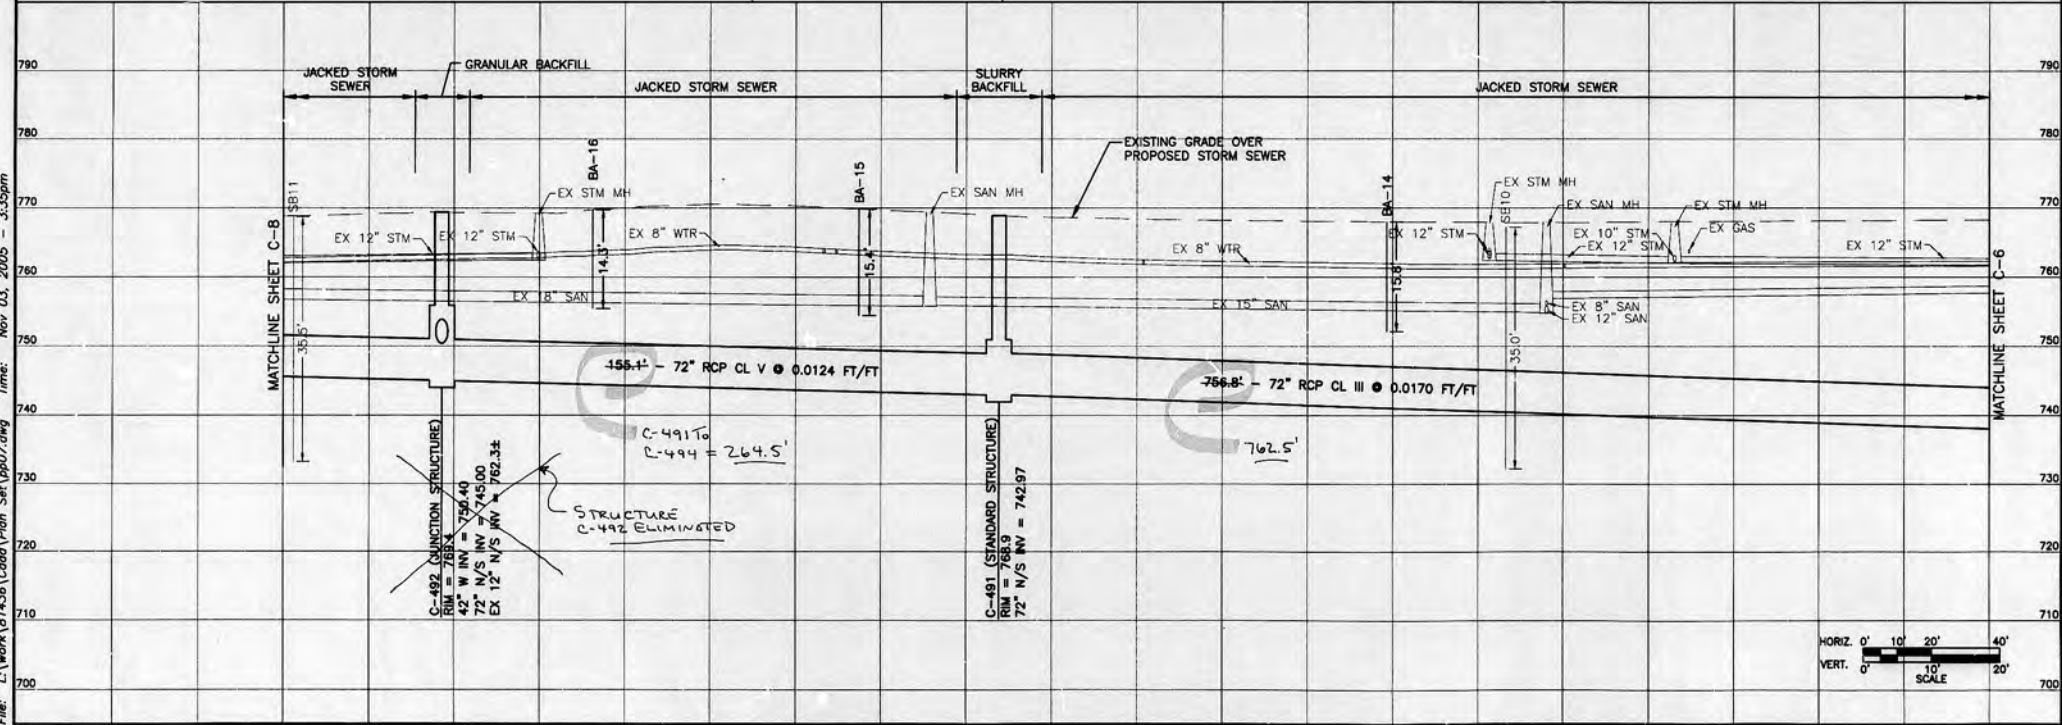


~~C-492 (CONNECTION STRUCTURE)  
RIM = 768.3  
42" W INV = 750.40  
72" N/S INV = 745.00  
EX 12" N/S INV = 762.34~~

STRUCTURE  
C-492 ELIMINATED

C-491 to  
C-494 = 264.5'

C-491 (STANDARD STRUCTURE)  
RIM = 768.9  
72" N/S INV = 742.97

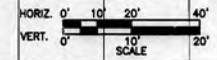

NO	REVISIONS	DRN/CHK	DATE
1	1000 N MEADE ST 411-225-5100		
2	DRN/CHK		11/2005
3	DES/CHK		11/2005
4	CHK/CHK		11/2005
5	APP/APP		11/2005




**EarthTech**  
A Tyco International Ltd. Company

CITY OF APPLETON, WISCONSIN  
MEADE AND PACIFIC STREETS  
APPLETON, WISCONSIN  
**MEADE STREET  
STORM SEWER PLAN AND PROFILE**

DATE: NOVEMBER 2005  
PROJECT NO: 81436  
FILENAME: pp07.dwg  
SHEET NO:  
DRAWING NO:  
**C-7**

ORIGINAL ST-1132

BEFORE CONSTRUCTION THE CONTRACTOR SHALL HAVE THE UTILITIES AND LATERALS LOCATED BY THE UTILITY COMPANIES.

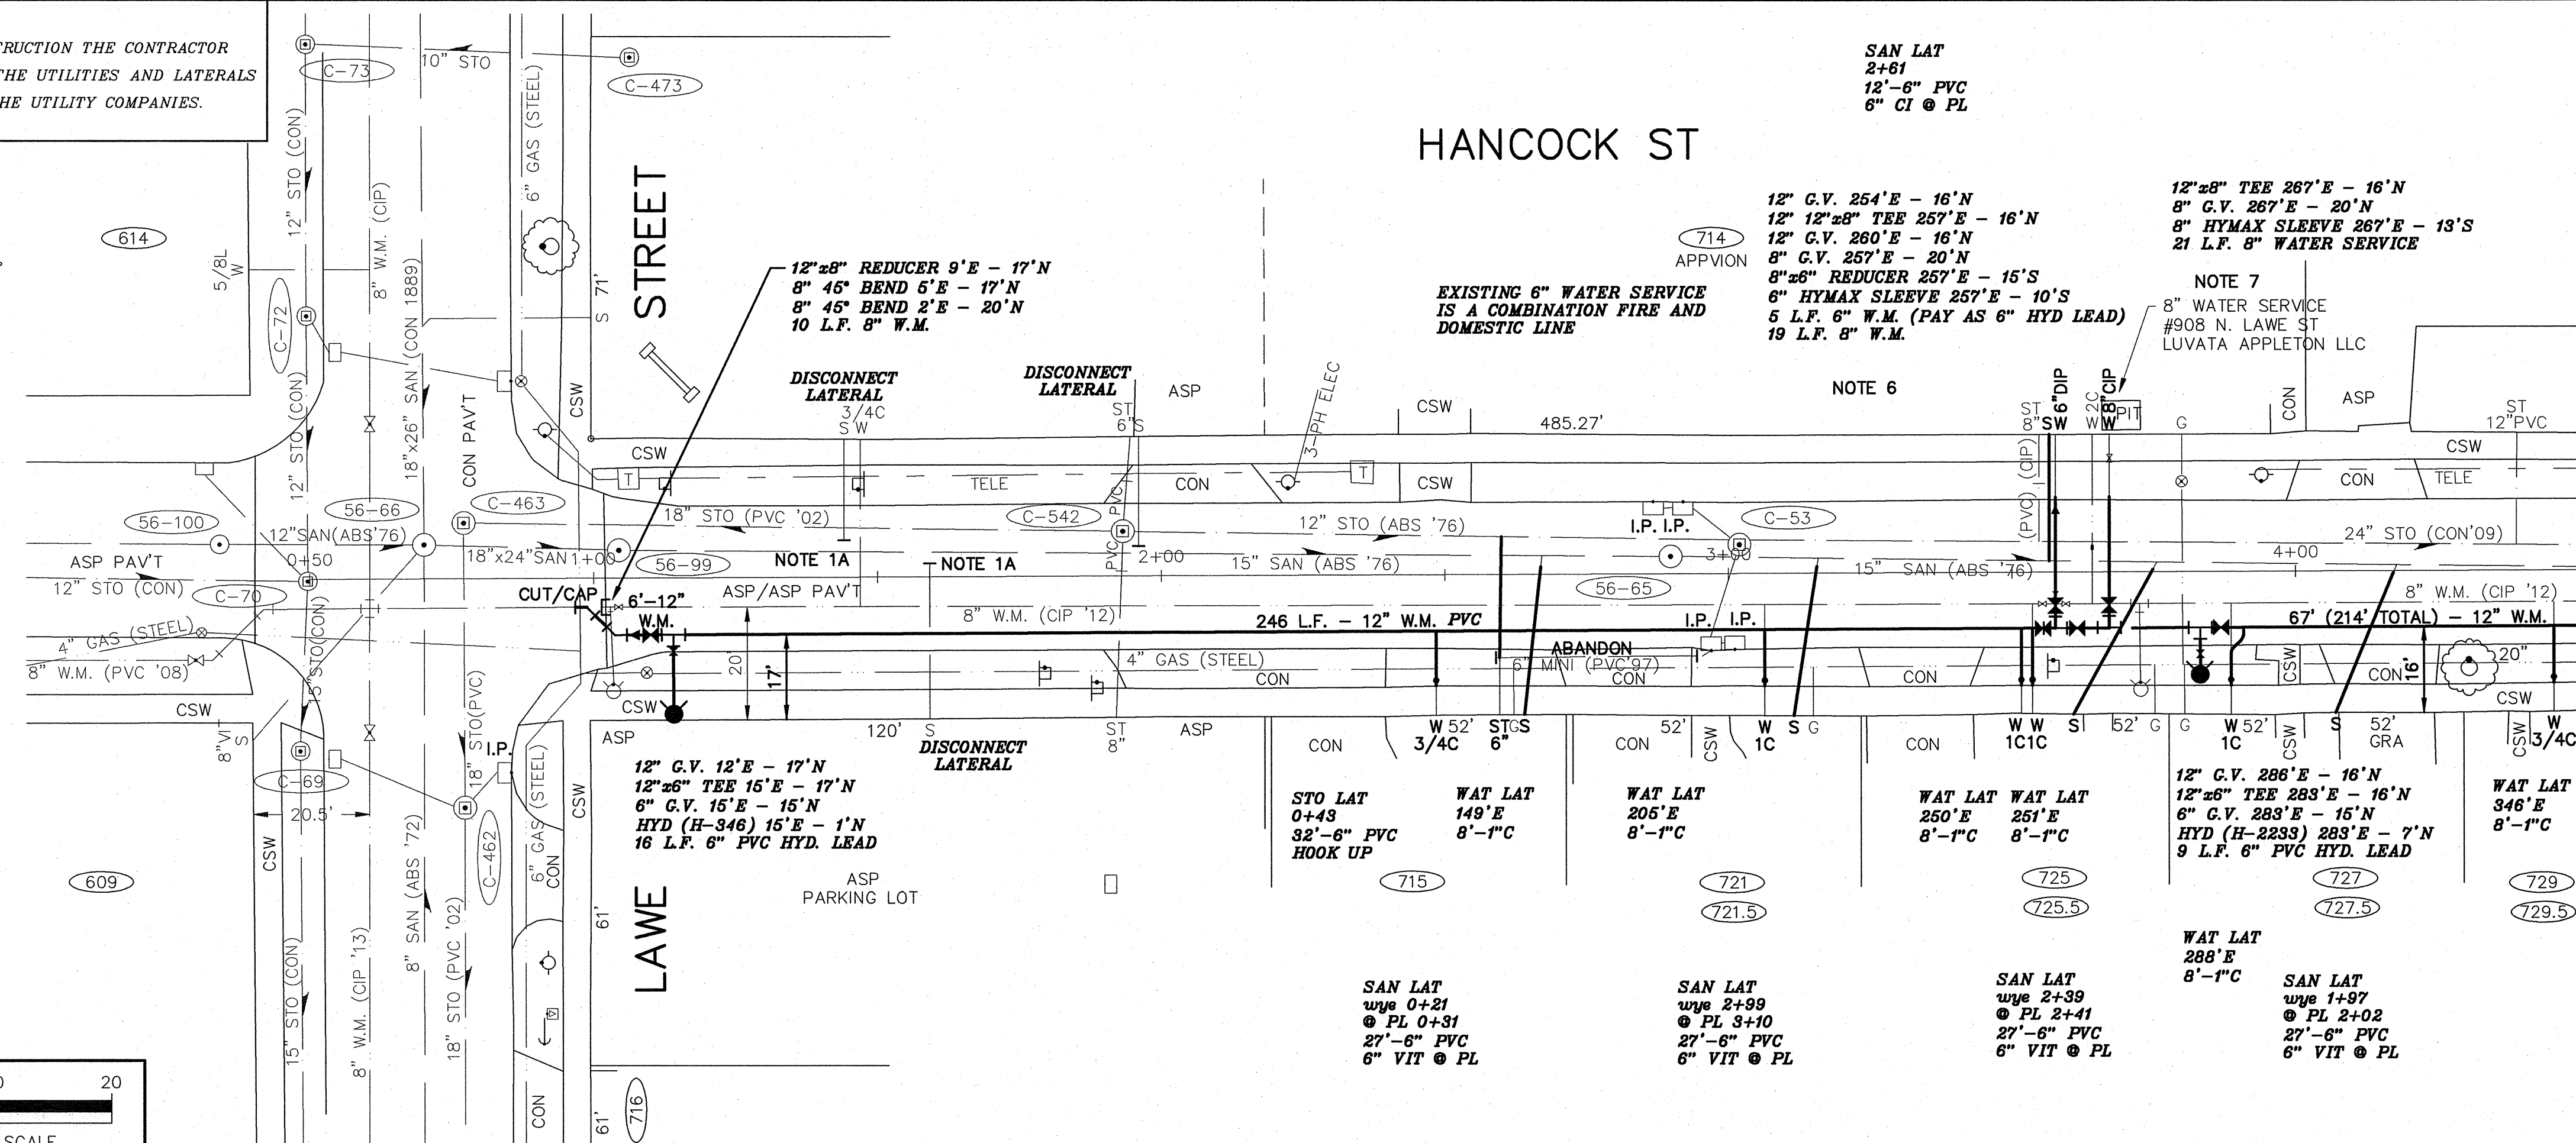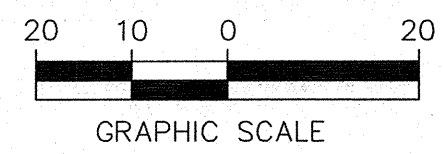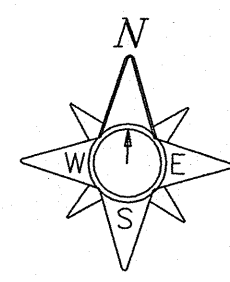

STA 1+00.00 E/L LAWE STREET

**WATER MAIN NOTES:**

- EXISTING SERVICES SHALL BE CONNECTED TO NEW MAIN WITH NEW CORPORATION STOP & PIPE COUPLING.
- PARTIAL COPPER SERVICE REPLACEMENT SHALL BE DONE WITH MATERIAL SAME AS EXISTING. COMPLETE SERVICE REPLACEMENT FROM THE NEW MAIN TO AND INCLUDING NEW CURB STOP AND CURB BOX MAY USE POLY MATERIAL OF EQUIVALENT (NOMINAL) DIAMETER.
- EXISTING VALVE BOXES AND HYDRANTS ON LINES BEING ABANDONED SHALL BE REMOVED. CONTRACTOR SHALL DISPOSE OF VALVE BOXES. HYDRANTS SHALL BE RETURNED TO MUNICIPAL SERVICE BUILDING.
- WATER MAIN INSULATION WHERE REQUIRED BY INSPECTOR OR ENGINEER, SHALL BE 4" DOW BLUEBOARD, OR APPROVED EQUAL. INSULATION SHALL BE PLACED ON TOP & SIDES OF THE MAIN PRIOR TO BACKFILL.
- WATER MAIN GRADES ARE REFERENCED TO TOP OF MAIN (T.P.) COVER SHALL BE 6" MIN. 6.5" COVER SHALL BE TYPICAL.
- CONTRACTOR SHALL COORDINATE WATER SERVICE TIE-OVER WITH APPVION. #714 HANCOCK. CONTACTS ARE ANGELA GREGORY-WERDIN, CORPORATE FACILITIES MANAGER (PH 920-851-6734) & MARK WILSON, FACILITIES MAINTENANCE TECH (PH 920-740-6819). NOTIFY AT LEAST 5 WORKING DAYS IN ADVANCE OF ANY SERVICE WORK. SERVICE INTERRUPTIONS SHALL BE FRIDAYS, AFTER 11 AM WITH ADVANCE NOTICE.
- CONTRACTOR SHALL COORDINATE WATER SERVICE TIE-OVER WITH LUVATA APPLTON #908 N. LAWE ST. AT LEAST 5 WORKING DAYS IN ADVANCE OF ANY SERVICE WORK.

**SEWER NOTES:**

- EXCAVATE & BULKHEAD EXISTING LATERAL AT MAIN PER SECTION 5.10.1 OF THE SEWER SPECIFICATIONS. PAYMENT SHALL BE 1 EA. LATERAL DISCONNECT.

**EROSION CONTROL NOTES:**

- I.P. INSTALL "D-HR" INLET PROTECTION PRIOR TO CONSTRUCTION.

*Checked/Approved Asbuilt  
12/25/16  
PJT 1-21-16  
unit w-15  
VanStraten*


**ESTIMATE OF QUANTITIES**

WATER MAIN PAY QUANTITIES	
343	L.F. - F&I 12" WATER MAIN
10	L.F. - F&I 8" WATER MAIN
40	L.F. - F&I 8" SERVICE (PAY AS 8" WATER MAIN)
25	L.F. - F&I 6" HYDRANT LEAD (PAY AS 6" HYDRANT LEAD)
5	L.F. - F&I 6" SERVICE
2	EA. - F&I HYDRANT
4	EA. - F&I 12" GATE VALVE w/BOX
2	EA. - F&I 8" GATE VALVE w/BOX
2	EA. - F&I 6" GATE VALVE w/BOX
2	EA. - F&I 8" 45° BEND
48	L.F. - F&I 1" SERVICE
6	EA. - SERVICE CONNECTION
REQ'D FITTINGS & MAT'L'S	
2	EA. - 12"x8" TEE
2	EA. - 12"x6" HYDRANT TEE
1	EA. - 8" MJ PLUG
1	EA. - 12"x8" REDUCER
1	EA. - 8"x6" REDUCER
1	EA. - 2" CORPORATION STOP
7	EA. - 1" CORPORATION STOP
7	EA. - CURB STOP
7	EA. - CURB BOX (COMPLETE)
1	EA. - 2" TYPE 'C' COUPLING
4	EA. - 1" TYPE 'C' COUPLING
2	EA. - 1"x3/4" TYPE 'C' COUPLING
SANITARY SEWER PAY QUANTITIES	
120	L.F. - F&I 4"/6" SANITARY LATERAL
10	EA. - SANITARY LATERAL CONNECTION
3	EA. - SANITARY LATERAL DISCONNECT
STORM SEWER PAY QUANTITIES	
32	L.F. - F&I 6" STORM LATERAL
7	EA. - STORM LATERAL HOOK-UP
EROSION CONTROL PAY QUANTITIES	
4	EA. - F&I 'D-HR' INLET PROTECTION




CITY OF APPLETON, WS.  
ENGINEERING DIVISION  
**SEWER & WATER**  
IN  
**HANCOCK ST**  
LAWE ST TO 150' W/O MEADE ST

DWN: LMB CKD:  
DATE: 12/29/14 APP'D:

DRG. NO. 1/4 SEC. R51 PAGE NO. 4

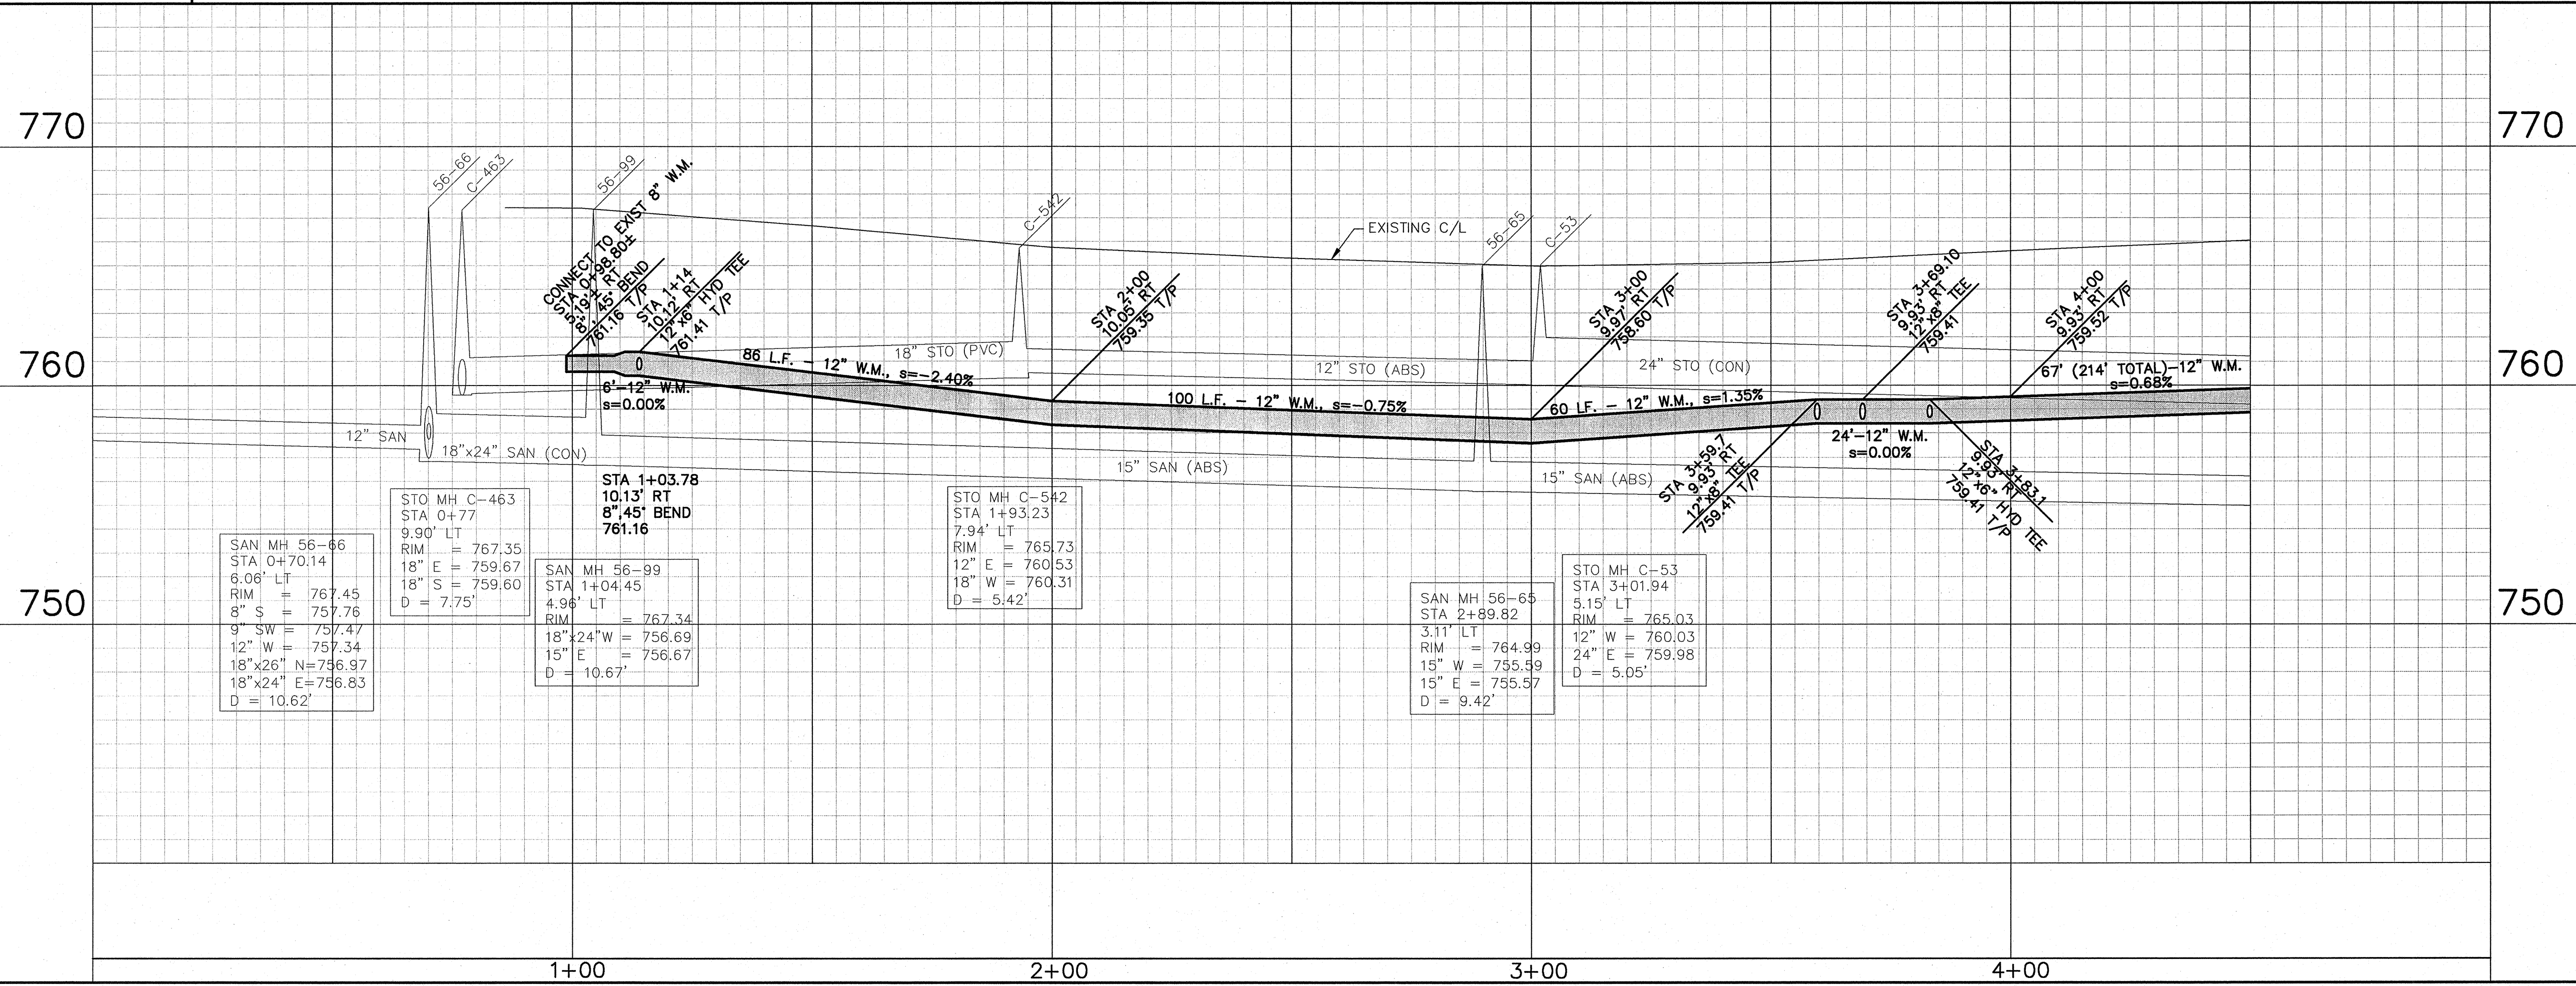

BEFORE CONSTRUCTION THE CONTRACTOR SHALL HAVE THE UTILITIES AND LATERALS LOCATED BY THE UTILITY COMPANIES.

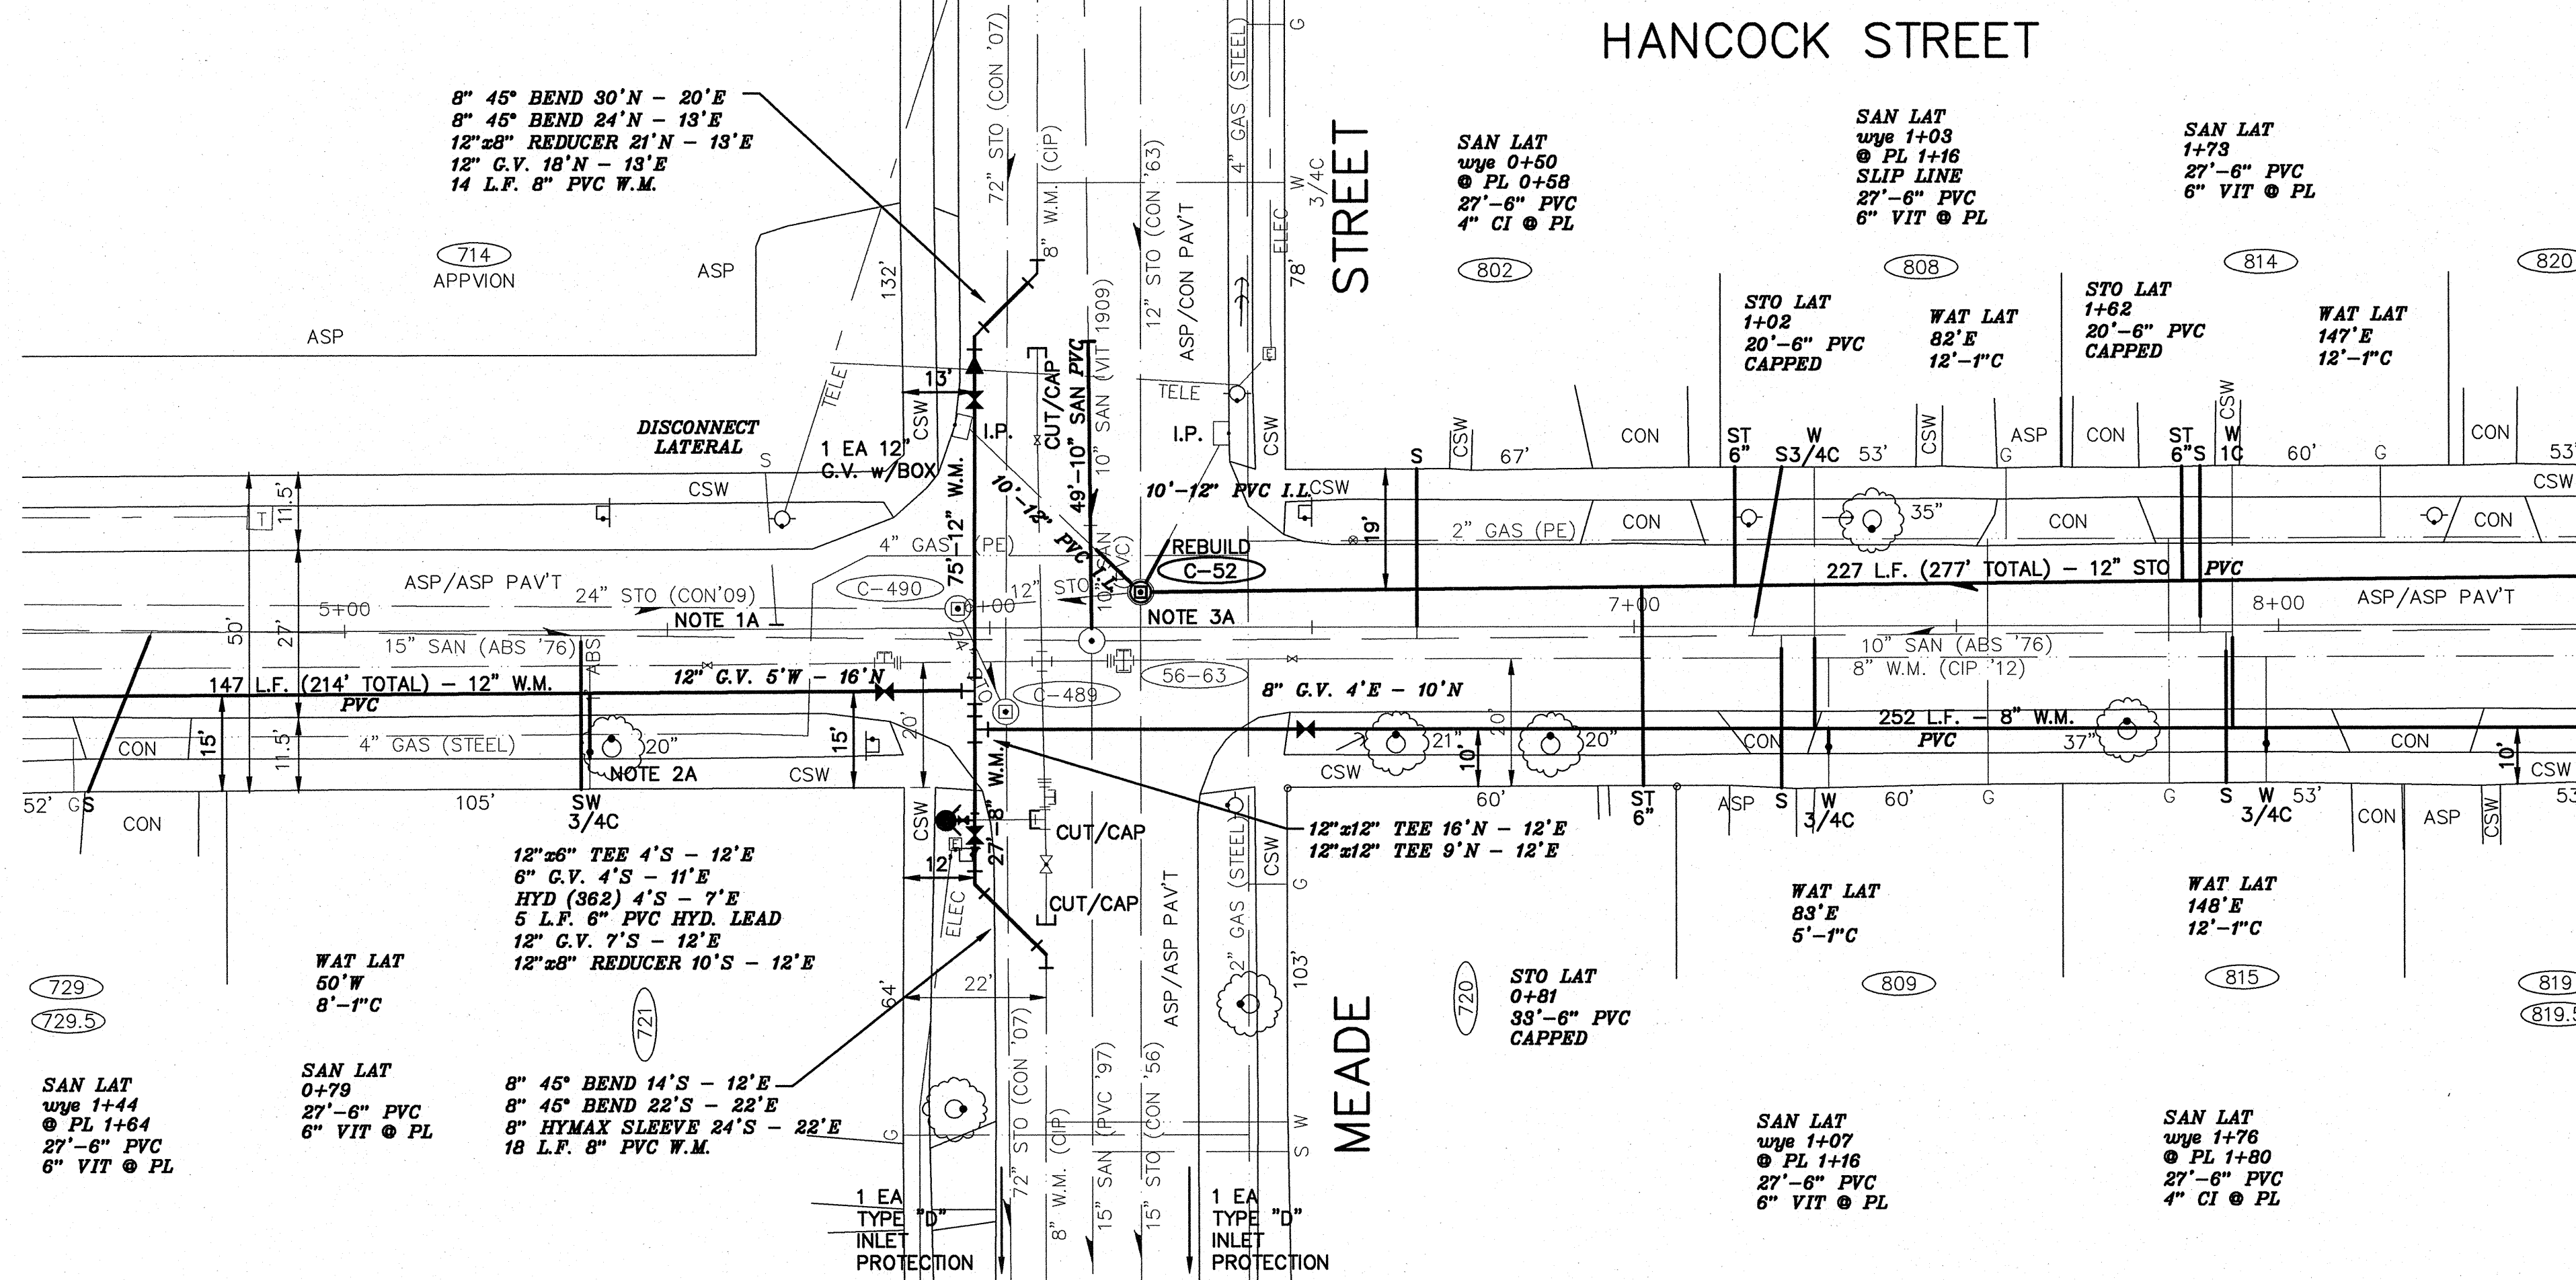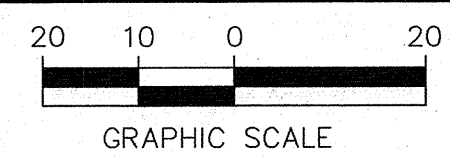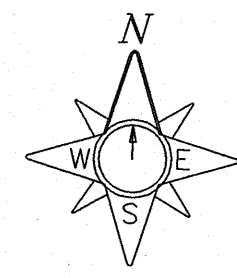

STA 1+00.00 E/L LAWE STREET

**WATER MAIN NOTES:**

- EXISTING SERVICES SHALL BE CONNECTED TO NEW MAIN WITH NEW CORPORATION STOP & PIPE COUPLING.
- PARTIAL COPPER SERVICE REPLACEMENT SHALL BE DONE WITH MATERIAL SAME AS EXISTING. COMPLETE SERVICE REPLACEMENT FROM THE NEW MAIN TO AND INCLUDING NEW CURB STOP AND CURB BOX MAY USE POLY MATERIAL OF EQUIVALENT (NOMINAL) DIAMETER.
- EXISTING VALVE BOXES AND HYDRANTS ON LINES BEING ABANDONED SHALL BE REMOVED. CONTRACTOR SHALL DISPOSE OF VALVE BOXES. HYDRANTS SHALL BE RETURNED TO MUNICIPAL SERVICE BUILDING.
- WATER MAIN INSULATION WHERE REQUIRED BY INSPECTOR OR ENGINEER, SHALL BE 4" DOW BLUEBOARD, OR APPROVED EQUAL. INSULATION SHALL BE PLACED ON TOP & SIDES OF THE MAIN PRIOR TO BACKFILL.
- WATER MAIN GRADES ARE REFERENCED TO TOP OF MAIN (T.P.) COVER SHALL BE 6" MIN. 6.5" COVER SHALL BE TYPICAL.

**SEWER NOTES:**

- EXCAVATE & BULKHEAD EXISTING LATERAL AT MAIN PER SECTION 5.10.1 OF THE SEWER SPECIFICATIONS. PAYMENT SHALL BE 1 EA. LATERAL DISCONNECT.
- CONTRACTOR SHALL NOTIFY MIKE MICHIG, CITY FORESTER (PH 920-419-6004), A MINIMUM OF 10 WORKING DAYS IN ADVANCE OF WORK TO REMOVE TREE.
- CONTRACTOR SHALL EXCAVATE & INSTALL ALL FACILITIES WITHIN THE PAVEMENT OF MEADE ST., BACKFILL WITH AGGREGATE SLURRY, AND RESTORE WITH 4" ASPHALT PAVEMENT. ALL WORK SHALL BE DONE UNDER ONE DETOUR SET-UP. ALL COSTS FOR BACKFILL, SAWCUT, AND ASPHALT SHALL BE INCLUDED IN BID UNIT PRICES OF MAIN(S).

**EROSION CONTROL NOTES:**

- I.P. INSTALL "D-HR" INLET PROTECTION PRIOR TO CONSTRUCTION.

*Asbuilt  
PJT 1-21-16  
Unit w-15  
VanStraten  
Checked/Approved  
MBC  
2/2/16*

**ESTIMATE OF QUANTITIES**

WATER MAIN PAY QUANTITIES	
222	L.F. - F&I 12" WATER MAIN
284	L.F. - F&I 8" WATER MAIN
5	L.F. - F&I 6" HYDRANT LEAD
1	EA. - F&I HYDRANT
3	EA. - F&I 12" GATE VALVE w/BOX
1	EA. - F&I 8" GATE VALVE w/BOX
1	EA. - F&I 6" GATE VALVE w/BOX
4	EA. - F&I 8", 45' BEND
49	L.F. - F&I 1" SERVICE
5	EA. - SERVICE CONNECTION
REQ'D FITTINGS & MAT'L'S	
1	EA. - 12"x12" TEE
1	EA. - 8"x8" TEE
1	EA. - 8"x6" HYDRANT TEE
2	EA. - 12"x8" REDUCER
5	EA. - 1" CORPORATION STOP
3	EA. - CURB STOP
3	EA. - CURB BOX (COMPLETE)
1	EA. - 1" TYPE 'C' COUPLING
4	EA. - 1"x3/4" TYPE 'C' COUPLING
SANITARY SEWER PAY QUANTITIES	
49	L.F. - F&I 10" SANITARY SEWER
189	L.F. - F&I 4" 6" SANITARY LATERAL
14	EA. - SANITARY LATERAL CONNECTION
1	EA. - SANITARY LATERAL DISCONNECT
STORM SEWER PAY QUANTITIES	
227	L.F. - F&I 12" STORM SEWER
20	L.F. - F&I 12" STORM INLET LEAD
73	L.F. - F&I 6" STORM LATERAL
7.95	V.F. - F&I STD. STORM MANHOLE
1	EA. - F&I STORM MANHOLE CASTING
EROSION CONTROL PAY QUANTITIES	
4	EA. - F&I 'D-HR' INLET PROTECTION

770						770	
760	147 L.F. (214' TOTAL) - 12" W.M. s = 0.68%	STO MH C-490 STA 5+95.07, 3.06' LT RIM = 767.10 24" W = 758.46 12" ENE = 758.41 24" SE = 756.96 D = 10.14'	STA 6+07± 47.40± LT 8", 45° BEND T.P. 761.00±	STA 5+97.9 37.68' LT 8", 45° BEND 760.68 T/P	202 L.F. (272' TOTAL) - 8" W.M., s=0.18%	STA 8+00 15.93' RT 761.50 T/P	760
750	227 L.F. (277' TOTAL) - 12" STO, s = 0.40%	15" SAN (ABS)	STA 5+97.6 15.84' RT 8"x8" TEE 760.68 T/P	STA 5+97.6 29.95' RT 8"x6" HYD TEE 760.68 T/P	10" SAN (ABS)	STA 5+97.5 39.97' RT 8", 45° BEND 760.68 T/P	750

CITY OF APPLETON, WIS.  
ENGINEERING DIVISION


**SEWER & WATER**  
IN  
**HANCOCK ST**

150' W/O MEADE ST TO 200' E/O MEADE ST


DWN: LMB CKD:  
DATE: 12/29/14 APP'D:

DRG. NO. 1/4 SEC. R51,S51 PAGE NO. 5

BEFORE CONSTRUCTION THE CONTRACTOR SHALL HAVE THE UTILITIES AND LATERALS LOCATED BY THE UTILITY COMPANIES.

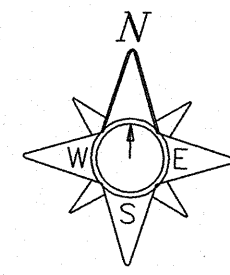

# HANCOCK ST

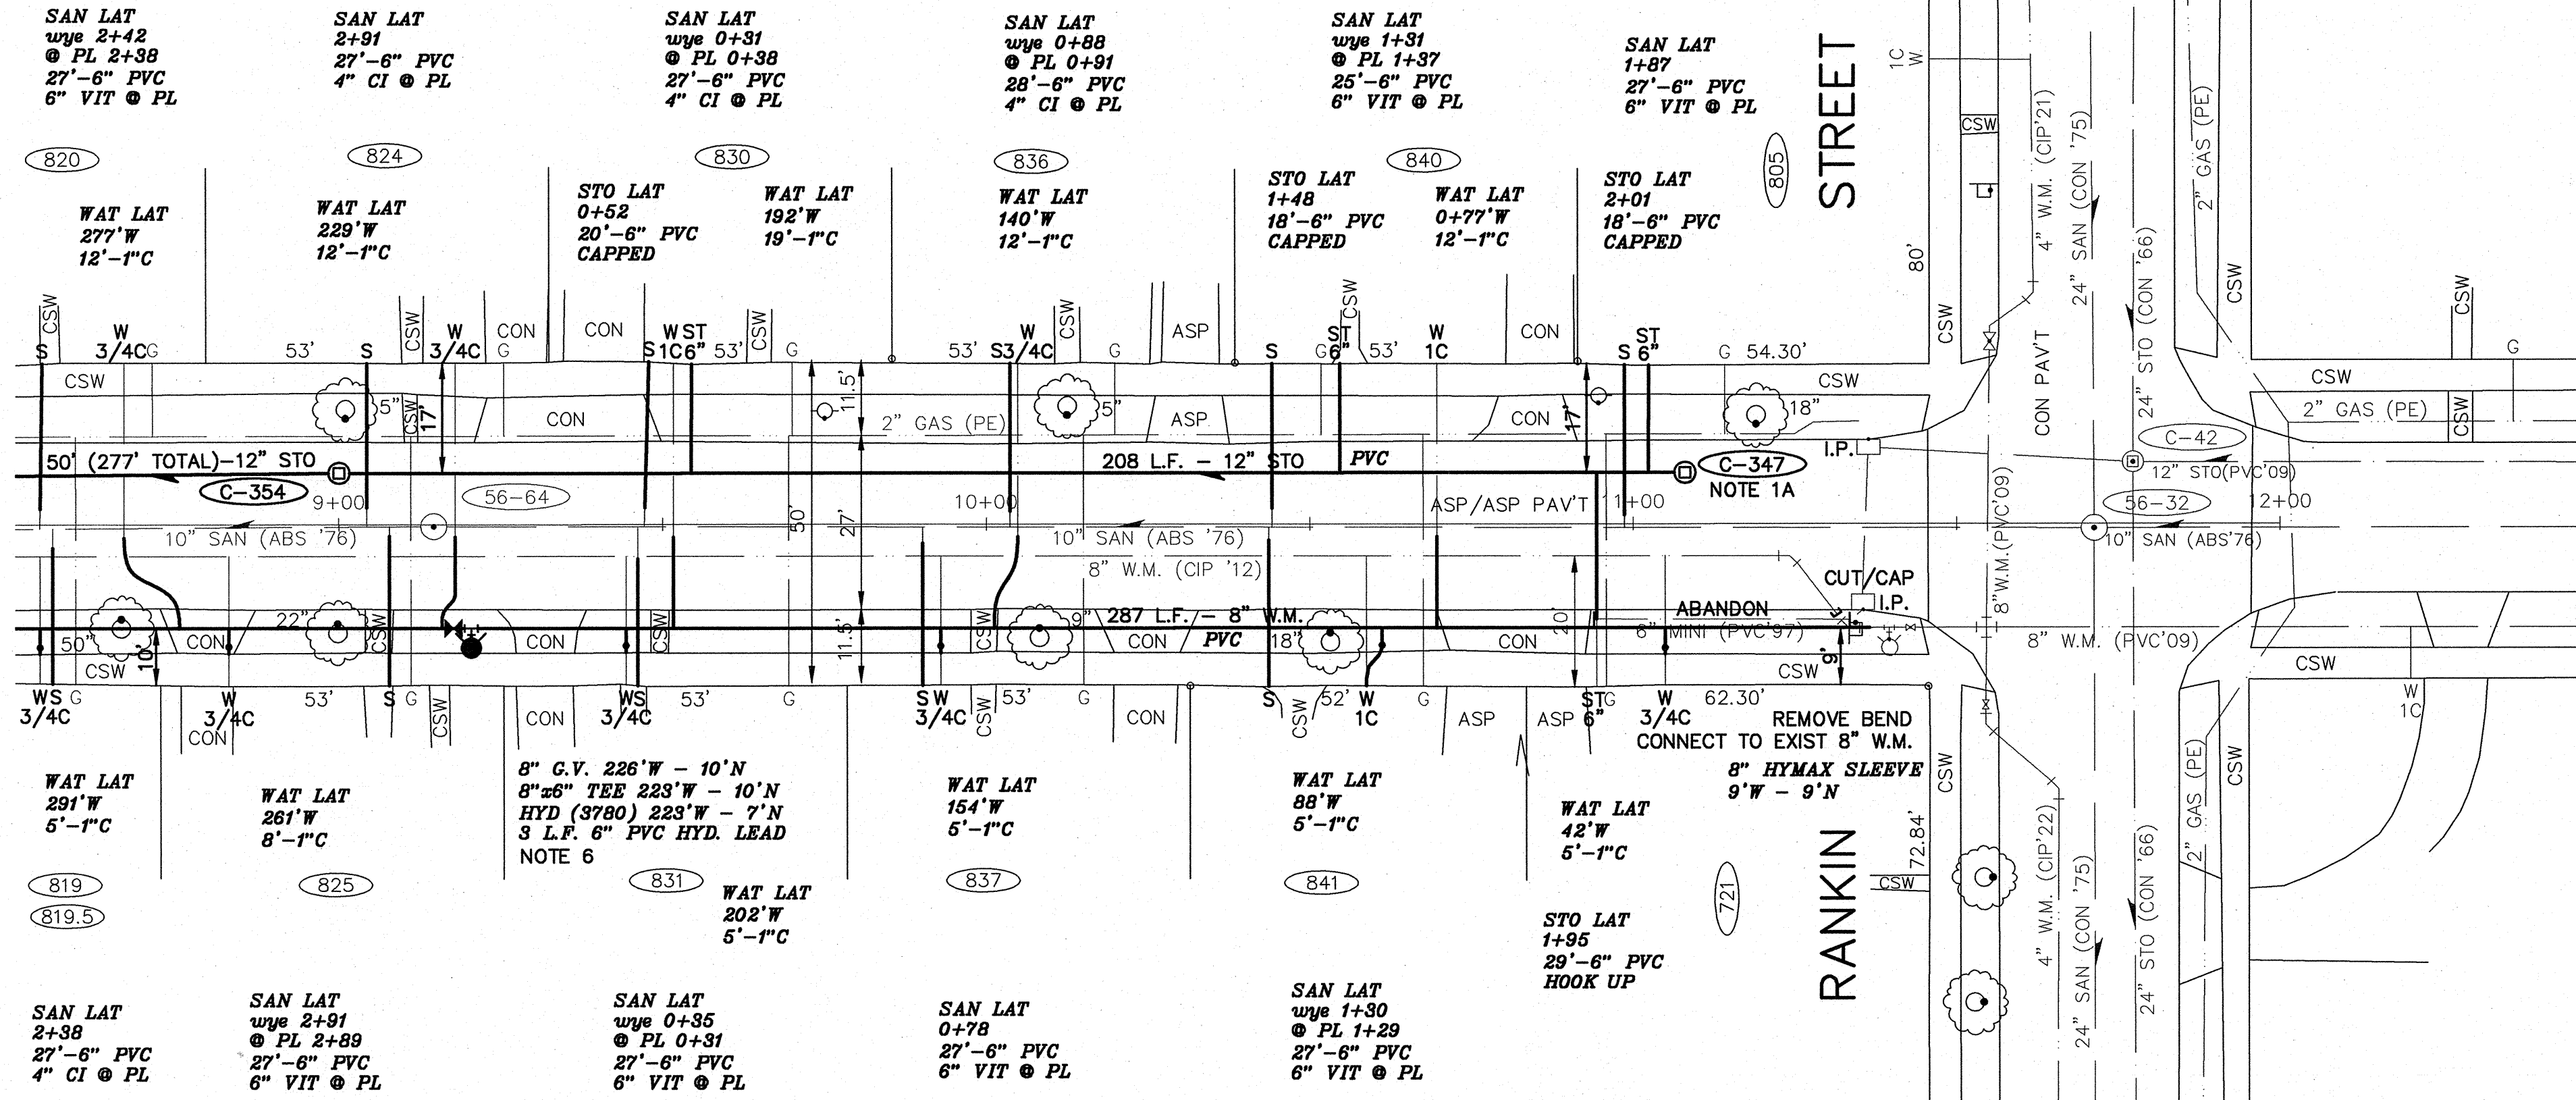

STA 1+00.00 E/L LAWE STREET

**WATER MAIN NOTES:**

- EXISTING SERVICES SHALL BE CONNECTED TO NEW MAIN WITH NEW CORPORATION STOP & PIPE COUPLING.
- PARTIAL COPPER SERVICE REPLACEMENT SHALL BE DONE WITH MATERIAL SAME AS EXISTING. COMPLETE SERVICE REPLACEMENT FROM THE NEW MAIN TO AND INCLUDING NEW CURB STOP AND CURB BOX MAY USE POLY MATERIAL OF EQUIVALENT (NOMINAL) DIAMETER.
- EXISTING VALVE BOXES AND HYDRANTS ON LINES BEING ABANDONED SHALL BE REMOVED. CONTRACTOR SHALL DISPOSE OF VALVE BOXES. HYDRANTS SHALL BE RETURNED TO MUNICIPAL SERVICE BUILDING.
- WATER MAIN INSULATION WHERE REQUIRED BY INSPECTOR OR ENGINEER, SHALL BE 4" DOW BLUEBOARD, OR APPROVED EQUAL. INSULATION SHALL BE PLACED ON TOP & SIDES OF THE MAIN PRIOR TO BACKFILL.
- WATER MAIN GRADES ARE REFERENCED TO TOP OF MAIN (T.P.) COVER SHALL BE 6" MIN. 6.5" COVER SHALL BE TYPICAL.
- A 6" AUXILIARY VALVE SHALL NOT BE INSTALLED ON THIS HYDRANT LEAD.


**SEWER NOTES:**

- NO FLAT TOPS ARE ALLOWED ON STORM MANHOLES.

**EROSION CONTROL NOTES:**


- INSTALL "D-HR" INLET PROTECTION PRIOR TO CONSTRUCTION.

*Asbuilt  
PJT 1-21-16  
Unit W-15  
VanStraten  
check/Approval  
MSR  
7/25/16*

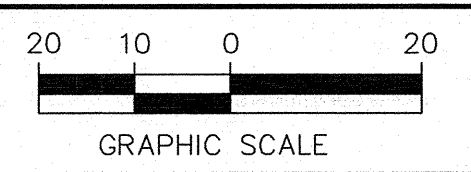

**ESTIMATE OF QUANTITIES**

WATER MAIN PAY QUANTITIES	
287	L.F. - F&I 8" WATER MAIN
3	L.F. - F&I 6" HYDRANT LEAD
1	EA. - F&I HYDRANT
1	EA. - F&I 8" GATE VALVE w/BOX
100	L.F. - F&I 1" SERVICE
11	EA. - SERVICE CONNECTION
REQ'D FITTINGS & MAT'L'S	
1	EA. - 8"x6" HYDRANT TEE
11	EA. - 1" CORPORATION STOP
6	EA. - CURB STOP
6	EA. - CURB BOX (COMPLETE)
3	EA. - 1" TYPE "C" COUPLING
8	EA. - 1"x3/4" TYPE "C" COUPLING
SANITARY SEWER PAY QUANTITIES	
296	L.F. - F&I 4"x6" SANITARY LATERAL
22	EA. - SANITARY LATERAL CONNECTION
STORM SEWER PAY QUANTITIES	
258	L.F. - F&I 12" STORM SEWER
85	L.F. - F&I 6" STORM LATERAL
1	EA. - STORM LATERAL HOOK-UP
11.85	V.F. - F&I STD. STORM MANHOLE
2	EA. - F&I STORM MANHOLE CASTING
EROSION CONTROL PAY QUANTITIES	
2	EA. - F&I "D-HR" INLET PROTECTION

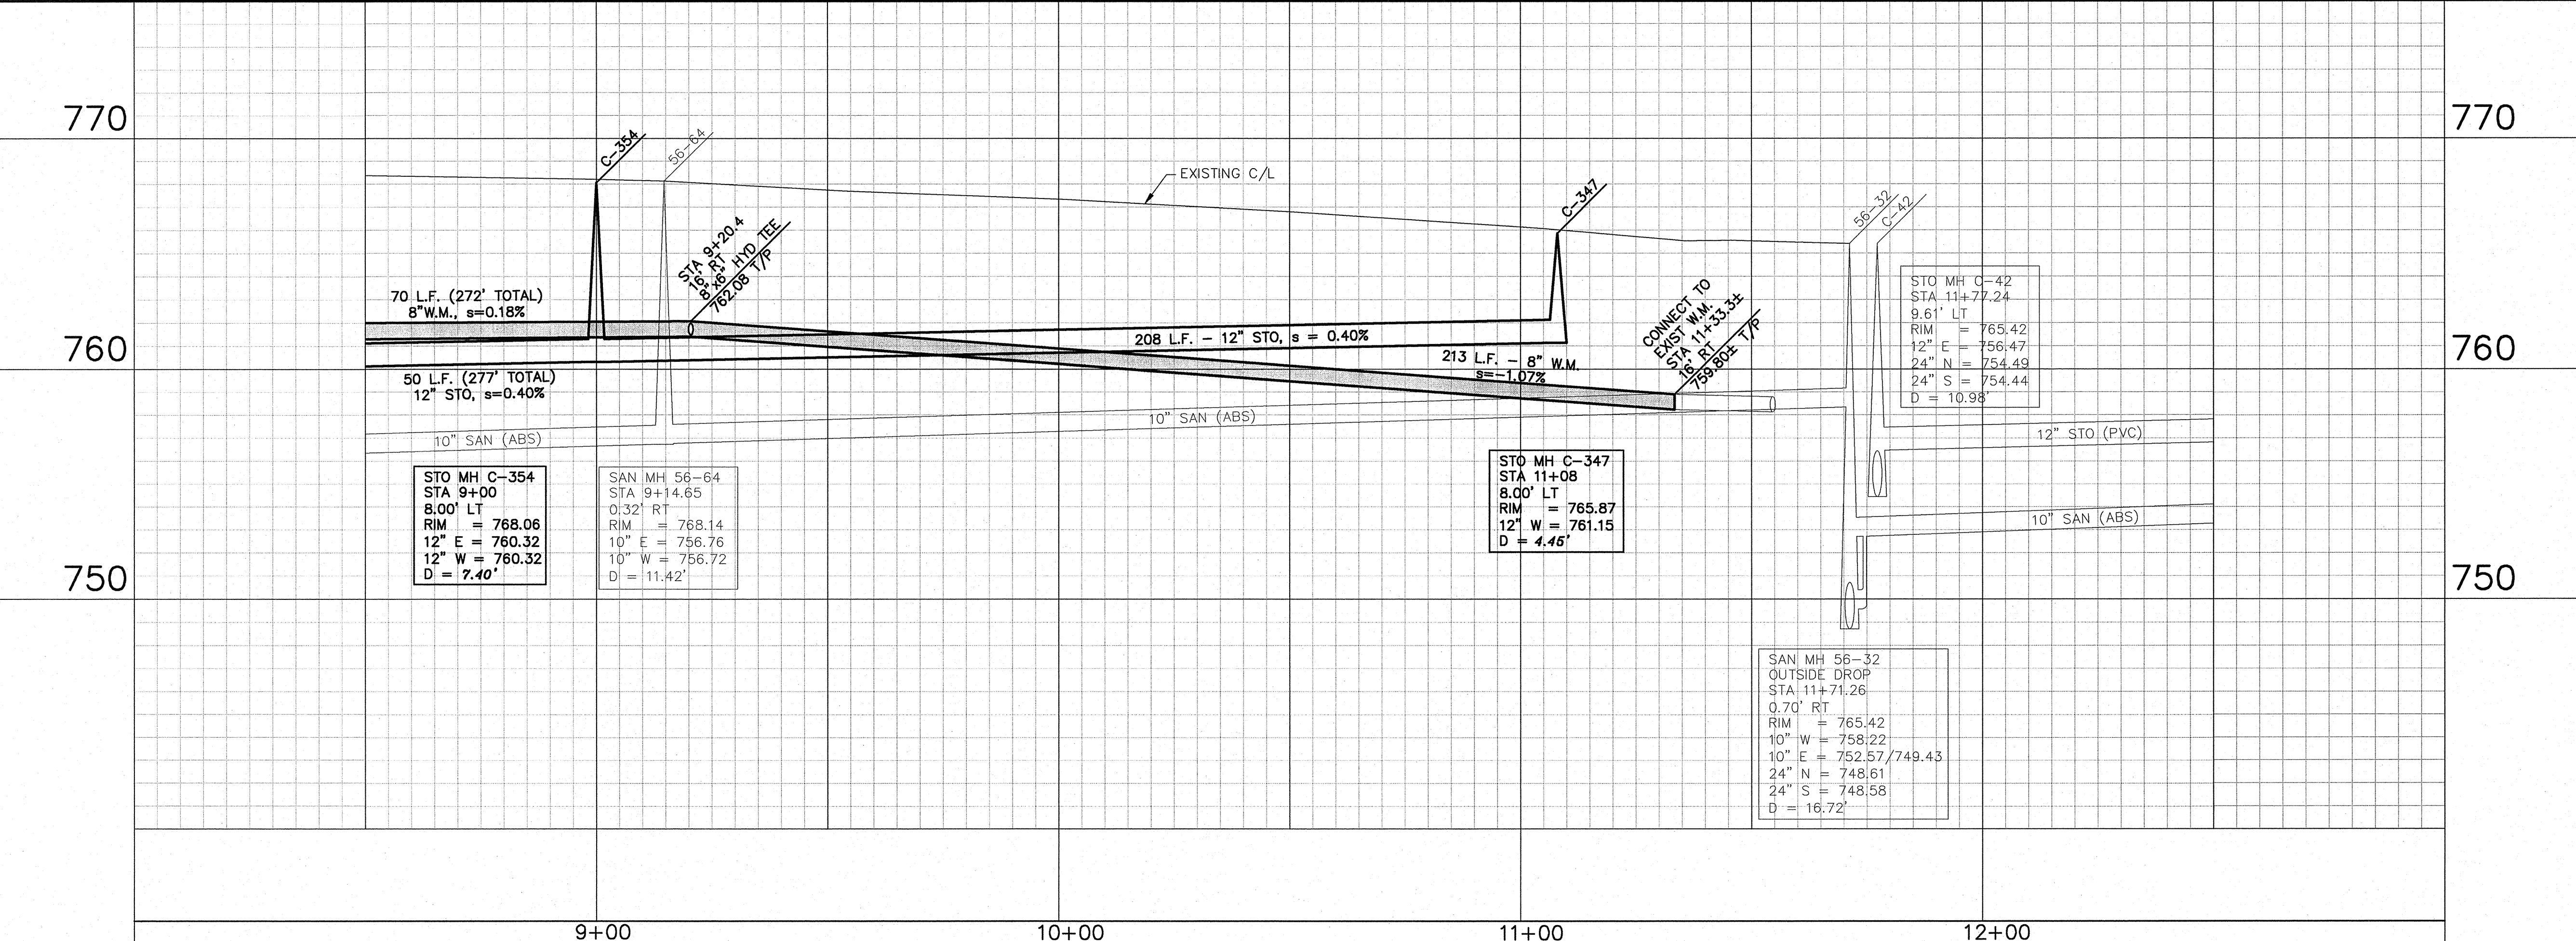

CITY OF APPLETON, WIS.  
ENGINEERING DIVISION

**SEWER & WATER**  
IN  
**HANCOCK ST**  
200' E/O MEADE ST TO RANKIN ST

DWN: LMB CKD:  
DATE: 12/29/14 APP'D:

DRG. NO. 1/4 SEC. S51 PAGE NO.