


Sheet 1 of 2

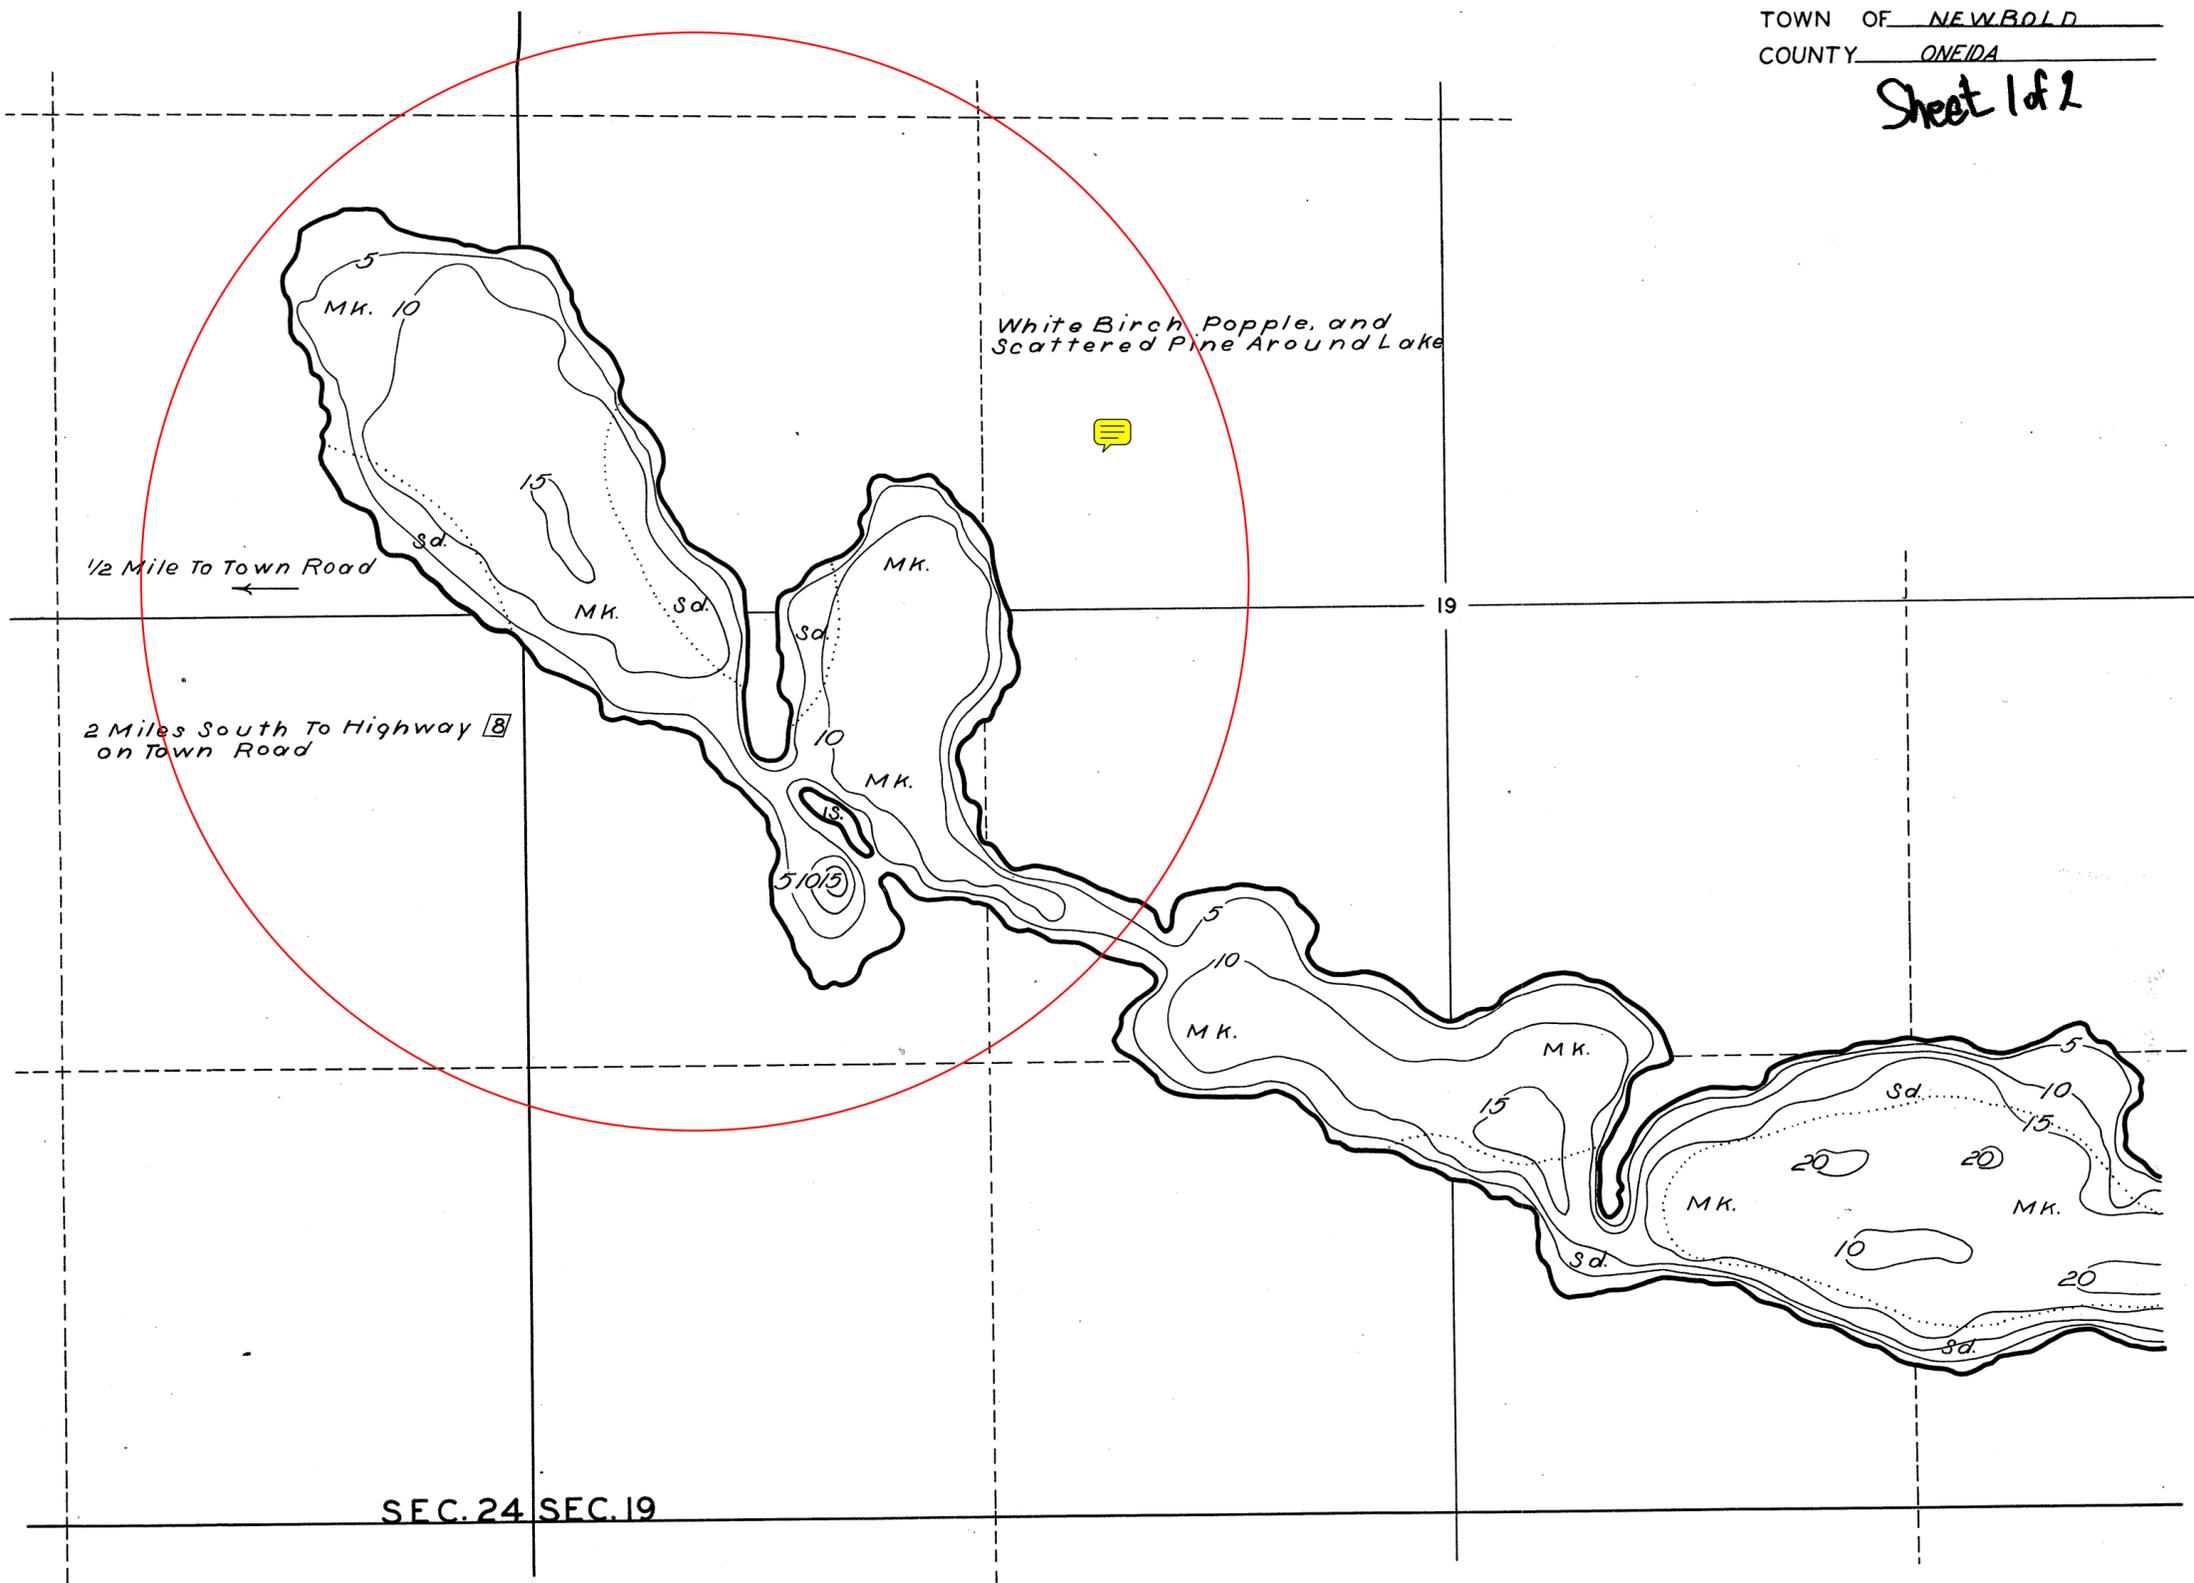

SEC. 24 SEC. 19

AREA: 238 Acres ~~238.0~~
 TOTAL SHORELINE: 6.5 Miles ~~6.6~~
 MAX. DEPTH: 4.5 Feet
 SCALE: 1" = 400'

DATE March 25, 1940
 COMPILED BY O.S.B.
 TRACED BY T.I.B. C.C.C.
 SOURCE OF INFORMATION W.R.A. Lake Improvement
Aerial Photographs:
Project F.I.M. BID 9-46; F.I.N. BID 9-7
 SOUNDINGS 12.5' Intervals
 DATES OF MAP REVISION _____
March 1940
 WORK AGENCY W.P.A.

LAKE IMPROVEMENT RECORD	
TYPE	DATE 1936-37
⊗ BRUSH REFUGES	<u>37</u>
∞ SAPLING TANGLES	<u>18.5</u>
□ SPAWNING BOXES	_____
* MINNOW SPAWNERS	<u>296</u>
TOTAL	<u>518</u>

- LEGEND
- ⊗ WEED BEDS
 - ∞ ROCKY SHOALS
 - Sd SAND
 - Cl CLAY
 - Gr GRAVEL
 - MK MUCK
 - DWELLING
 - ABANDONED DWELLING
 - ▣ RESORT

Source: Wisconsin Department of Natural Resources 608-266-2621
Clear Lake – Oneida County, Wisconsin DNR Lake Map
Date – Mar 1940 - Historical Lake Map - Not for Navigation
A Public Document - Please Identify the Source when using it.