

Date 6/26/2000

Facility Name WDOT INFORMATION CENTER

Receiving Water UNNAMED TRIBUTARY TO DES PLAINES

Evaluated by LUIS WOURYD

This stream classification is not included in the revised code because (select one):

The discharger is no longer at this location.

A new classification has resulted in a full fish and aquatic life designation.

New survey date _____ Please provide copy of new classification report.

This receiving water should be added to the database and to the code. Specify information, as it should be included in code.

Other (please explain)

THIS FACILITY NO LONGER DISCHARGES TO
THIS TRIBUTARY, WWSF BY DEFAULT

R. Johnson

Department of Natural Resources Information Center, Kenosha Co.
Des Plaines River Drainage Basin


The effluent from the Department of Natural Resources Information Center (Section 30, T1N, R22E) discharges to a tributary of the Des Plaines River. This small unnamed receiving ditch flows about a mile through agricultural land and wetlands before entering the Des Plaines River. The stream flows along a low gradient over a soft substrate.

Variable water levels and poor substrate severely limit any macroinvertebrate habitation. The stream has little recreational potential.

Recommendations

The ditch shall be classified as a non-continuous agricultural stream. The Des Plaines River shall be classified as a continuous fish and aquatic life stream.

Drop Delete

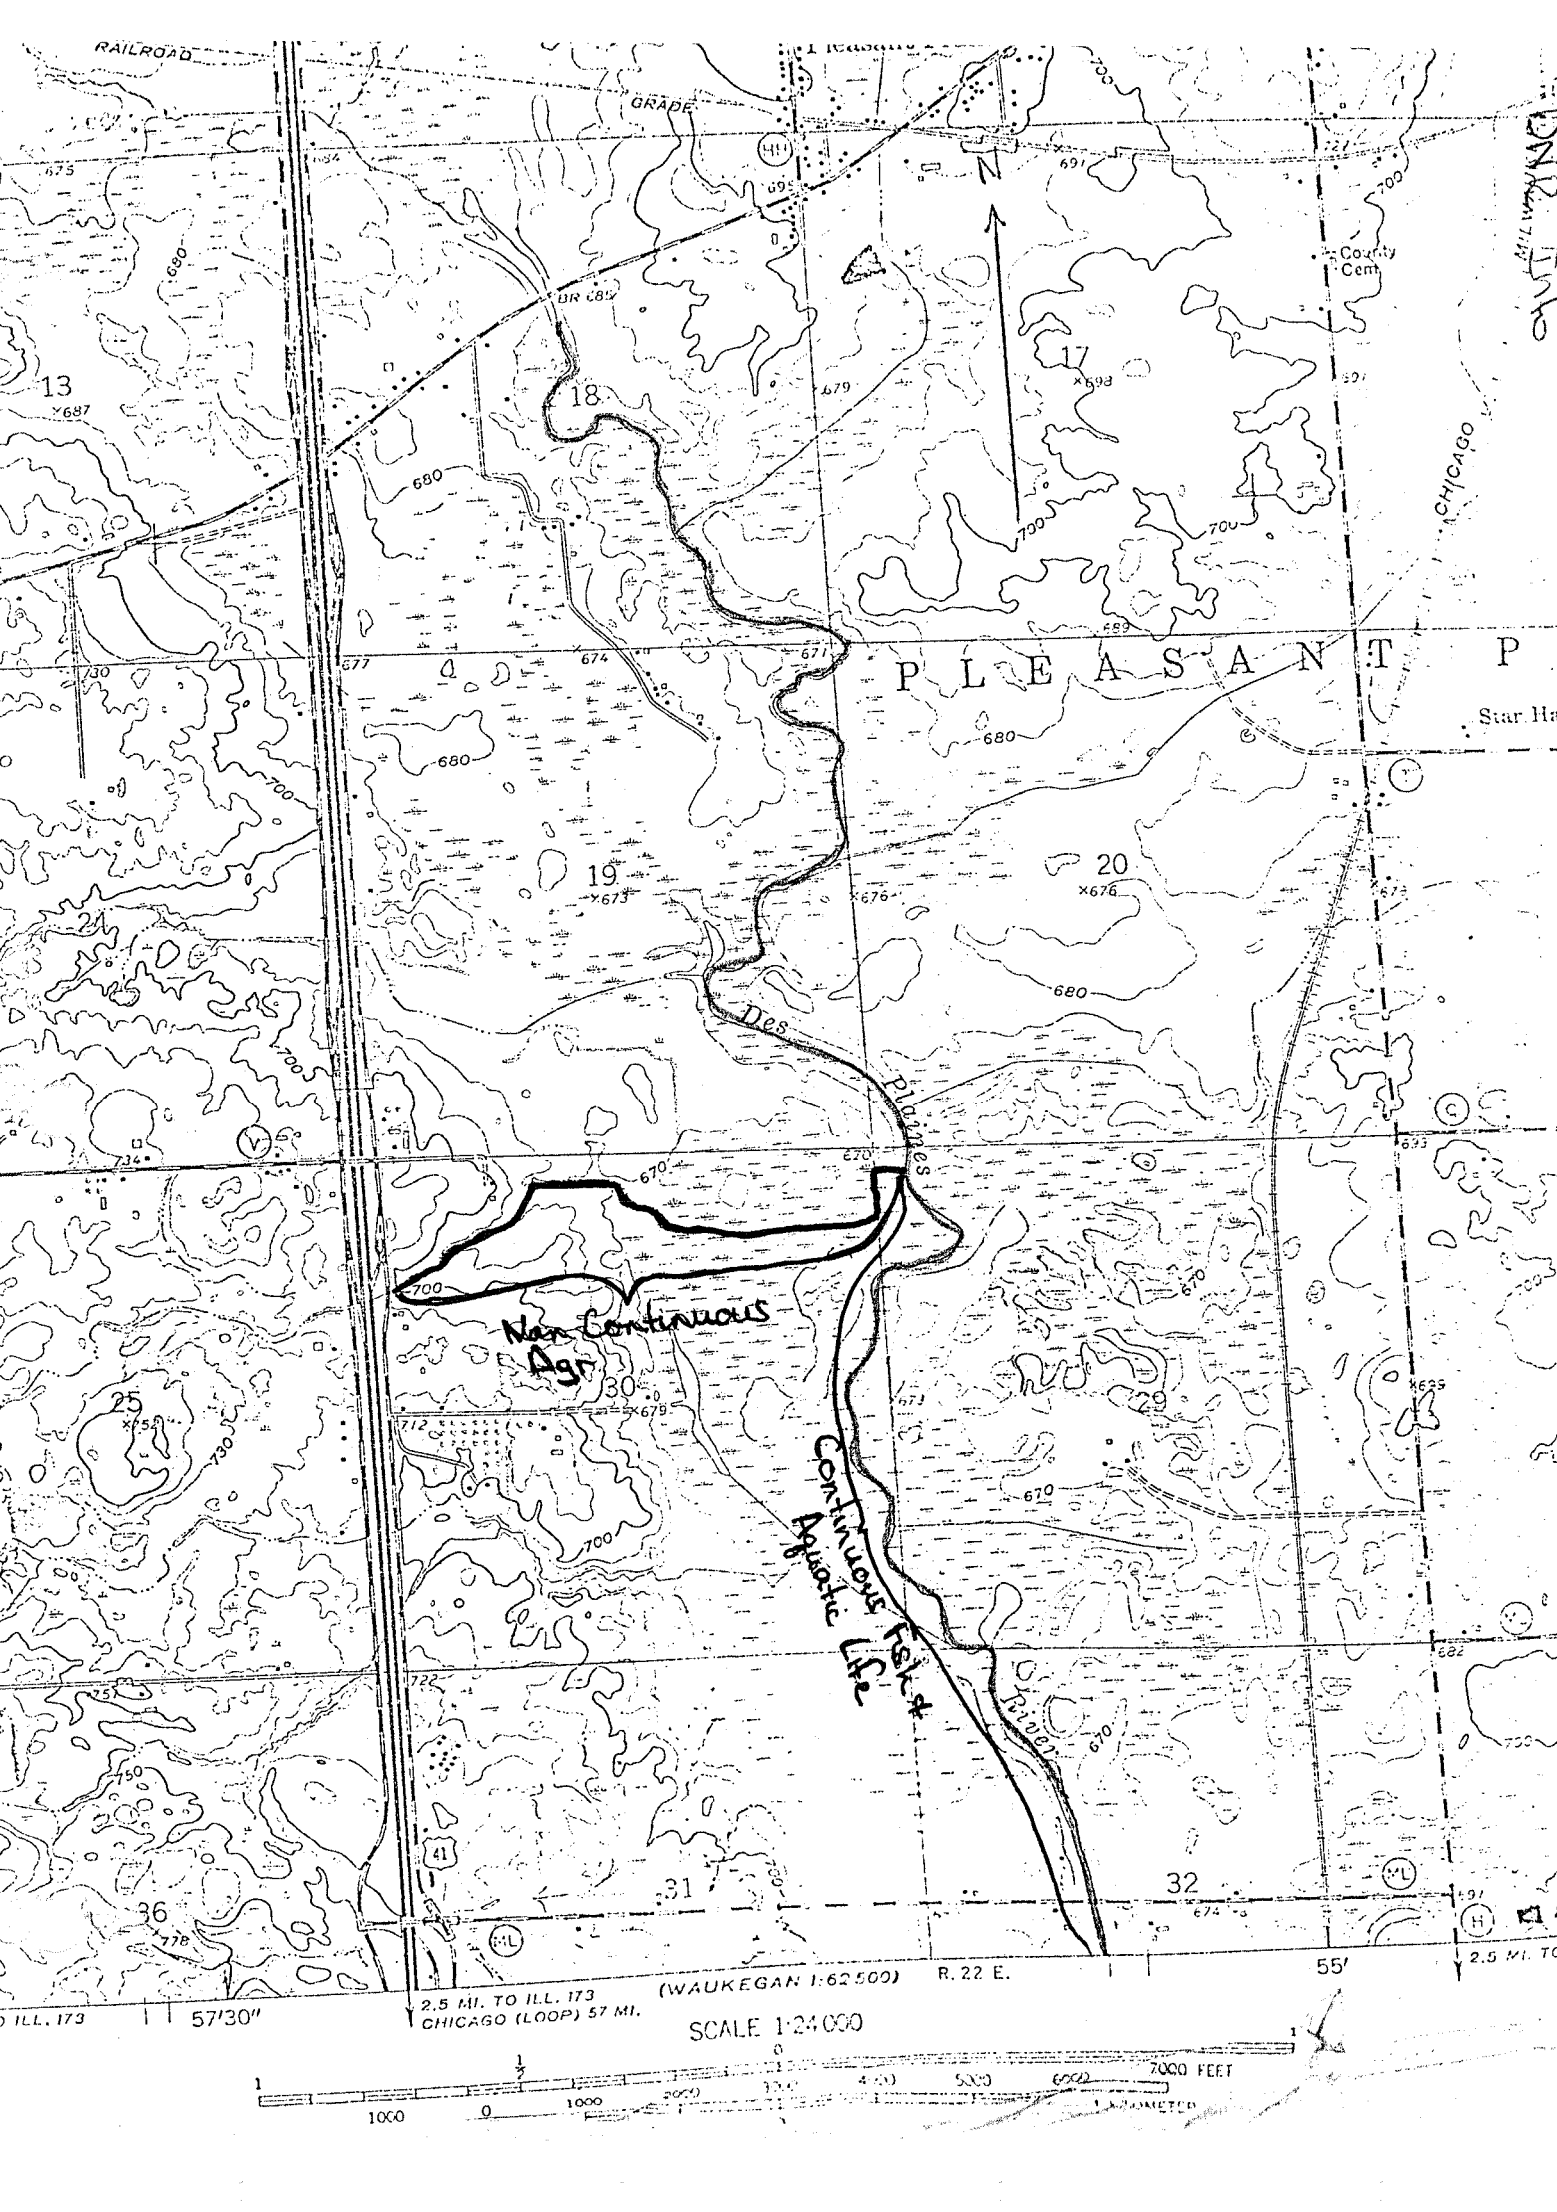

PLEASANT PLAINS

CHICAGO

Non Continuous Agr

Continuous Fish & Aquatic Life

2.5 MI. TO ILL. 173
CHICAGO (LOOP) 57 MI.


(WAUKEGAN 1:62,500)

R. 22 E.

55'

2.5 MI. TO

SCALE 1:24,000

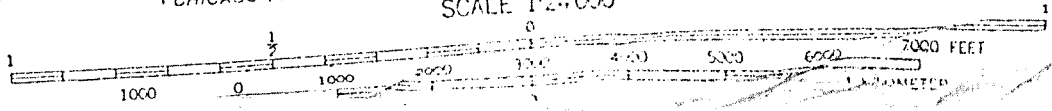

57'30"

ILL. 173