


Hill Lake

Oneida

990200

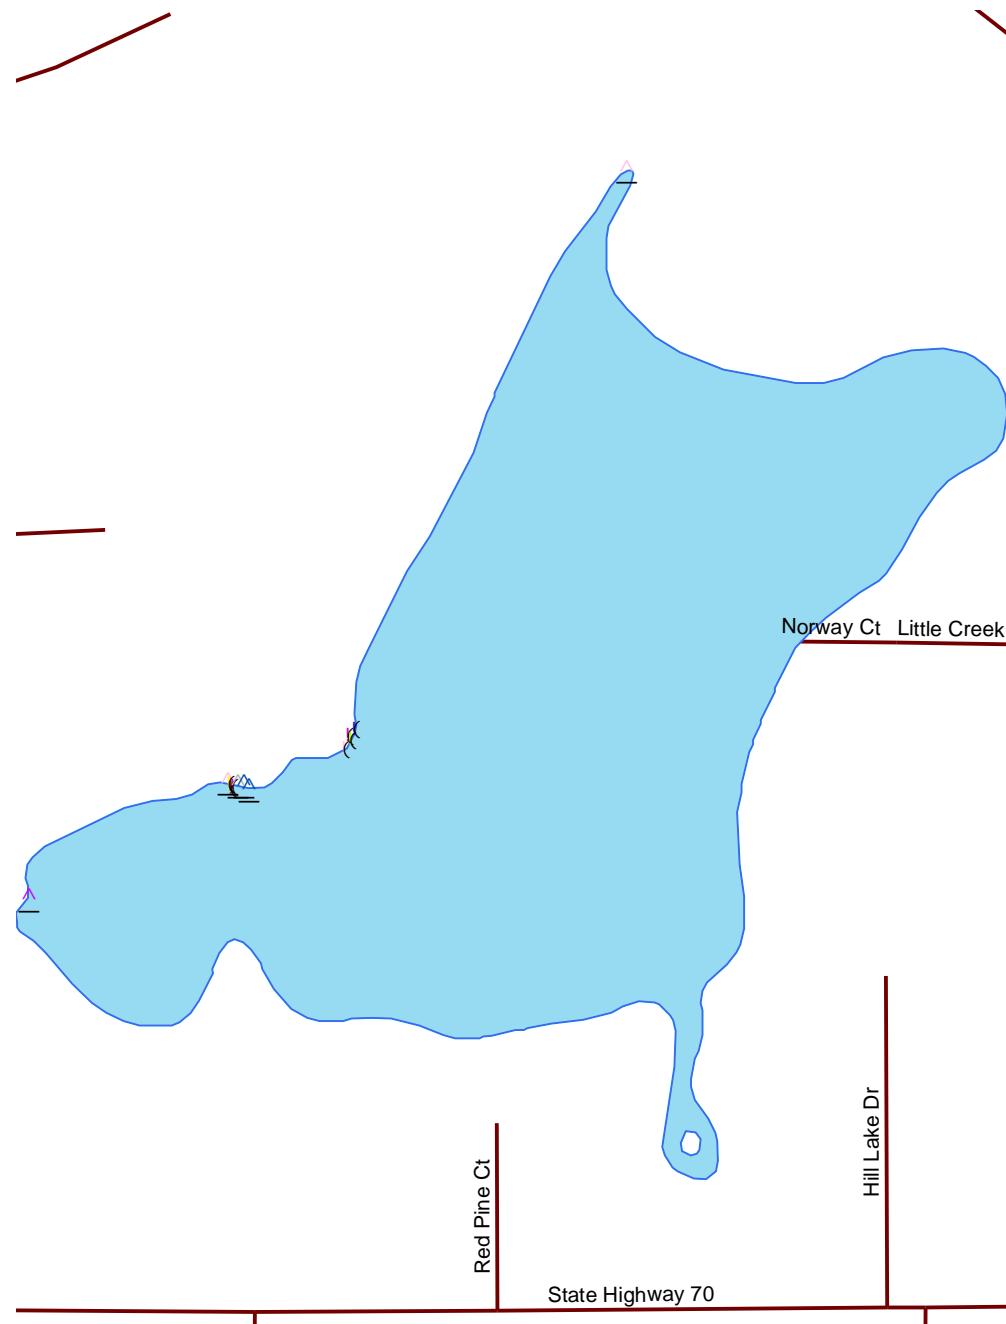

Nesting Year 1993 1994 1995 1996 1997 1998 1999 2000 2001

- | | | | | | |
|---|------|---|------|---|------|
| X | 1986 | X | 1994 | ^ | 2002 |
| X | 1987 | C | 1995 | — | 2003 |
| X | 1988 | C | 1996 | — | 2004 |
| X | 1989 | C | 1997 | — | 2005 |
| C | 1990 | C | 1998 | — | 2006 |
| C | 1991 | C | 1999 | — | 2007 |
| C | 1992 | — | 2000 | — | 2001 |

- [White square] Loon Nursery
- [Light blue square] Water
- [Blue line] Rivers & Streams
- [Red line] Roads

Loon Watch
Sigurd Olson Environmental Institute
Ashland, WI
July 1, 2008

0 0.03 0.06 Miles

