State of Wisconsin
DEPARTMENT OF NATURAL RESOURCES
Wausau Service Center
5301 Rib Mountain Drive
Wausau WI 54401

Scott Walker, Governor
Cathy Stepp, Secretary
Telephone 608-266-2621
Toll Free 1-888-936-7463
TTY Access via relay - 711

July 26, 2012

BRRTS# 02-37-000525

FILE COPY

Mr. Keith Jaeger
Wausau Scrap and Recycling
P.O. Box 329
Wausau, WI 54402-0329

Subject: Cap Modification, Wausau Steel Plant Yard, 2900 Sherman Road, Wausau, Wisconsin

Dear Mr. Jaeger:

On July 13, 2012, Mr. Tom Stolzenburg of TRC contacted me regarding a modification to your cap. The cap was required as a condition of the site closure in 2008. Certain changes to the cap are prohibited unless you have prior approval from the Department. In Mr. Stolzenburg's July 13, 2012 submittal, he was requesting approval to modify a portion of the cap located directly east of the warehouse. The change would be from crushed granite to asphalt. The contaminated materials below the cap would not be disturbed.

I concur with the proposed changes and you may proceed with the cap change. Please take "before and after" photos of the area to document the change and keep those photos in your cap inspection file. You must provide the contractor with a copy of the maintenance plan. Both you and the contractor should follow the procedures outlined on page 5 of your maintenance plan as they pertain to this project. After you complete the project, you must modify the first figure in your maintenance plan and provide a copy of the modified figure to the Department. The modified figure should also be added to your copy of the maintenance plan.

Once I receive the above information, I will add it to the GIS Registry to document the changes to your cap. You can view these changes by visiting the following web site and clicking "RR Sites Map" http://dnr.wi.gov/topic/Brownfields/clean.html.

If you have any questions, regarding this letter, please contact me at 715-359-6514.

Sincerely,

Lisa Gutknecht
Remediation & Redevelopment Program

c: Bill Evans, WDNR-Eau Claire (e-copy)
Tom Stolzenburg, TRC (e-copy)

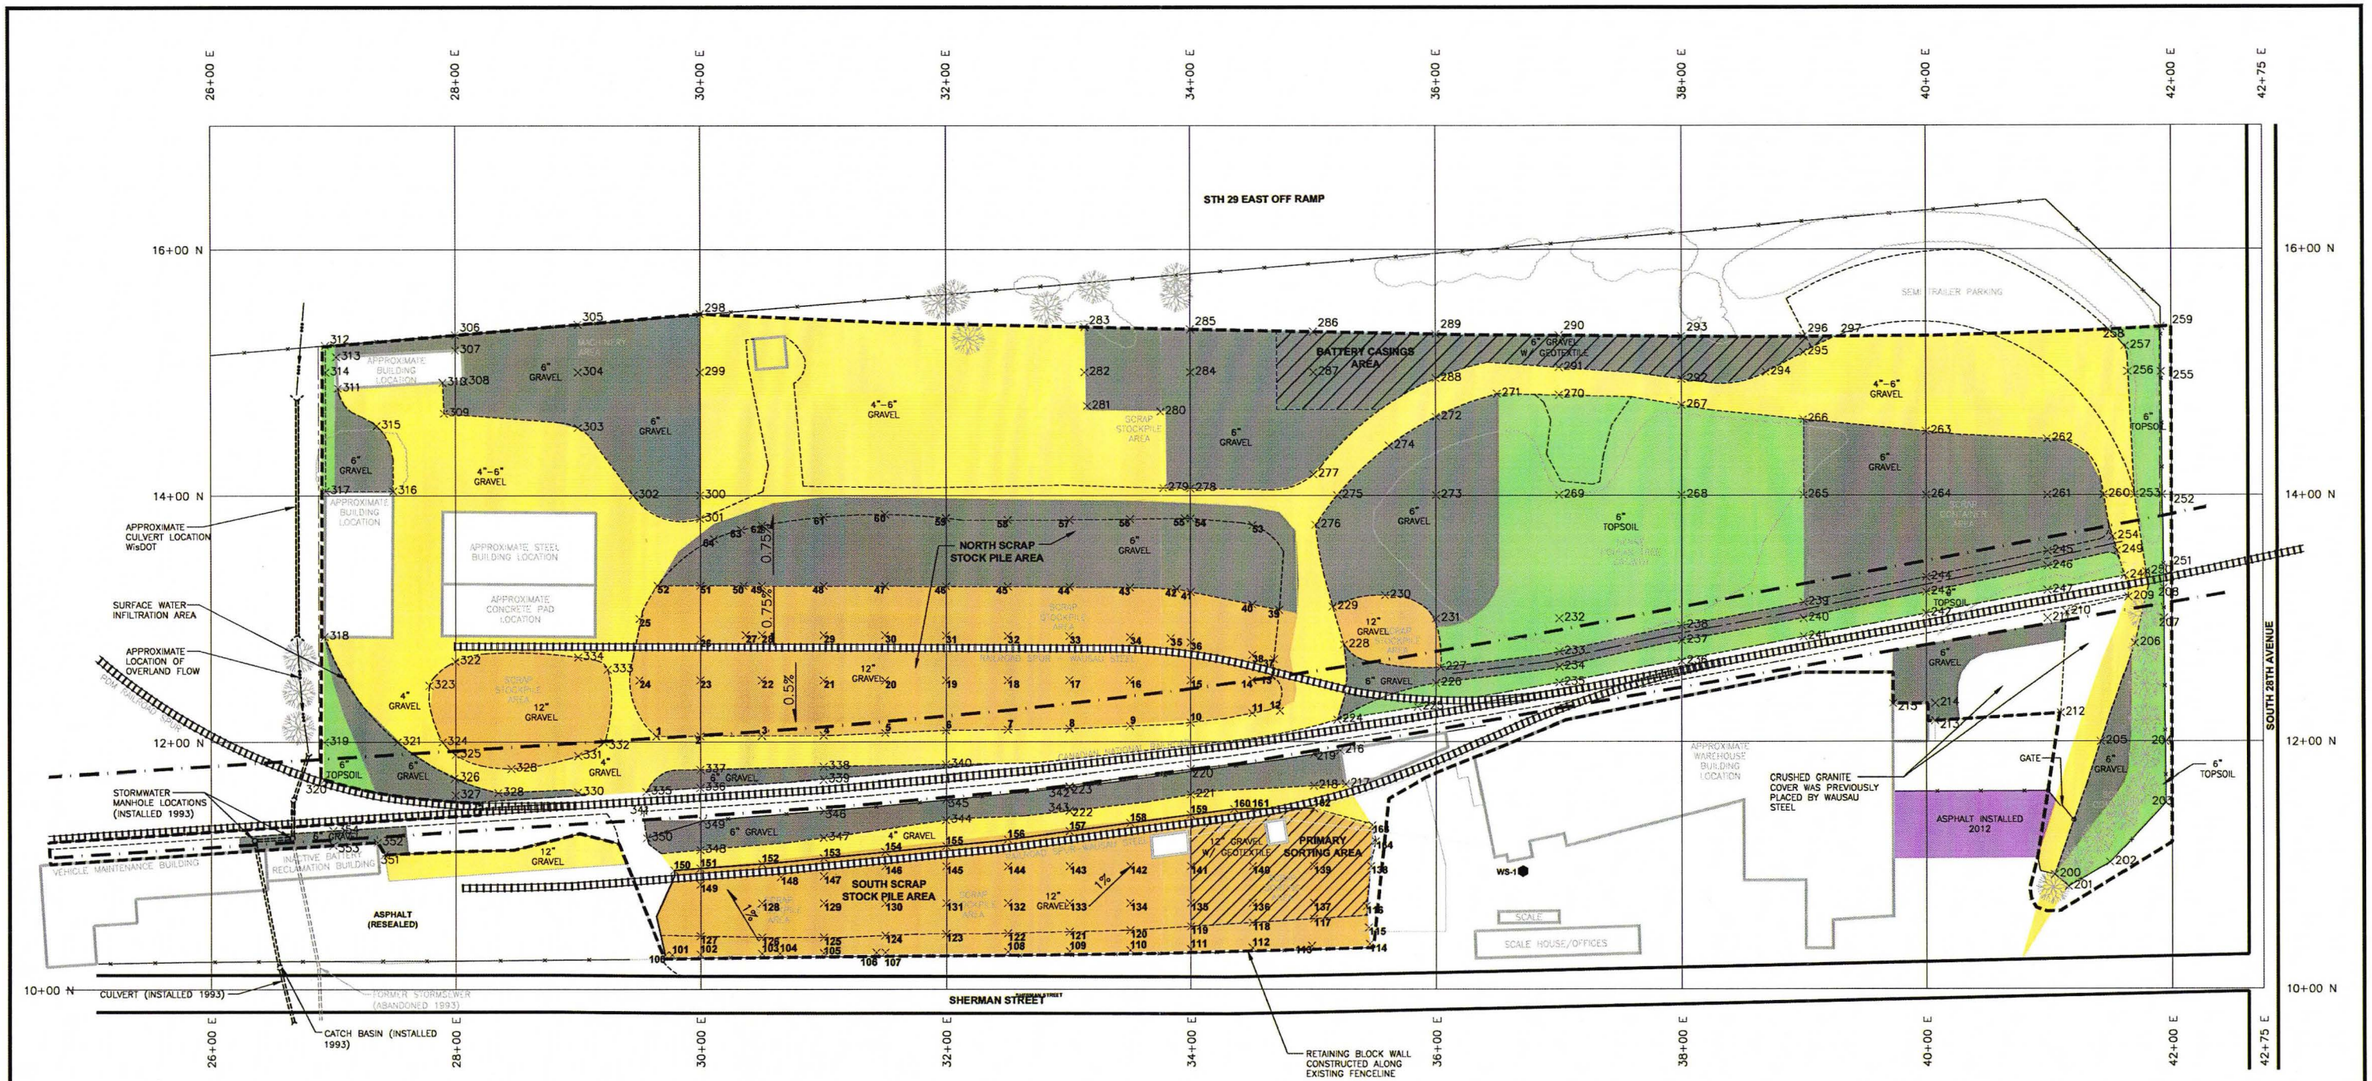

LEGEND

- APPROXIMATE RAILROAD RIGHT OF WAY
- EXISTING RAILROAD
- EXISTING FENCE
- STORMWATER CULVERT
- ROAD AREAS
- EXISTING BRUSH OR TREES
- EXISTING PINE TREE
- WS-1 — WATER SUPPLY WELL (APPROXIMATE LOCATION)
- 1% — REVISED SLOPES, CONSTRUCTED AS PART OF RAP

- AREA NOT REQUIRED TO HAVE COVER PLACED TO MEET REQUIREMENTS OF REMEDIAL ACTION PLAN (RAP), BUT HAD 4–INCHES TO 12–INCHES OF GRAVEL PLACED DURING THIS CONSTRUCTION PER WAUSAU STEEL'S REQUEST
- AREA WHERE 12–INCHES OF GRAVEL PLACED TO MEET REQUIREMENTS OF THE RAP
- AREA WHERE 6–INCHES OF GRAVEL PLACED TO MEET REQUIREMENTS OF THE RAP
- AREA WHERE GEOTEXTILE WAS PLACED UNDER THE COVER TO MEET THE REQUIREMENTS OF THE RAP
- AREA WHERE 6–INCHES OF TOPSOIL WAS PLACED TO MEET THE REQUIREMENTS OF THE RAP
- EXISTING ASPHALT THAT HAD NEW SEAL COATING APPLIED
- AREA WHERE 3–INCHES OF NEW ASPHALT WAS INSTALLED IN 2012

NOTES

1. BASE MAP PREPARED FROM GROUND SURVEY PERFORMED BY JENKINS SURVEY AND DESIGN, DATE OF SURVEY APRIL 5 AND 6, 2005. ELEVATIONS BASED ON CITY OF WAUSAU DATUM (NGVD29).
2. LOCATIONS OF FORMER AND EXISTING CULVERTS IN THE AREA NEAR THE INACTIVE BATTERY RECLAMATION BUILDING OBTAINED FROM RCI, 1994.
3. THE LOCATIONS OF CULVERTS AND DITCH LINES LOCATED TO THE NORTHWEST OF WAUSAU STEEL PROPERTY WERE OBTAINED FROM WAUSAU STEEL AND ARE APPROXIMATE.
4. THE RAILROAD RIGHT OF WAY LINES WERE LOCATED BASED ON DISCUSSIONS WITH WAUSAU STEEL.

N

0 60 120 180 240

SCALE IN FEET

NO.	BY	DATE	REVISION	APP'D.
3.				
2.				
1.				

PROJECT:

WAUSAU STEEL CORPORATION
REMEDIAL CONFIRMATION REPORT

SHEET TITLE:

AS-BUILT COVER, AS-BUILT SLOPES, AND LOCATIONS OF DOCUMENTATION POINTS

DRAWN BY:	DPR	SCALE:	PROJ. NO. 003785.0000
CHECKED BY:	—	AS SHOWN	FILE NO. cover locations.dwg
APPROVED BY:	—	DATE PRINTED:	SHEET 2 OF 3
DATE:	OCTOBER 2012		

TRC
708 Heartland Trail
Suite 3000
Madison, WI 53717
Phone: 608.826.3600

File Location: J:\Wausau Steel\003785\0000 File Name: Cover locations Layout Name: SHEET 2
Plot Information: NONE REYZEK, DONNIE — ANSI A (8.50 X 11.00 INCHES) October 8, 2012 0.3869 K:\AUTOCAD_CONFIG\PLOTTERS\PLOT STYLES\RMT COLOR.CTB